




0.215
0.69W

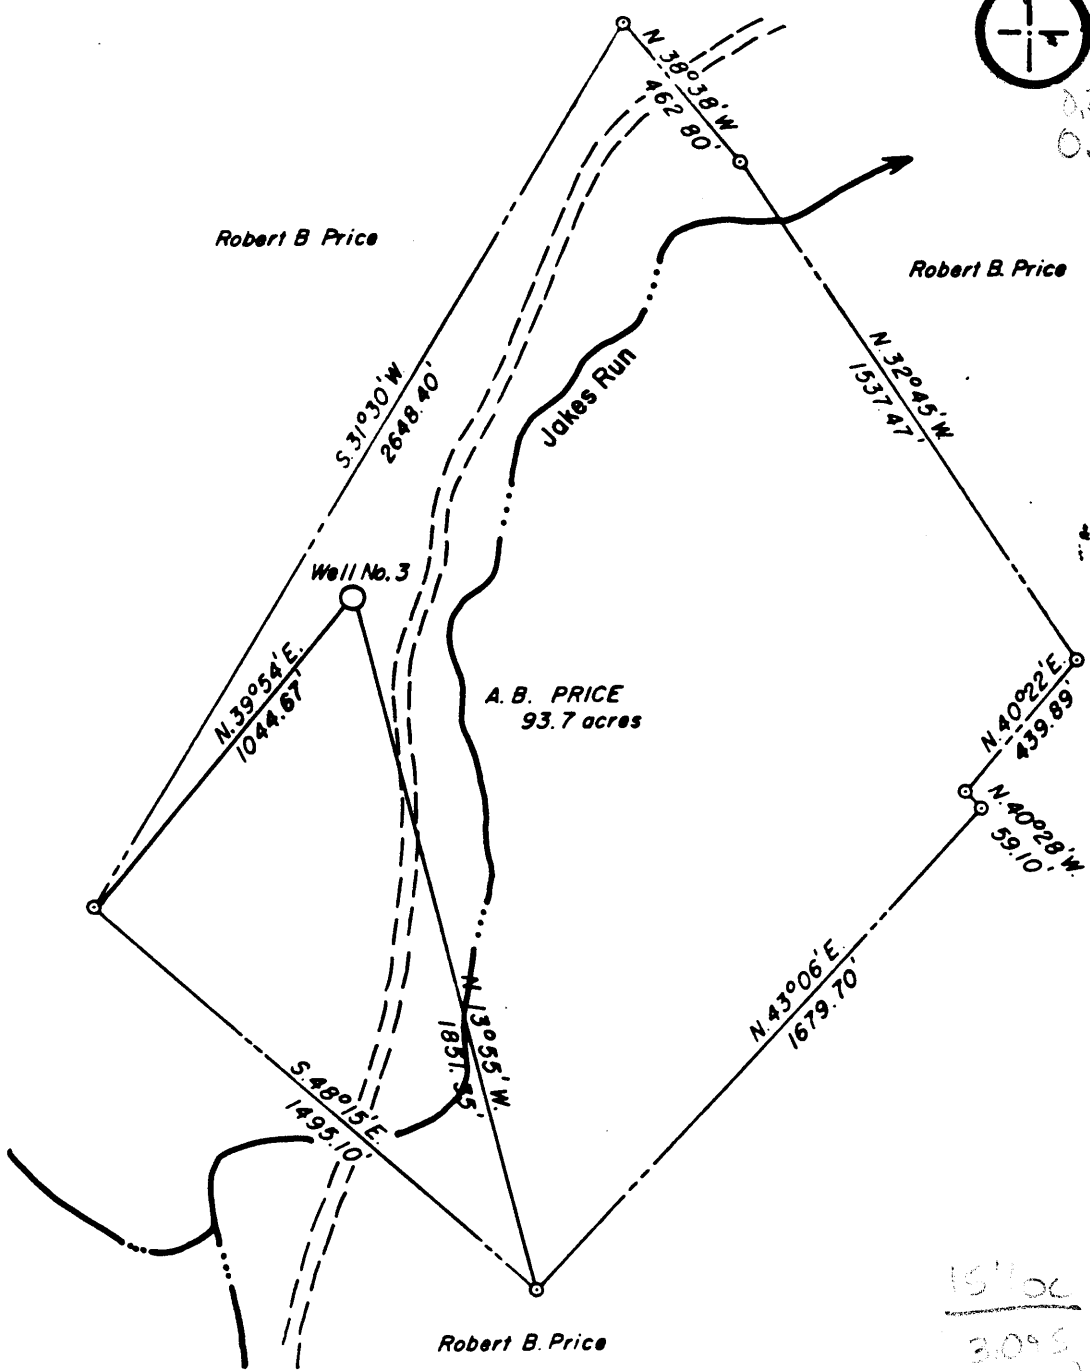

FILE NO. _____
 DRAWING NO. _____
 SCALE 1" = 500'
 MINIMUM DEGREE OF ACCURACY 1 in 5000
 PROVEN SOURCE OF ELEVATION Company survey station tied into U.S.G.S. network.

I THE UNDERSIGNED, HEREBY CERTIFY THAT THIS PLAT IS CORRECT TO THE BEST OF MY KNOWLEDGE AND BELIEF AND SHOWS ALL THE INFORMATION REQUIRED BY LAW AND THE REGULATIONS ISSUED AND PRESCRIBED BY THE DEPARTMENT OF MINES.
 (SIGNED) _____
 R.P.E. 290/ L.L.S.

PLACE SEAL HERE

(+) DENOTES LOCATION OF WELL ON UNITED STATES TOPOGRAPHIC MAPS
 FORM IV-6 (8-78)



DATE NOVEMBER 12, 19 81
 OPERATOR'S WELL NO. 3
 API WELL NO. 47 - 011 - 0641 R-P
 STATE COUNTY PERMIT

STATE OF WEST VIRGINIA
 DEPARTMENT OF MINES
 OIL AND GAS DIVISION

WELL TYPE: OIL GAS LIQUID INJECTION WASTE DISPOSAL
 (IF "GAS") PRODUCTION STORAGE DEEP SHALLOW
 LOCATION: ELEVATION 980 WATER SHED JAKES RUN
 DISTRICT CLAY COUNTY MONONGALIA
 QUADRANGLE BLACKSVILLE 7.5' & 15' NC
 SURFACE OWNER A.B. PRICE ACREAGE 93.7
 OIL & GAS ROYALTY OWNER UNKNOWN LEASE ACREAGE _____
 LEASE NO. _____
 PROPOSED WORK: DRILL CONVERT DRILL DEEPER REDRILL FRACTURE OR STIMULATE PLUG OFF OLD FORMATION PERFORATE NEW FORMATION OTHER PHYSICAL CHANGE IN WELL (SPECIFY) _____

PLUG AND ABANDON CLEAN OUT AND REPLUG
 TARGET FORMATION NONE ESTIMATED DEPTH UNKNOWN
 WELL OPERATOR CONSOLIDATION COAL COMPANY DESIGNATED AGENT GEORGE M. CONNER
 ADDRESS P.O. BOX 1314 ADDRESS P.O. BOX 1314
 MORGANTOWN, WV 26505 MORGANTOWN, WV 26505

JAN 26 1982

STATE OF WEST VIRGINIA
DEPARTMENT OF MINES
OIL AND GAS WELLS DIVISION

RECEIVED

APR 7 - 1982

AFFIDAVIT OF PLUGGING AND FILLING WELL OIL AND GAS DIVISION
DEPARTMENT OF MINES

AFFIDAVIT SHOULD BE MADE IN TRIPLICATE. ONE COPY MAILED TO THE DEPARTMENT. ONE COPY TO BE RETAINED BY THE WELL OPERATOR AND THE THIRD COPY (AND EXTRA COPIES IF REQUIRED) SHOULD BE MAILED TO EACH COAL OPERATOR AT THEIR RESPECTIVE ADDRESSES.

<u>Consolidation Coal Company</u> COAL OPERATOR OR OWNER	<u>Consolidation Coal Company</u> NAME OF WELL OPERATOR
<u>P. O. Box 1314, Morgantown, WV 26507-1314</u> ADDRESS	<u>P. O. Box 1314, Morgantown, WV 26507-1314</u> COMPLETE ADDRESS
<u>Same</u> COAL OPERATOR OR OWNER	<u>March 17 1982</u> WELL AND LOCATION
<u>A. B. Price</u> LEASE OR PROPERTY OWNER	<u>Clay</u> District
<u>Core, WV</u> ADDRESS	<u>Monongalia</u> County
	<u>Well No. #3</u>
	<u>A. B. Price</u> Farm
<u>STATE INSPECTOR SUPERVISING PLUGGING</u>	<u>William Blosser 363-9105</u>

AFFIDAVIT

STATE OF WEST VIRGINIA,
County of Monongalia } ss:

Larry Yost and David Yost
being first duly sworn according to law depose and say that they are experienced in the work of plugging and filling oil and gas wells and were employed by Consolidation Coal Company, well operator, and participated in the work of plugging and filling the above well, that said work was commenced on the 15 day of January, 1982, and that the well was plugged and filled in the following manner:

SAND OR ZONE RECORD	FILLING MATERIAL	PLUGS USED	CASING	
			CSG PULLED	CSG LEFT IN
FORMATION	Cleaned out wellbore to 1145'.	SIZE & KIND		
Ran coal protection string of casing as follows:			4 1/2" from	714' - 0'
4 1/2" casing from 714' to surface;			2 3/8" from	1131' to
2 3/8" casing from 1131' to 714';			714'.	
Latch down plug at 675';				
Flapper valve at 695'.				
Circulated cement to surface as follows:				
460 sacks Pozzmix cement from 500' to 0';				
410 sacks expanding cement from 1145' to 500'.				
Displaced 4 1/2" with water down to 675'.				
Bailed hole dry and set monument.				
COAL SEAMS			DESCRIPTION OF MONUMENT	
(NAME) Pittsburgh	564' - 572'.		5' of 4 1/2" casing above surface	
(NAME)			with plaque stating: Consol Well	
(NAME)			No. A. B. Price #3, 061-641-R-P	
(NAME)				

and that the work of plugging and filling said well was completed on the 29th day of January, 1982.

And further deponents saith not.

Sworn to and subscribed before me this 29th day of March, 1982.

My commission expires:

March 11, 1989

Larry Yost
David D. Yost
James T. Wilson
Notary Public.

Permit No. 661-641-R-P