
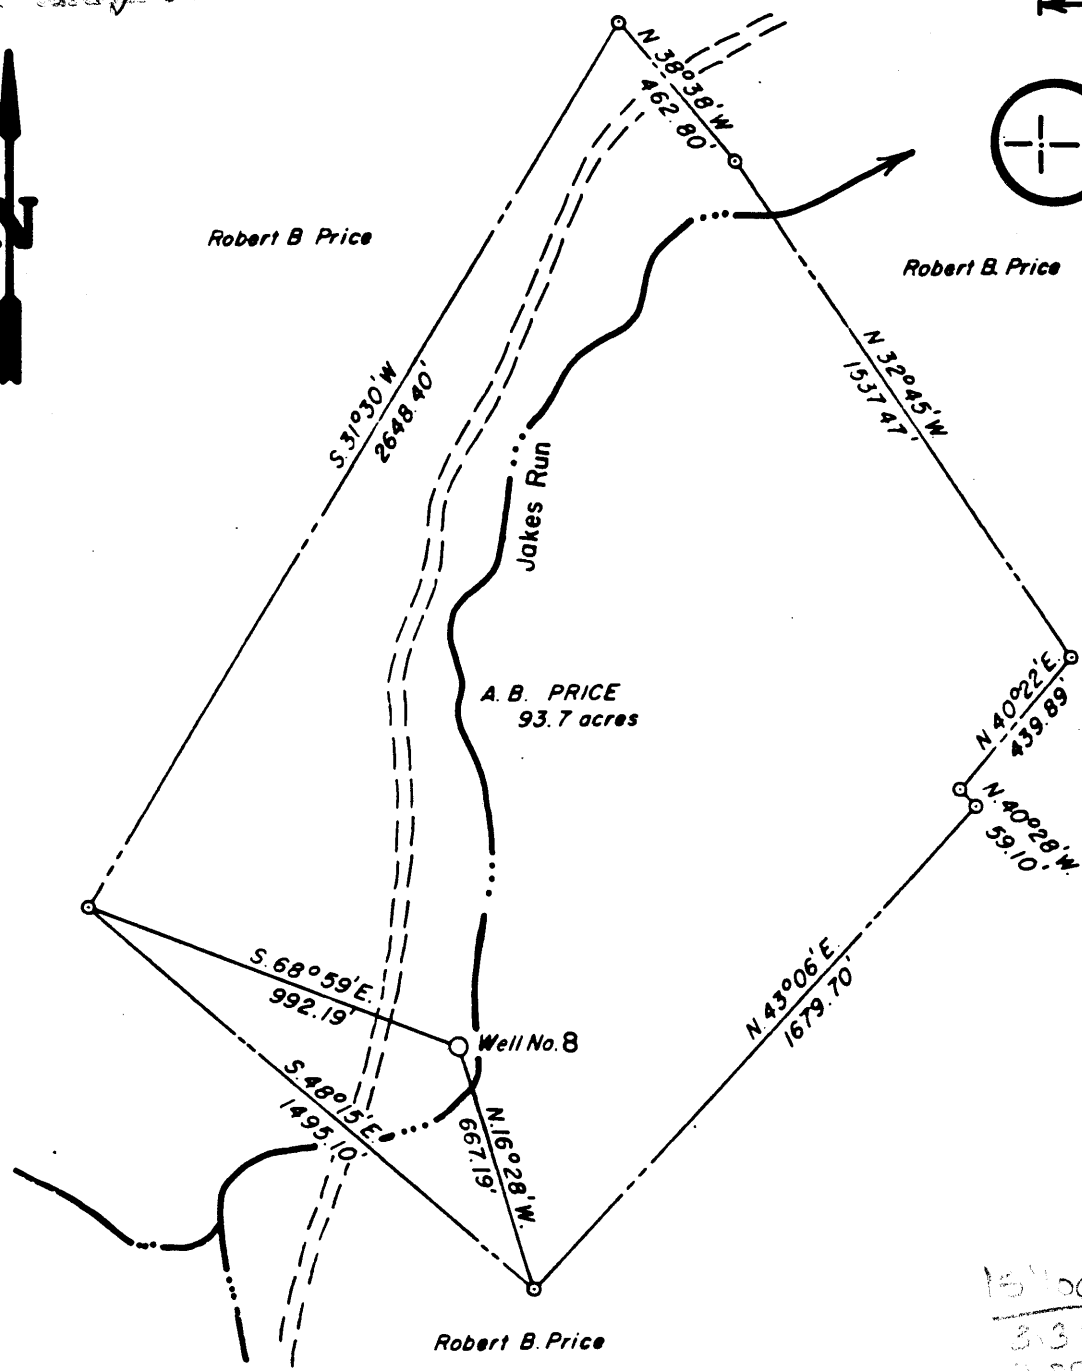


LATITUDE 39°42'30"

3500'

LONGITUDE 80°07'30"

Plot Case

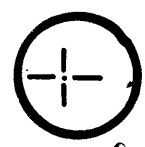

FILE NO. _____
 DRAWING NO. _____
 SCALE 1" = 500'
 MINIMUM DEGREE OF ACCURACY 1 in 5000
 PROVEN SOURCE OF ELEVATION Company survey station tied into U.S.G.S.

I THE UNDERSIGNED, HEREBY CERTIFY THAT THIS PLAT IS CORRECT TO THE BEST OF MY KNOWLEDGE AND BELIEF AND SHOWS ALL THE INFORMATION REQUIRED BY LAW AND THE REGULATIONS ISSUED AND PRESCRIBED BY THE DEPARTMENT OF MINES
 (SIGNED) _____
 R.P.E. 2804 L.L.S.

PLACE SEAL HERE

(+) DENOTES LOCATION OF WELL ON UNITED STATES TOPOGRAPHIC MAPS
 FORM IV-6 (8-78)



DATE NOVEMBER 12, 19 81
 OPERATOR'S WELL NO. 8
 API WELL NO. _____
 47 - 061 - 0644-RP
 STATE COUNTY PERMIT

STATE OF WEST VIRGINIA
 DEPARTMENT OF MINES
 OIL AND GAS DIVISION

WELL TYPE: OIL GAS LIQUID INJECTION WASTE DISPOSAL
 (IF "GAS") PRODUCTION STORAGE DEEP SHALLOW
 LOCATION: ELEVATION 930' WATER SHED JAKES RUN
 DISTRICT CLAY COUNTY MONONGALIA
 QUADRANGLE BLACKSVILLE 75' x 151' NC
 SURFACE OWNER A. B. PRICE ACREAGE 93.7
 OIL & GAS ROYALTY OWNER UNKNOWN LEASE ACREAGE _____
 LEASE NO. _____
 PROPOSED WORK: DRILL CONVERT DRILL DEEPER REDRILL FRACTURE OR STIMULATE PLUG OFF OLD FORMATION PERFORATE NEW FORMATION OTHER PHYSICAL CHANGE IN WELL (SPECIFY) _____

PLUG AND ABANDON CLEAN OUT AND REPLUG
 TARGET FORMATION NONE ESTIMATED DEPTH UNKNOWN
 WELL OPERATOR CONSOLIDATION COAL COMPANY DESIGNATED AGENT GEORGE M. CONNER
 ADDRESS P.O. BOX 1314 ADDRESS P.O. BOX 1314
 MORGANTOWN, WV 26505 MORGANTOWN, WV 26505

JUN 18 1982

OIL AND GAS DIVISION
WV DEPARTMENT OF MINES

AFFIDAVIT OF PLUGGING AND FILLING WELL

AFFIDAVIT SHOULD BE MADE IN TRIPPLICATE. ONE COPY MAILED TO THE DEPARTMENT, ONE COPY TO BE RETAINED BY THE WELL OPERATOR AND THE THIRD COPY (AND EXTRA COPIES IF REQUIRED) SHOULD BE MAILED TO EACH COAL OPERATOR AT THEIR RESPECTIVE ADDRESSES.

Consolidation Coal Company
COAL OPERATOR OR OWNER
P.O. Box 1314, Morgantown, WV
ADDRESS 26507-1314
COAL OPERATOR OR OWNER
ADDRESS
A. B. Price
LEASE OR PROPERTY OWNER
Core, WV
ADDRESS

Consolidation Coal Company
NAME OF WELL OPERATOR
P.O. Box 1314, Morgantown WV
COMPLETE ADDRESS 26507-1314
June 7 19 82
WELL AND LOCATION
Clay District
Monongalia County
Well No. A.B. Price No. 8
A. B. Price Farm

STATE INSPECTOR SUPERVISING PLUGGING William Blosser, Colfax, WV 363-9105

AFFIDAVIT

STATE OF WEST VIRGINIA,
County of Monongalia } ss:

Robert Payne and John Keesee
being first duly sworn according to law depose and say that they are experienced in the work of plugging and filling oil and gas wells and were employed by Consolidation Coal Company, well operator, and participated in the work of plugging and filling the above well, that said work was commenced on the 31st day of January, 1982, and that the well was plugged and filled in the following manner:

SAND OR ZONE RECORD FORMATION	FILLING MATERIAL	PLUGS USED SIZE & KIND	CASING	
			CSG PULLED	CSG LEFT IN
Cleaned out wellbore to 1500'. Ran coal protection string as follows: 2 7/8" tubing from 1497' to 574', and 4 1/2" casing from 574' to surface. Latch down at 545' flapper valve at 574' and 2" to 4" swedge at 574'. Circulated cement to surface as follows: Pumped 680 sacks of Pozzmix followed by 590 sacks of expanding cement. Displaced plug to 545' with water, let set, and bailed dry.		2 7/8" tubing 4 1/2" casing	1497'	574' to surface
COAL SEAMS			DESCRIPTION OF MONUMENT	
(NAME) Pittsburgh	468' to 476'		5' of 4 1/2" casing with plaque stating: Consol No. 8, 061-694-R-P	
(NAME)				
(NAME)				
(NAME)				

and that the work of plugging and filling said well was completed on the 11th day of February, 19 82.

And further deponents saith not.

Sworn to and subscribed before me this 15th day of JUNE, 19 82

My commission expires:

MARCH 10, 1992

John Keesee
Robert Payne
Donald W. Bow
Notary Public.

Permit No. _____

061-694-R-P
0644-