


M.S. Plot Card CSD
3-8-82

LATITUDE 39° 40' 00"

7,250'

15

6,710'

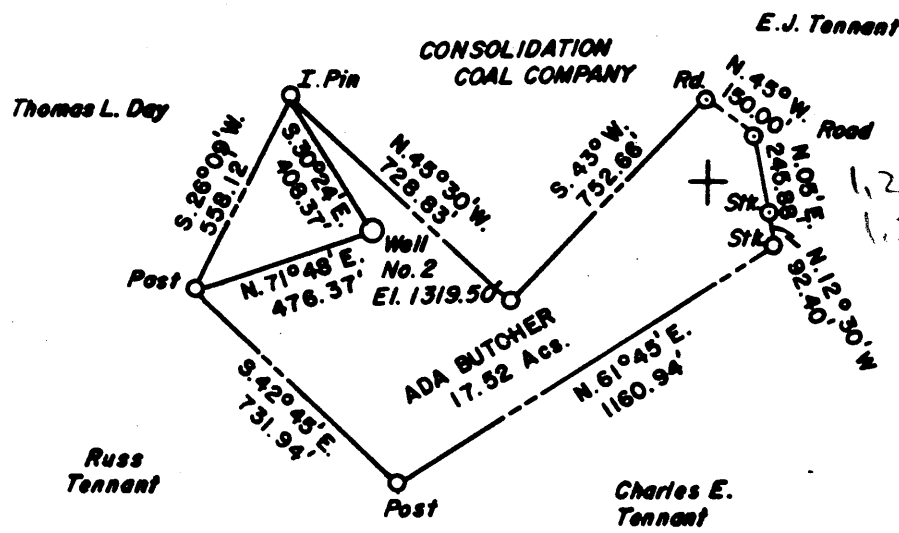

FILE NO. _____
DRAWING NO. _____
SCALE 1" = 500'
MINIMUM DEGREE OF ACCURACY 1 in 5000
PROVEN SOURCE OF ELEVATION COMPANY SURVEY TIED INTO U.S.G.S NETWORK.

I THE UNDERSIGNED, HEREBY CERTIFY THAT THIS PLAT IS CORRECT TO THE BEST OF MY KNOWLEDGE AND BELIEF AND SHOWS ALL THE INFORMATION REQUIRED BY LAW AND THE REGULATIONS ISSUED AND PRESCRIBED BY THE DEPARTMENT OF MINES.
(SIGNED) Donald D. Bourn
R.P.E. 2901 L.L.S. _____

PLACE SEAL HERE

(+) DENOTES LOCATION OF WELL ON UNITED STATES TOPOGRAPHIC MAPS
FORM IV-6 (8-78)



DATE JANUARY 29th, 19 82
OPERATOR'S WELL NO. Albert Tennant 2
API WELL NO. _____
47 - 061 - 0683-R-P
STATE COUNTY PERMIT

STATE OF WEST VIRGINIA
DEPARTMENT OF MINES
OIL AND GAS DIVISION

WELL TYPE: OIL GAS LIQUID INJECTION WASTE DISPOSAL
(IF "GAS") PRODUCTION STORAGE DEEP SHALLOW
LOCATION: ELEVATION 1319.50 WATER SHED JAKES RUN
DISTRICT CLAY COUNTY MONONGALIA COUNTY
QUADRANGLE BLACKSVILLE 15' W.C. 7.5' Series
SURFACE OWNER ADA BUTCHER ACREAGE 17.52
OIL & GAS ROYALTY OWNER _____ LEASE ACREAGE _____
LEASE NO. _____
PROPOSED WORK: DRILL CONVERT DRILL DEEPER REDRILL FRACTURE OR STIMULATE PLUG OFF OLD FORMATION PERFORATE NEW FORMATION OTHER PHYSICAL CHANGE IN WELL (SPECIFY) _____

MAR 29 1982

PLUG AND ABANDON CLEAN OUT AND REPLUG
TARGET FORMATION NONE ESTIMATED DEPTH _____
WELL OPERATOR CONSOLIDATION COAL COMPANY DESIGNATED AGENT GEORGE M. CONNER
ADDRESS P.O. BOX 1314 ADDRESS P.O. BOX 1314
 MORGANTOWN, WV 26505 MORGANTOWN, WV 26505

(Observed)

(Revised 3-81)

Farm Ada Butcher
API #47 -061 -0683-RED.
Date February 18, 1982



STATE OF WEST VIRGINIA
OFFICE OF OIL AND GAS - DEPARTMENT OF MINES

OIL AND GAS WELL PERMIT APPLICATION

WELL TYPE: Oil x / Gas ___ /

(If "Gas", Production ___ / Underground storage ___ / Deep ___ / Shallow ___)

LOCATION: Elevation: 1319.50 Watershed: Jakes Run
District: Clay County: Monongalia Quadrangle: Blacksville 7.5

WELL OPERATOR Consolidation Coal Company
Address P. O. Box 1314
Morgantown, WV 26507-1314

DESIGNATED AGENT Roger E. Duckworth
Address P. O. Box 1314
Morgantown, WV 26507-1314

OIL AND GAS ROYALTY OWNER Unknown
Address _____
Acreage _____

COAL OPERATOR Same as above
Address _____

SURFACE OWNER Ada Butcher
Address _____
Acreage 17.52

COAL OWNER(S) WITH DECLARATION ON RECORD:
NAME Same as above
Address _____
NAME _____
Address _____

FIELD SALE (IF MADE) TO:
NAME N/A
Address _____

COAL LESSEE WITH DECLARATION ON RECORD:
NAME Same as above
Address _____

OIL AND GAS INSPECTOR TO BE NOTIFIED:
NAME William Blosser
Address Colfax, WV
Telephone 363-9105

RECEIVED

MAR 05 1982

OIL AND GAS DIVISION
WV DEPARTMENT OF MINES

The undersigned well operator is entitled to operate for oil or gas purposes at the above location under a deed ___ / lease ___ / other contract x / dated ___, 19___, to the undersigned well operator from _____

(If said deed, lease, or other contract has been recorded:)

Recorded on ___, 19___, in the office of the Clerk of County Commission of _____ County, West Virginia, in _____ Book at page _____. A permit is requested as follows:

PROPOSED WORK: Drill ___ / Drill Deeper ___ / Redrill x / Fracture or stimulate Plug off old formation x / Perforate new formation ___ / Other physical change in well (specify) _____

--planned as shown on the work order on the reverse side hereof.

The above named coal operator, coal owner(s), and coal lessee are hereby notified that any objection they wish to make or are required to make by Code §22-4-3 must be filed with the Department of Mines within fifteen (15) days after receipt of this Application by the Department. Copies of this Permit Application and the enclosed plat and reclamation plan have been mailed by registered mail or delivered by hand to the above named coal operator, coal owner(s), and coal lessees on or before the day of the mailing or delivery of this Application to the Department of Mines at Charleston, West Virginia.

PLEASE SUBMIT COPIES OF ALL GEOPHYSICAL LOGS DIRECTLY TO:
WEST VIRGINIA OIL AND GAS CONSERVATION COMMISSION
1613 WASHINGTON ST., E.
CHARLESTON, WV 25311
Telephone - 304/348-3092

CONSOLIDATION COAL COMPANY
Well Operator

By: Roger E. Duckworth
Its: Project Engineer

BLANKET BOND

PROPOSED WORK ORDER

THIS IS AN ESTIMATE ONLY:
ACTUAL INFORMATION MUST BE SUBMITTED ON FORM IV-35 UPON COMPLETION

DRILLING CONTRACTOR (IF KNOWN) N/A

Address _____

GEOLOGICAL TARGET FORMATION

Estimated depth of completed well N/A feet. Rotary / Cable tools /
Approximate water strata depths: Fresh, N/A feet; salt, feet.
Approximate coal seam depths:
Is coal being mined in this area: Yes X / No /

CASING AND TUBING PROGRAM

CASING OR TUBING TYPE	SPECIFICATIONS					FOOTAGE INTERVALS		CEMENT FILL UP OR SACKS Cubic ft.	PACKERS
	Size	Grade	Weight per ft	New	Used	For Drilling	Left in Well		
Conductor									Kinds
Fresh water									
Coal									Sizes
Intermed.									
Production Tubing		SEE EXHIBIT #1							Depths set
Liners									Perforations: Top Bottom

Regulation 7.02 of the Department of Mines provides that the original and four copies of Form IV-2 must be filed with the Department, accompanied by (i) a plat in the form prescribed by Regulation 11, (ii) a bond in one of the forms prescribed by Regulation 12, or in lieu thereof the other security allowed by Code 822-4-2, (iii) Form IV-9, "Reclamation Plan" applicable to the reclamation required by Code 822-4-12b and Regulation 23, (iv) unless previously paid on the same well, the fee required by Code 822-4-12a, and (v) if applicable, the consent required by Code 822-4-8a from the owner of any water well or dwelling within 200 feet of the proposed well.

A separate Form IV-2 shall not be required for fracturing or stimulating a well where fracturing or stimulating is to be part of the work for which a permit is sought and is noted as such on the Form IV-2 filed in connection therewith.

THIS PERMIT MUST BE POSTED AT THE WELL SITE.
ALL PROVISIONS BEING IN ACCORDANCE WITH CHAPTER 22,
ARTICLE 4 OF THE W. VA. CODE, THE LOCATION IS HEREBY
APPROVED FOR redrilling. THIS PERMIT SHALL EXPIRE
IF OPERATIONS HAVE NOT COMMENCED BY 11-10-82.
BY [Signature]

The following waiver must be completed by the coal operator and by any coal owner or coal lessee who has recorded a declaration under Code 822-4-20, if the permit is to be issued within fifteen (15) days of receipt thereof:

W A I V E R

The undersigned coal operator / owner / lessee / of the coal under this well location has examined this proposed well location. If a mine map exists which covers the area of the well location, the well location has been added to the mine map. The undersigned has no objection to the work proposed to be done at this location, provided the well operator has complied with all applicable requirements of the West Virginia Code and the governing regulations.

Date: _____, 19____.

CONSOLIDATION COAL COMPANY
By: [Signature]
Its: Senior Vice President

RECEIVED

FORM OG-2

STATE OF WEST VIRGINIA
DEPARTMENT OF MINES
OIL AND GAS WELLS DIVISION

JUN 23 1982

OIL AND GAS DIVISION
WV DEPARTMENT OF MINES

AFFIDAVIT OF PLUGGING AND FILLING WELL

AFFIDAVIT SHOULD BE MADE IN TRIPLICATE. ONE COPY MAILED TO THE DEPARTMENT, ONE COPY TO BE RETAINED BY THE WELL OPERATOR AND THE THIRD COPY (AND EXTRA COPIES IF REQUIRED) SHOULD BE MAILED TO EACH COAL OPERATOR AT THEIR RESPECTIVE ADDRESSES.

Consolidation Coal Company
COAL OPERATOR OR OWNER
P.O. Box 1314, Morgantown, WV
ADDRESS 26507-1314

Consolidation Coal Company
NAME OF WELL OPERATOR
P.O. Box 1314, Morgantown, WV
COMPLETE ADDRESS 26507-1314

COAL OPERATOR OR OWNER

WELL AND LOCATION

ADDRESS
Ada Butcher
LEASE OR PROPERTY OWNER

Clay District
Monongalia County

ADDRESS

Well No. Albert Tennant No. 2
Ada Butcher Farm

STATE INSPECTOR SUPERVISING PLUGGING William Blosser, Colfax, WV 363-9105

AFFIDAVIT

STATE OF WEST VIRGINIA,
County of Monongalia } ss:

Larry Yost and David Yost
being first duly sworn according to law depose and say that they are experienced in the work of plugging and filling oil and gas wells and were employed by Consolidation Coal Company well operator, and participated in the work of plugging and filling the above well, that said work was commenced on the 15th day of April, 1982, and that the well was plugged and filled in the following manner:

SAND OR ZONE RECORD	FILLING MATERIAL	PLUGS USED	CASING	
			CSB PULLED	CSB LEFT IN
FORMATION		SIZE & KIND		
Cleaned out well bore to 1800'. Ran coal protection string as follows: 27/8" tubing from 1746' to 1036' and 4 1/2" casing from 1036' to surface. Latch down plug at 966', flapper valve at 988', and 2" to 4" swedge at 1036'. Circulated cement to surface as follows: Pumped 415 sacks of Pozzmix followed by 650 sacks of expanding type cement. Displaced plug to 966' with water let set, and bailed dry.		2 7/8" tubing 4 1/2" casing 8" casing	1746' to 1036' 1036' to surface 1640' to 795'	
COAL SEAMS		DESCRIPTION OF MONUMENT		
(NAME) Pittsburgh	809' to 817'	5' of 4 1/2" casing with plaque stating: Consol Well Albert Tennant No. 2, 47-061-0683-RED-P		
(NAME)				
(NAME)				
(NAME)				

and that the work of plugging and filling said well was completed on the 28th day of April, 1982.

And further deponents saith not.

Sworn to and subscribed before me this 17th day of June, 1982

My commission expires:
March 11, 1989

Larry Yost
David Yost
J. Arthur L. Stalder
Notary Public.

Permit No. _____