


Plot Card CSD

NORTH

LEON & NANCY WILSON

REBECCA B. MOORE
21.25 AC.

MARVIN D. TENNANT

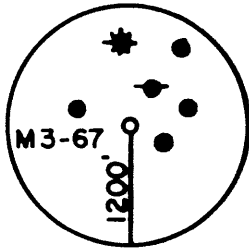

JAKES RUN

WELL M3-67

2184.80

88'029

N 71°04'6" W 548.56

N 41°25'06" W 571.15

IRON PIN

14° C. OAK

S 51° W


49.50

S 46° W 277.20

FILE NO. _____
DRAWING NO. _____
SCALE 1" = 300'
MINIMUM DEGREE OF ACCURACY 1 in 5000
PROVEN SOURCE OF ELEVATION COMPANY SURVEY TIED INTO THE U.S.G.S. NETWORK

I THE UNDERSIGNED, HEREBY CERTIFY THAT THIS PLAT IS CORRECT TO THE BEST OF MY KNOWLEDGE AND BELIEF AND SHOWS ALL THE INFORMATION REQUIRED BY LAW AND THE REGULATIONS ISSUED AND PRESCRIBED BY THE DEPARTMENT OF MINES.

(SIGNED) *R. Nelson McCoy*
R.P.E. _____ L.L.S. 110

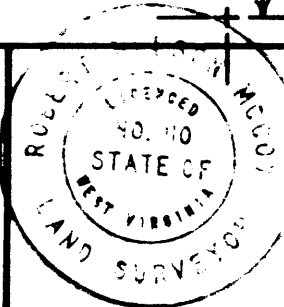

PLACE SEAL HERE

(+) DENOTES LOCATION OF WELL ON UNITED STATES TOPOGRAPHIC MAPS

FORM IV-6 (8-78)



DATE DECEMBER 28, 19 83
OPERATOR'S WELL NO. M3-67
API WELL NO. 47 - 061 - 0744-P
STATE COUNTY PERMIT

STATE OF WEST VIRGINIA
DEPARTMENT OF MINES
OIL AND GAS DIVISION

WELL TYPE OIL ___ GAS ___ LIQUID INJECTION ___ WASTE DISPOSAL ___ ABANDONED X
(IF "GAS") PRODUCTION ___ STORAGE ___ DEEP ___ SHALLOW X

LOCATION: ELEVATION 1042.90 WATER SHED JAKES RUN
DISTRICT CLAY COUNTY MONONGALIA
QUADRANGLE BLACKSVILLE W.V. PA. 7.5

SURFACE OWNER REBECCA B. MOORE ACREAGE 21.25
OIL & GAS ROYALTY OWNER UNKNOWN LEASE ACREAGE _____
LEASE NO. _____

PROPOSED WORK: DRILL ___ CONVERT ___ DRILL DEEPER ___ REDRILL X FRACTURE OR STIMULATE ___ PLUG OFF OLD FORMATION ___ PERFORATE NEW FORMATION ___ OTHER PHYSICAL CHANGE IN WELL (SPECIFY) _____

FEB 21 1984

PLUG AND ABANDON ___ CLEAN OUT AND REPLUG X
TARGET FORMATION NONE ESTIMATED DEPTH _____
WELL OPERATOR CONSOLIDATION COAL COMPANY DESIGNATED AGENT ROGER E. DUCKWORTH
ADDRESS PO BOX 1314 MORGANTOWN, WV 26505 ADDRESS PO BOX 1314 MORGANTOWN, WV 26505

AFFIDAVIT OF PLUGGING AND FILLING WELL

AFFIDAVIT SHOULD BE MADE IN TRIPPLICATE. ONE COPY MAILED TO THE DEPARTMENT, ONE COPY TO BE RETAINED BY THE WELL OPERATOR AND THE THIRD COPY (AND EXTRA COPIES IF REQUIRED) SHOULD BE MAILED TO EACH COAL OPERATOR AT THEIR RESPECTIVE ADDRESSES.

Consolidation Coal Company

 COAL OPERATOR OR OWNER
 P. O. Box 1314, Morgantown, WV 26505

 ADDRESS

 COAL OPERATOR OR OWNER

 ADDRESS
 Rebecca B. Moore

 LEASE OR PROPERTY OWNER
 Mooresville, WV

 ADDRESS

Consolidation Coal Company

 NAME OF WELL OPERATOR
 P. O. Box 1314, Morgantown, WV 26505

 COMPLETE ADDRESS
 March 7, 1984

 WELL AND LOCATION
 Clay District
 Monongalia County
 Well No. M3-67
 Rebecca B. Moore

 Farm
 Don Ellis

STATE INSPECTOR SUPERVISING PLUGGING

AFFIDAVIT

STATE OF WEST VIRGINIA,

County of Monongalia }
 Larry Yost

RECEIVED
 MAR 9 - 1984

and David Yost

OIL & GAS DIVISION

being first duly sworn according to law depose and say that they are experienced in the work of plugging and filling oil and gas wells and were employed by Consolidation Coal Company well operator, and participated in the work of plugging and filling the above well, that said work was commenced on the 28 day of February, 1984, and that the well was plugged and filled in the following manner:

SAND OR ZONE RECORD FORMATION	FILLING MATERIAL	PLUGS USED SIZE & KIND	CASING	
			CSG PULLED	CSG LEFT IN
Cleaned out wellbore to 1024 feet, found top of 8" casing at 535'. Cut and removed 30 feet of that 8" casing. Ran coal protection string as follows:			8" casing 560 to ?	
2 3/8" tubing from 1012 feet to 699 feet;			4 1/2" casing 699 to surface	
4 1/2" casing from 699 feet to surface.			2 3/8" tubing 1012' to 699'	
Flapper valve at 699 and latch down at 677'.				
Circulated cement as follows:				
Pumped 400 sacks of poz mix followed by 300 sacks of expanding cement.				
Displaced cement to 677-feet with water. Let set and bailed dry.				
COAL SEAMS				
(NAME) Pittsburgh	548' to 540'		DESCRIPTION OF MONUMENT	
(NAME)			Five feet of 4 1/2" casing with plaque stating: Consol M3-67	
(NAME)			47-061-0744-P	
(NAME)				

and that the work of plugging and filling said well was completed on the 6th day of March, 1984

And further deponents saith not.

Sworn to and subscribed before me this 8th day of March, 1984

Larry Yost
David D. Yost

Kelli D. Wilson

My commission expires: March 25, 1993

Notary Public

Permit No. 47-061-0744-P