


*M.J. 5-4-84*

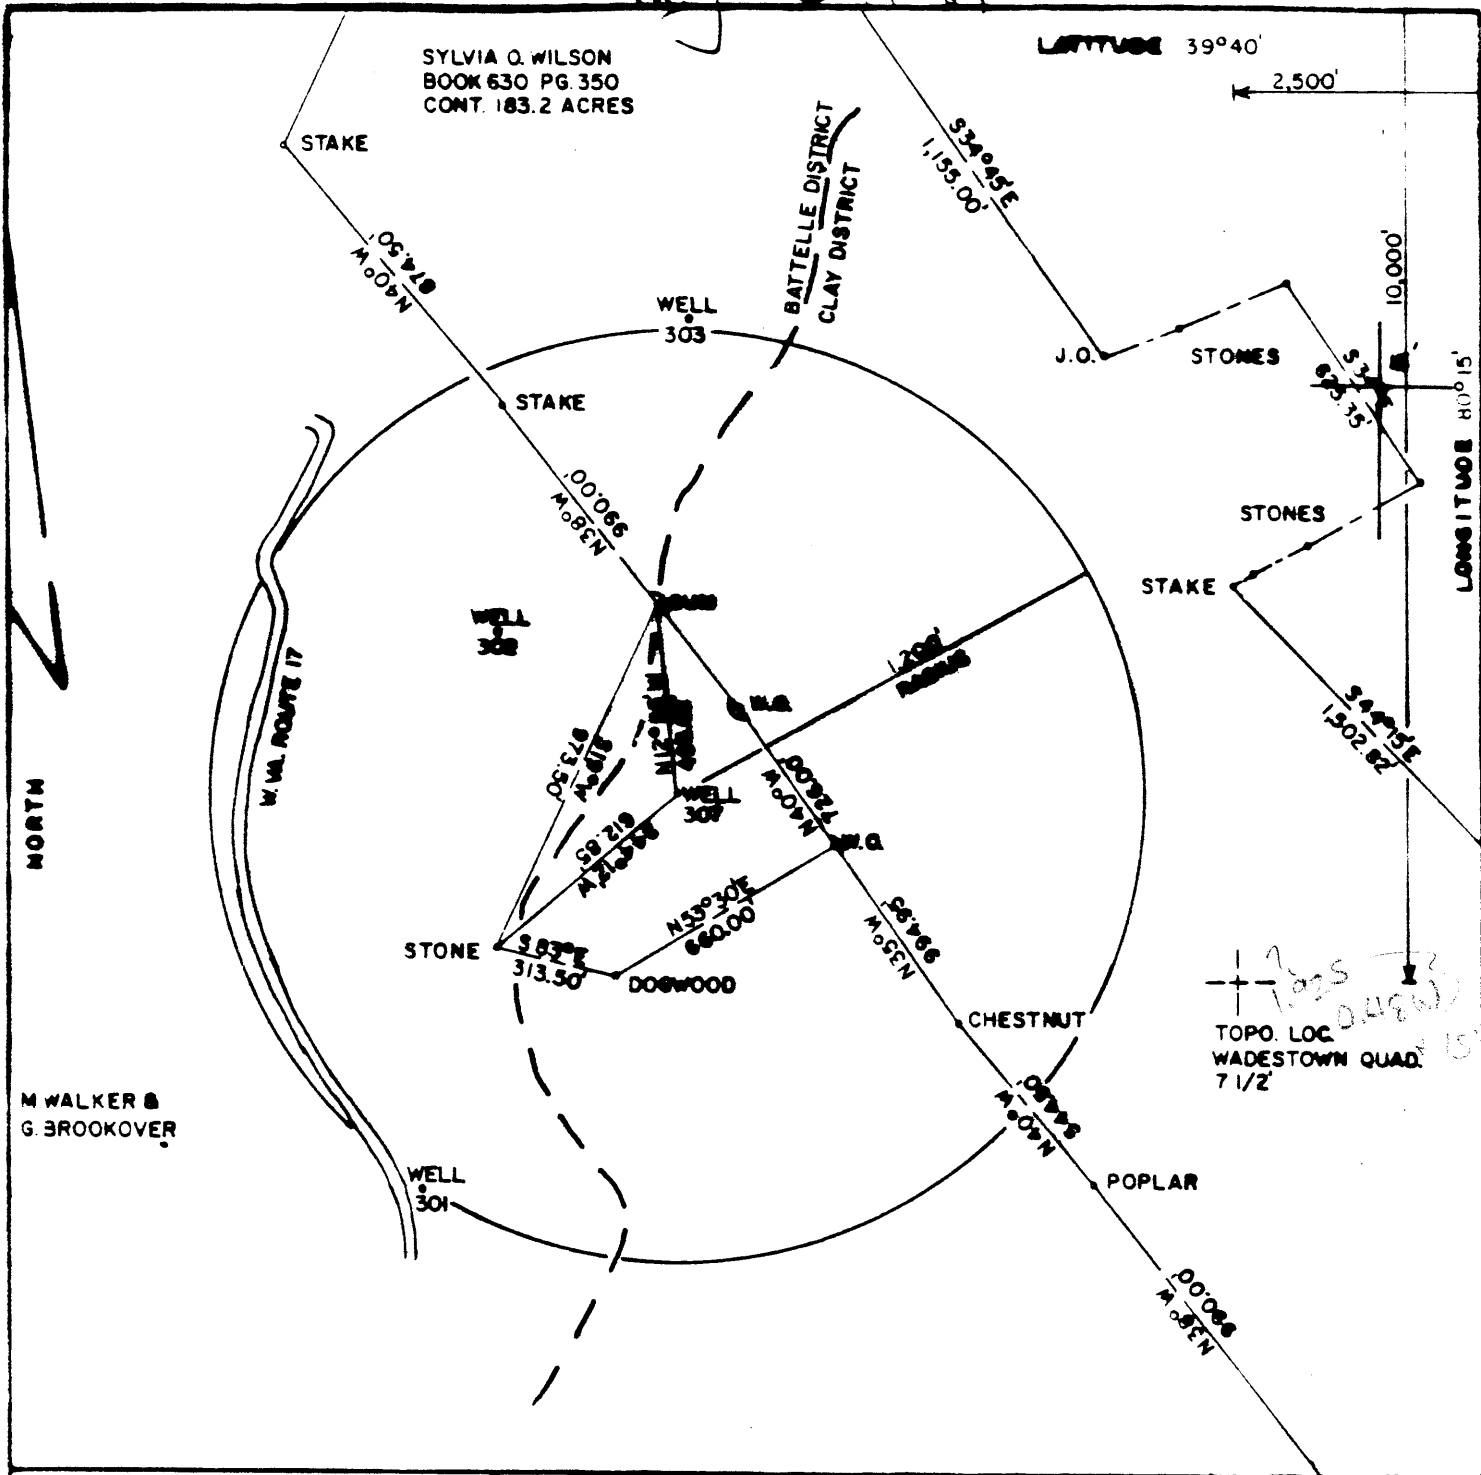

FILE NO. F2-06-100REV.  
 DRAWING NO. F2-2-142  
 SCALE 1"=500'  
 MINIMUM DEGREE OF ACCURACY 1/2500  
 PROVEN SOURCE OF ELEVATION USGS-BM  
 109 RHP-1957

I THE UNDERSIGNED, HEREBY CERTIFY THAT THIS PLAT IS CORRECT TO THE BEST OF MY KNOWLEDGE AND BELIEF AND SHOWS ALL THE INFORMATION REQUIRED BY LAW AND THE REGULATIONS ISSUED AND PRESCRIBED BY THE DEPARTMENT OF MINES.  
 (SIGNED) *James K. ...*  
 R.P.E. 7249 L.L.S. \_\_\_\_\_

PLACE SEAL HERE

(+) DENOTES LOCATION OF WELL ON UNITED STATES TOPOGRAPHIC MAPS  
 FORM IV-6  
 (8-78)



DATE APRIL 13, 1984  
 OPERATOR'S WELL NO. 307  
 API WELL NO. 47-061-0747-p  
 STATE COUNTY PERMIT

STATE OF WEST VIRGINIA  
 DEPARTMENT OF MINES  
 OIL AND GAS DIVISION

WELL TYPE: OIL  GAS \_\_\_\_\_ LIQUID INJECTION \_\_\_\_\_ WASTE DISPOSAL \_\_\_\_\_  
 ('N' GAS', PRODUCTION \_\_\_\_\_ STORAGE \_\_\_\_\_ DEEP \_\_\_\_\_ SHALLOW \_\_\_\_\_  
 LOCATION: ELEVATION 14530 WATER SHED \_\_\_\_\_ DISTRICT CLAY COUNTY MONROE  
 QUADRANGLE WADESTOWN 7 1/2  
 SURFACE OWNER SYLVIA Q. WILSON ACRES 183.2  
 OIL & GAS ROYALTY OWNER UNKNOWN LEASE ACRES UNKNOWN  
 LEASE NO. \_\_\_\_\_  
 PROPOSED WORK: DRILL \_\_\_\_\_ CONVERT \_\_\_\_\_ DRILL DEEPER \_\_\_\_\_ REGRILL  FRACTURE OR STIMULATE \_\_\_\_\_ PLUG OFF OLD FORMATION \_\_\_\_\_ PERFORATE NEW FORMATION \_\_\_\_\_ OTHER PHYSICAL CHANGE IN WELL (SPECIFY) \_\_\_\_\_  
 PLUG AND ABANDON  CLEAN OUT AND REPLUG \_\_\_\_\_  
 TARGET FORMATION \_\_\_\_\_ ESTIMATED DEPTH \_\_\_\_\_  
 WELL OPERATOR EASTERN ASSOC. COAL CORP. DESIGNATED AGENT GARY L. BENNETT  
 ADDRESS RT. 1, BOX 144 ADDRESS FAIRVIEW, W.V. 26570