

(+) DENOTES LOCATION OF WELL ON UNITED STATES TOPOGRAPHIC MAPS

FILE NO. \_\_\_\_\_  
 DRAWING NO. \_\_\_\_\_  
 SCALE 1" = 400'  
 MINIMUM DEGREE OF ACCURACY 1 IN 5000  
 PROVEN SOURCE OF ELEVATION COMPANY SURVEY  
TIED INTO U.S.G.S. NETWORK

I THE UNDERSIGNED, HEREBY CERTIFY THAT THIS PLAT IS CORRECT TO THE BEST OF MY KNOWLEDGE AND BELIEF AND SHOWS ALL THE INFORMATION REQUIRED BY LAW AND THE REGULATIONS ISSUED AND PRESCRIBED BY THE DEPARTMENT OF MINES.

(SIGNED) C. Nelson Mc Coy  
 R.P.E. \_\_\_\_\_ L.L.S. 110

PLACE SEAL HERE

**STATE OF WEST VIRGINIA**  
 DEPARTMENT OF MINES  
**OIL AND GAS DIVISION**



DATE JANUARY 6, 19 84  
 OPERATOR'S WELL NO. 4262  
 API WELL NO.

WELL TYPE: OIL  GAS  LIQUID INJECTION  WASTE DISPOSAL   
 (IF "GAS,") PRODUCTION  STORAGE  DEEP  SHALLOW  ABANDONED   
 LOCATION: ELEVATION 1160.33 WATERSHED SOUTH FORK OF DUNKARD CREEK  
 DISTRICT BATTELLE COUNTY MONONGALIA

QUADRANGLE MANNINGTON W.V. 7.5  
 SURFACE OWNER HARRY M. KING ACREAGE 58.48  
 OIL & GAS ROYALTY OWNER UNKNOWN LEASE ACREAGE \_\_\_\_\_

LEASE NO. \_\_\_\_\_  
 PROPOSED WORK: DRILL  CONVERT  DRILL DEEPER  REDRILL  FRACTURE OR STIMULATE  PLUG OFF OLD FORMATION  PERFORATE NEW FORMATION  OTHER PHYSICAL CHANGE IN WELL (SPECIFY) \_\_\_\_\_

PLUG AND ABANDON  CLEAN OUT AND REPLUG   
 TARGET FORMATION NONE ESTIMATED DEPTH \_\_\_\_\_  
 WELL OPERATOR CONSOLIDATION COAL COMPANY DESIGNATED AGENT ROGER E. LUCKWORTH  
 ADDRESS P.O. BOX 1314 ADDRESS P.O. BOX 1314  
MORGANTOWN W.V. 26305 MORGANTOWN W.V. 26305

OCT 20 1984

FORM IV-6 (8-78)  
 H.T. HALL

COUNTY NAME  
 PERMIT

STATE OF WEST VIRGINIA  
DEPARTMENT OF MINES  
OIL AND GAS WELLS DIVISION

AFFIDAVIT OF PLUGGING AND FILLING WELL

AFFIDAVIT SHOULD BE MADE IN TRIPLICATE, one copy mailed to the Department, one copy to be retained by the Well Operator and the third copy (and extra copies if required) should be mailed to each coal operator at their respective addresses.

Consolidation Coal Company	Consolidation Coal Company
Coal Operator or Owner	Name of Well Operator
P. O. Box 1314, Morgantown, W. Va. 26507-1314	P.O. Box 1314, Morgantown, WVA 26507-1314
Address	Complete Address
Consolidation Coal Company	November 06, 19 84
Coal Operator or Owner	WELL AND LOCATION
P.O. Box 1314, Morgantown, WV 26507-1314	Battelle District
Address	Monongalia County
Harry M. King	WELL NO. 4262
Lease or Property Owner	Harry M. King
Address	Farm

**RECEIVED**  
DEC 20 1984  
OIL & GAS DIVISION  
DEPT. OF MINE

STATE INSPECTOR SUPERVISING PLUGGING Don Ellis, Fairmont, W. Va.

AFFIDAVIT

STATE OF WEST VIRGINIA,  
County of Monongalia ss:

Calvin C. Lofton and Mark Wright  
being first duly sworn according to law depose and say that they are experienced in the work of plugging and filling oil and gas wells and were employed by Consolidation Coal Company, well operator, and participated in the work of plugging and filling the above well, that said work was commenced on the 29th day of October, 19 84, and that the well was plugged and filled in the following manner:

Sand or Zone Record Formation	Filling Material	Plugs Used Size & Kind	Casing	
			CSG PULLED	CSG LEFT IN
Cleaned out wellbore to 1,496 feet.				
Ran coal protection string as follows:				
338.93 feet of 2 3/8 inch tubing 1,115.60 feet				
of 4 1/2 inch casing. Latch down plug at 1,093.60 feet.				
Float valve at 1,115.60 feet. Circulated cement to surface as follows: Pumped 740 sacks of poz mix followed by 295 sacks of expanding cement.				
Displaced cement to 1,093.60 feet with water.				
Let set. Bailed dry.				
Coal Seams				
(Name) Pittsburgh 972 feet	to 980 feet	5 feet of 4 1/2 inch casing with plaque stating: Consol 4262		
(Name)		47-061-0749-P		
(Name)				
(Name)				


and that the work of plugging and filling said well was completed on the 6th day of November, 19 84.

And further deponents saith not.

Sworn to and subscribed before me this 27th day of November, 19 84.

*Calvin C. Lofton*  
*Mark Wright*  
\_\_\_\_\_  
Notary Public

My commission expires:

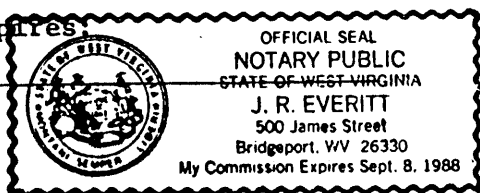

Permit No. 47-061-0749-P