

(+) DENOTES LOCATION OF WELL ON UNITED STATES TOPOGRAPHIC MAPS

FILE NO. \_\_\_\_\_  
 DRAWING NO. \_\_\_\_\_  
 SCALE 1" = 500'  
 MINIMUM DEGREE OF ACCURACY 1 IN 5000  
 PROVEN SOURCE OF ELEVATION COMPANY SURVEY  
TIED INTO THE U.S.G.S. NETWORK

I THE UNDERSIGNED, HEREBY CERTIFY THAT THIS PLAT IS CORRECT TO THE BEST OF MY KNOWLEDGE AND BELIEF AND SHOWS ALL THE INFORMATION REQUIRED BY LAW AND THE REGULATIONS ISSUED AND PRESCRIBED BY THE DEPARTMENT OF MINES.  
 (SIGNED) R. M. McCay  
 R.P.E. \_\_\_\_\_ L.L.S. 110

STATE OF WEST VIRGINIA  
 DEPARTMENT OF MINES  
 OIL AND GAS DIVISION  
 PLACE SEAL HERE

**STATE OF WEST VIRGINIA**  
 DEPARTMENT OF MINES  
 OIL AND GAS DIVISION

DATE FEBRUARY 29, 19 84  
 OPERATOR'S WELL NO. MI-352  
 API WELL NO. \_\_\_\_\_

WELL TYPE: OIL  GAS  LIQUID INJECTION  WASTE DISPOSAL   
 (IF "GAS,") PRODUCTION  STORAGE  DEEP  SHALLOW  ABANDONED

LOCATION: ELEVATION 1373.10 WATER SHED JAKES RUN  
 DISTRICT CLAY COUNTY MONONGALIA  
 QUADRANGLE BLACKSVILLE W.V. PA. 7.5 415 WC

SURFACE OWNER LARRY A. BRAGG ACREAGE 39.04  
 OIL & GAS ROYALTY OWNER \_\_\_\_\_ LEASE ACREAGE \_\_\_\_\_  
 LEASE NO. \_\_\_\_\_

PROPOSED WORK: DRILL  CONVERT  DRILL DEEPER  REDRILL  FRACTURE OR STIMULATE  PLUG OFF OLD FORMATION  PERFORATE NEW FORMATION  OTHER PHYSICAL CHANGE IN WELL (SPECIFY) \_\_\_\_\_

PLUG AND ABANDON  CLEAN OUT AND REPLUG   
 TARGET FORMATION NONE ESTIMATED DEPTH \_\_\_\_\_

WELL OPERATOR CONSOLIDATION COAL COMPANY DESIGNATED AGENT ROGER E. DUCKWORTH  
 ADDRESS P.O. BOX 1314 MORGANTOWN W.V. 26505 ADDRESS P.O. BOX 1314 MORGANTOWN W.V. 26505

FEB 11 1985

FORM IV-6 (8-78)

COUNTY NAME PERMIT

AFFIDAVIT OF PLUGGING AND FILLING WELL

AFFIDAVIT SHOULD BE MADE IN TRIPLICATE, one copy mailed to the Department, one copy to be retained by the Well Operator and the third copy (and extra copies if required) should be mailed to each coal operator at their respective addresses.

Consolidation Coal Company  
Coal Operator or Owner  
P.O. Box 1314 Morgantown, W.Va.  
Address  
Same  
Coal Operator or Owner  
Address  
Larry A. Bragg  
Lease or Property Owner  
Address

Consolidation Coal Company  
Name of Well Operator  
P.O. Box 1314 Morgantown, W.Va.  
Complete Address  
April 26 19 85  
WELL AND LOCATION  
Clay District  
Monongalia County  
WELL NO. M1-352  
Bragg Farm


STATE INSPECTOR SUPERVISING PLUGGING Don Ellis

AFFIDAVIT

STATE OF WEST VIRGINIA,  
County of Monongalia ss:

Larry L. Yost and David D. Yost  
being first duly sworn according to law depose and say that they are experienced in the work of plugging and filling oil and gas wells and were employed by Consolidation Coal Co., well operator, and participated in the work of plugging and filling the above well, that said work was commenced on the 9th day of April, 19 85, and that the well was plugged and filled in the following manner:

Sand or Zone Record Formation	Filling Material	Plugs Used Size & Kind	Casing	
			CSG PULLED	CSG LEFT IN
	Pulled 2220 ft. of 2 3/8" tubing. Pulled 1809 ft. of 5 1/2" casing. Pulled 1690 ft. of 7 in. casing. Pulled 1320 ft. of 8 in. Cleaned wellbore to 2290 ft. Ran tubing to 2280 ft. Pumped 85 sks. of cement. Tagged top of plug at 1820 ft. Cut 8 5/8 at 1550 ft. Ran coal protection as follows: 1055 ft. of 4 1/2" casing : 705 ft. of 2 3/8 tubing: Latch down at 1031 ft.: Float at 1055 ft. ; Swedge at 1055 ft. Circulated cement to surface as follows: 850 sks. of Pox Mix : 430 Sks, of expanding type cement: 1,000 gal. of mud flush. Let set, bailed dry, set monument.	2 3/8 5 1/2		2 3/8 pulled " " 180
Coal Seams			Description of Monument	
(Name) Pittsburgh, 880'	<u>WJ</u>	<u>7/8/85</u>	5 ft. of 4 1/2" casing with plaque stating Consol M1-352. 47-61-0757	
(Name)				
(Name)				
(Name)				

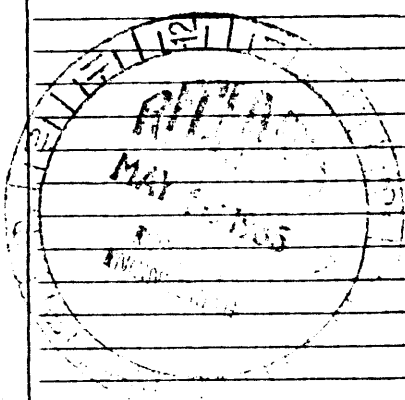

and that the work of plugging and filling said well was completed on the 23rd day of April, 19 85.

And further deponents saith not.

Sworn to and subscribed before me this 23rd day of April, 19 85.

Larry L. Yost  
David D. Yost  
Lelli D. Wilson  
Notary Public

My commission expires:  
Lelli D. Wilson

Permit No. 061-0757-P