


SCOTT & VIRGINIA BUNNER

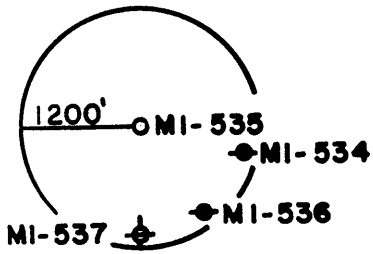

2.775
2.050

VIRGINIA K. BUNNER

(+) DENOTES LOCATION OF WELL ON UNITED STATES TOPOGRAPHIC MAPS

FILE NO. _____
 DRAWING NO. _____
 SCALE 1" = 300'
 MINIMUM DEGREE OF ACCURACY 1 IN 5000
 PROVEN SOURCE OF ELEVATION COMPANY SURVEY
TIED INTO THE U.S.G.S. NETWORK

I THE UNDERSIGNED, HEREBY CERTIFY THAT THIS PLAT IS CORRECT TO THE BEST OF MY KNOWLEDGE AND BELIEF AND SHOWS ALL THE INFORMATION REQUIRED BY LAW AND THE REGULATIONS ISSUED AND PRESCRIBED BY THE DEPARTMENT OF MINES.

(SIGNED) R. Nelson McCoy
 R.P.E. _____ L.L.S. MO



STATE OF WEST VIRGINIA
 DEPARTMENT OF MINES
 OIL AND GAS DIVISION



DATE MARCH 1, 1984
 OPERATOR'S WELL NO. MI-535
 API WELL NO. _____

WELL TYPE: OIL ___ GAS ___ LIQUID INJECTION ___ WASTE DISPOSAL ___ STATE COUNTY PERMIT
 (IF "GAS,") PRODUCTION ___ STORAGE ___ DEEP ___ SHALLOW ABANDONED X

LOCATION: ELEVATION 1276.74 WATERSHED DAYS RUN
 DISTRICT CLAY COUNTY MONONGALIA

QUADRANGLE BLACKSVILLE W.V. PA. 7.5

SURFACE OWNER TERRY & LILIA EDDY ACREAGE 31.04
 OIL & GAS ROYALTY OWNER UNKNOWN LEASE ACREAGE _____

PROPOSED WORK: DRILL ___ CONVERT ___ DRILL DEEPER ___ REDRILL X FRACTURE OR
 STIMULATE ___ PLUG OFF OLD FORMATION ___ PERFORATE NEW
 FORMATION ___ OTHER PHYSICAL CHANGE IN WELL (SPECIFY) _____

PLUG AND ABANDON ___ CLEAN OUT AND REPLUG X
 TARGET FORMATION NONE ESTIMATED DEPTH _____

WELL OPERATOR CONSOLIDATION COAL COMPANY DESIGNATED AGENT ROGER E. DUCKWORTH
 ADDRESS PO. BOX 1314 MORGANTOWN W.V. 26505 ADDRESS PO. BOX 1314 MORGANTOWN W.V. 26505

FEB 19 1985

FORM IV-6 (8-78) H.T. HALL

COUNTY NAME PERMIT

STATE OF WEST VIRGINIA
DEPARTMENT OF MINES
OIL AND GAS WELLS DIVISION

RECEIVED
SEP 05 1985

AFFIDAVIT OF PLUGGING AND FILLING WELL
DIVISION OF OIL & GAS
DEPARTMENT OF ENERGY

AFFIDAVIT SHOULD BE MADE IN TRIPLICATE. ONE COPY MAILED TO THE DEPARTMENT. ONE COPY TO BE RETAINED BY THE WELL OPERATOR AND THE THIRD COPY (AND EXTRA COPIES IF REQUIRED) SHOULD BE MAILED TO EACH COAL OPERATOR AT THEIR RESPECTIVE ADDRESSES.

<u>Consolidation Coal Company</u> COAL OPERATOR OR OWNER P. O. Box 1314, Morgantown, WV 26507-1314 ADDRESS	<u>Consolidation Coal Company</u> NAME OF WELL OPERATOR P. O. Box 1314, Morgantown, WV 26507-1314 COMPLETE ADDRESS
<u>Consolidation Coal Co.</u> COAL OPERATOR OR OWNER P.O. Box 1314, Morgantown, W.Va. ADDRESS	<u>August 27</u> 19 <u>85</u> WELL AND LOCATION
<u>Terry & Lilia Eddy</u> LEASE OR PROPERTY OWNER ADDRESS	<u>Clay</u> District <u>Monongalia</u> County
	Well No. <u>M1-535</u>
	<u>Farm</u>

STATE INSPECTOR SUPERVISING PLUGGING Don Ellis

AFFIDAVIT

STATE OF WEST VIRGINIA,
County of Monongalia } ss:

Larry L. Yost and David D. Yost
being first duly sworn according to law depose and say that they are experienced in the work of plugging and filling oil and gas wells and were employed by Consolidation Coal Co., well operator, and participated in the work of plugging and filling the above well, that said work was commenced on the 7th day of August, 1985, and that the well was plugged and filled in the following manner:

SAND OR ZONE RECORD	FILLING MATERIAL	PLUGS USED	CASING	
			SIZE & KIND	CBS PULLED CBS LEFT IN
FORMATION	Cleaned wellbore to 1535'. Ran coal protection string as follows: 1,010' of 4 1/2"; 506' of 2 3/8" tubing; Latchdown at 989'; Float at 1,010'; Swedge at 1,010'. Circulated cement to surface as follows: 725 sks. of Poz Mix; 425 sks. of Thixotropic; 1,000 gal. of mud flush. Let set, bailed dry, & set monument.			
COAL SEAMS				
(NAME) Pittsburgh-				
(NAME) 875 FT.				
(NAME)				
(NAME)				
				DESCRIPTION OF MONUMENT
				5 ft. of 4 1/2" casing with plaque stating Consol -M1-535 47-061-0759-P

RECEIVED
AUG 29 1985
REGIONAL ENGINEERING

9/9/85

and that the work of plugging and filling said well was completed on the 23rd day of August, 1985

And further deponents saith not.

Sworn to and subscribed before me this 27th day of August, 1985

Larry L. Yost
David D. Yost
Janice L. Hilson
Notary Public.

My commission expires: March 11, 1989

Permit No. 47-061-0759-P