


(+) DENOTES LOCATION OF WELL ON UNITED STATES TOPOGRAPHIC MAPS

FILE NO. \_\_\_\_\_  
 DRAWING NO. \_\_\_\_\_  
 SCALE 1" = 300'  
 MINIMUM DEGREE OF ACCURACY 1 IN 5000  
 PROVEN SOURCE OF ELEVATION COMPANY SURVEY  
TIED INTO THE U.S.G.S. NETWORK

I THE UNDERSIGNED, HEREBY CERTIFY THAT THIS PLAT IS CORRECT TO THE BEST OF MY KNOWLEDGE AND BELIEF AND SHOWS ALL THE INFORMATION REQUIRED BY LAW AND THE REGULATIONS ISSUED AND PRESCRIBED BY THE DEPARTMENT OF MINES.  
 (SIGNED) Robert Nelson McCoy  
 R.P.E. \_\_\_\_\_ L.L.S. 110

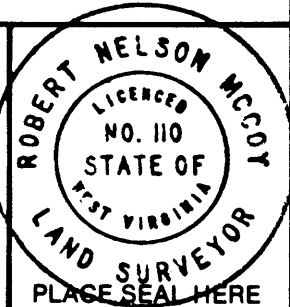

STATE OF WEST VIRGINIA  
 DEPARTMENT OF MINES  
 OIL AND GAS DIVISION



DATE JANUARY 31, 19 85  
 OPERATOR'S WELL NO. 4266  
 API WELL NO. 47-061-0764-P

WELL TYPE: OIL  GAS  LIQUID INJECTION  WASTE DISPOSAL   
 (IF "GAS,") PRODUCTION  STORAGE  DEEP  SHALLOW  ABANDONED   
 LOCATION: ELEVATION 1308.27 WATERSHED SOUTH FORK OF DUNKARD CREEK  
 DISTRICT BATTELLE COUNTY MONONGALIA  
 QUADRANGLE MANNINGTON, W.V. 7.5  
 SURFACE OWNER PATRICIA A. SIMPSON ACREAGE 33.25  
 OIL & GAS ROYALTY OWNER UNKNOWN LEASE ACREAGE \_\_\_\_\_  
 LEASE NO. \_\_\_\_\_  
 PROPOSED WORK: DRILL  CONVERT  DRILL DEEPER  REDRILL  FRACTURE OR STIMULATE  PLUG OFF OLD FORMATION  PERFORATE NEW FORMATION  OTHER PHYSICAL CHANGE IN WELL (SPECIFY) \_\_\_\_\_

PLUG AND ABANDON  CLEAN OUT AND REPLUG   
 TARGET FORMATION NONE ESTIMATED DEPTH \_\_\_\_\_  
 WELL OPERATOR CONSOLIDATION COAL COMPANY DESIGNATED AGENT ROGER E. DUCKWORTH  
 ADDRESS P.O. BOX 1314 MORGANTOWN, W.V. 26505 ADDRESS P.O. BOX 1314 MORGANTOWN, W.V. 26505

MAR 11 1985

FORM IV-6 (8-78)  
 H.T. HALL

COUNTY NAME  
 PERMIT

**RECEIVED**  
AUG 13 1985

AFFIDAVIT OF PLUGGING AND FILLING WELL

DIVISION OF OIL & GAS  
DEPARTMENT OF ENERGY

AFFIDAVIT SHOULD BE MADE IN TRIPLICATE, one copy mailed to the Department, one copy to be retained by the Well Operator and the third copy (and extra copies if required) should be mailed to each coal operator at their respective addresses.

Consolidation Coal Company  
Coal Operator or Owner  
P.O. Box 1314, Morgantown, WV 26507-1314  
Address  
Consolidation Coal Company  
Coal Operator or Owner  
P.O. Box 1314, Morgantown, WV 26507-1314  
Address  
Patricia A. Simpson  
Lease or Property Owner  
Mannington, WV  
Address

Consolidation Coal Company  
Name of Well Operator  
P.O. Box 1314, Morgantown, WV 26507-1314  
Complete Address  
July 31, 19 85  
WELL AND LOCATION  
Bartelle District  
Monongalia County  
WELL NO. Consol 4266  
Patricia A. Simpson Farm

STATE INSPECTOR SUPERVISING PLUGGING Don Ellis, Fairmont, WV 26554

AFFIDAVIT

STATE OF WEST VIRGINIA,  
County of Monongalia

ss:

Calvin C. Lofton and Mark Wright

being first duly sworn according to law depose and say that they are experienced in the work of plugging and filling oil and gas wells and were employed by Consolidation Coal Company, well operator, and participated in the work of plugging and filling the above well, that said work was commenced on the 14th day of July, 19 85, and that the well was plugged and filled in the following manner:

| Sand or Zone Record<br>Formation                                                                                                                                                                                                                                                                                                                                                                                                                          | Filling Material                | Plugs Used<br>Size & Kind                               | Casing        |                |
|-----------------------------------------------------------------------------------------------------------------------------------------------------------------------------------------------------------------------------------------------------------------------------------------------------------------------------------------------------------------------------------------------------------------------------------------------------------|---------------------------------|---------------------------------------------------------|---------------|----------------|
|                                                                                                                                                                                                                                                                                                                                                                                                                                                           |                                 |                                                         | CSG<br>PULLED | CSG<br>LEFT IN |
| Cleaned out wellbore to 1,534.00 feet. Fished parts of old tools out of hole. Ran coal protection string as follows: 192.85 feet of 2 3/8 inch tubing followed by 1,307.30 feet of 4 1/2 inch casing. Latch down plug at 1,284.02 feet. Float valve at 1,081.79 feet. Circulated cement to surface as follows: Pumped 820 sacks of poz mix followed by 375 sacks of expanding cement. Displaced cement 10 1,284.02 feet with water. Let set.. Bailed dry. |                                 |                                                         |               |                |
| Total plug 1,500.15 feet.                                                                                                                                                                                                                                                                                                                                                                                                                                 |                                 |                                                         |               |                |
| Coal Seams                                                                                                                                                                                                                                                                                                                                                                                                                                                |                                 |                                                         |               |                |
| (Name) <u>Pittsburgh</u>                                                                                                                                                                                                                                                                                                                                                                                                                                  | <u>1,122 feet to 1,130 feet</u> | <u>5 feet of 4 1/2 inch casing with plaque stating:</u> |               |                |
| (Name)                                                                                                                                                                                                                                                                                                                                                                                                                                                    |                                 | <u>Consol 4266</u>                                      |               |                |
| (Name)                                                                                                                                                                                                                                                                                                                                                                                                                                                    |                                 | <u>47-061-0764-P</u>                                    |               |                |
|                                                                                                                                                                                                                                                                                                                                                                                                                                                           |                                 | <u>Description of Monument</u>                          |               |                |

*[Signature]* 8/22/85

and that the work of plugging and filling said well was completed on the 27th day of July, 19 85.

And further deponents saith not.

*[Signature]*  
*[Signature]*

Sworn to and subscribed before me this 31st day of July, 19 85.

*[Signature]*  
Notary Public

My commission expires:  
September 08, 1988

Permit No. 47-061-0764-P