



21 v 2-26-85

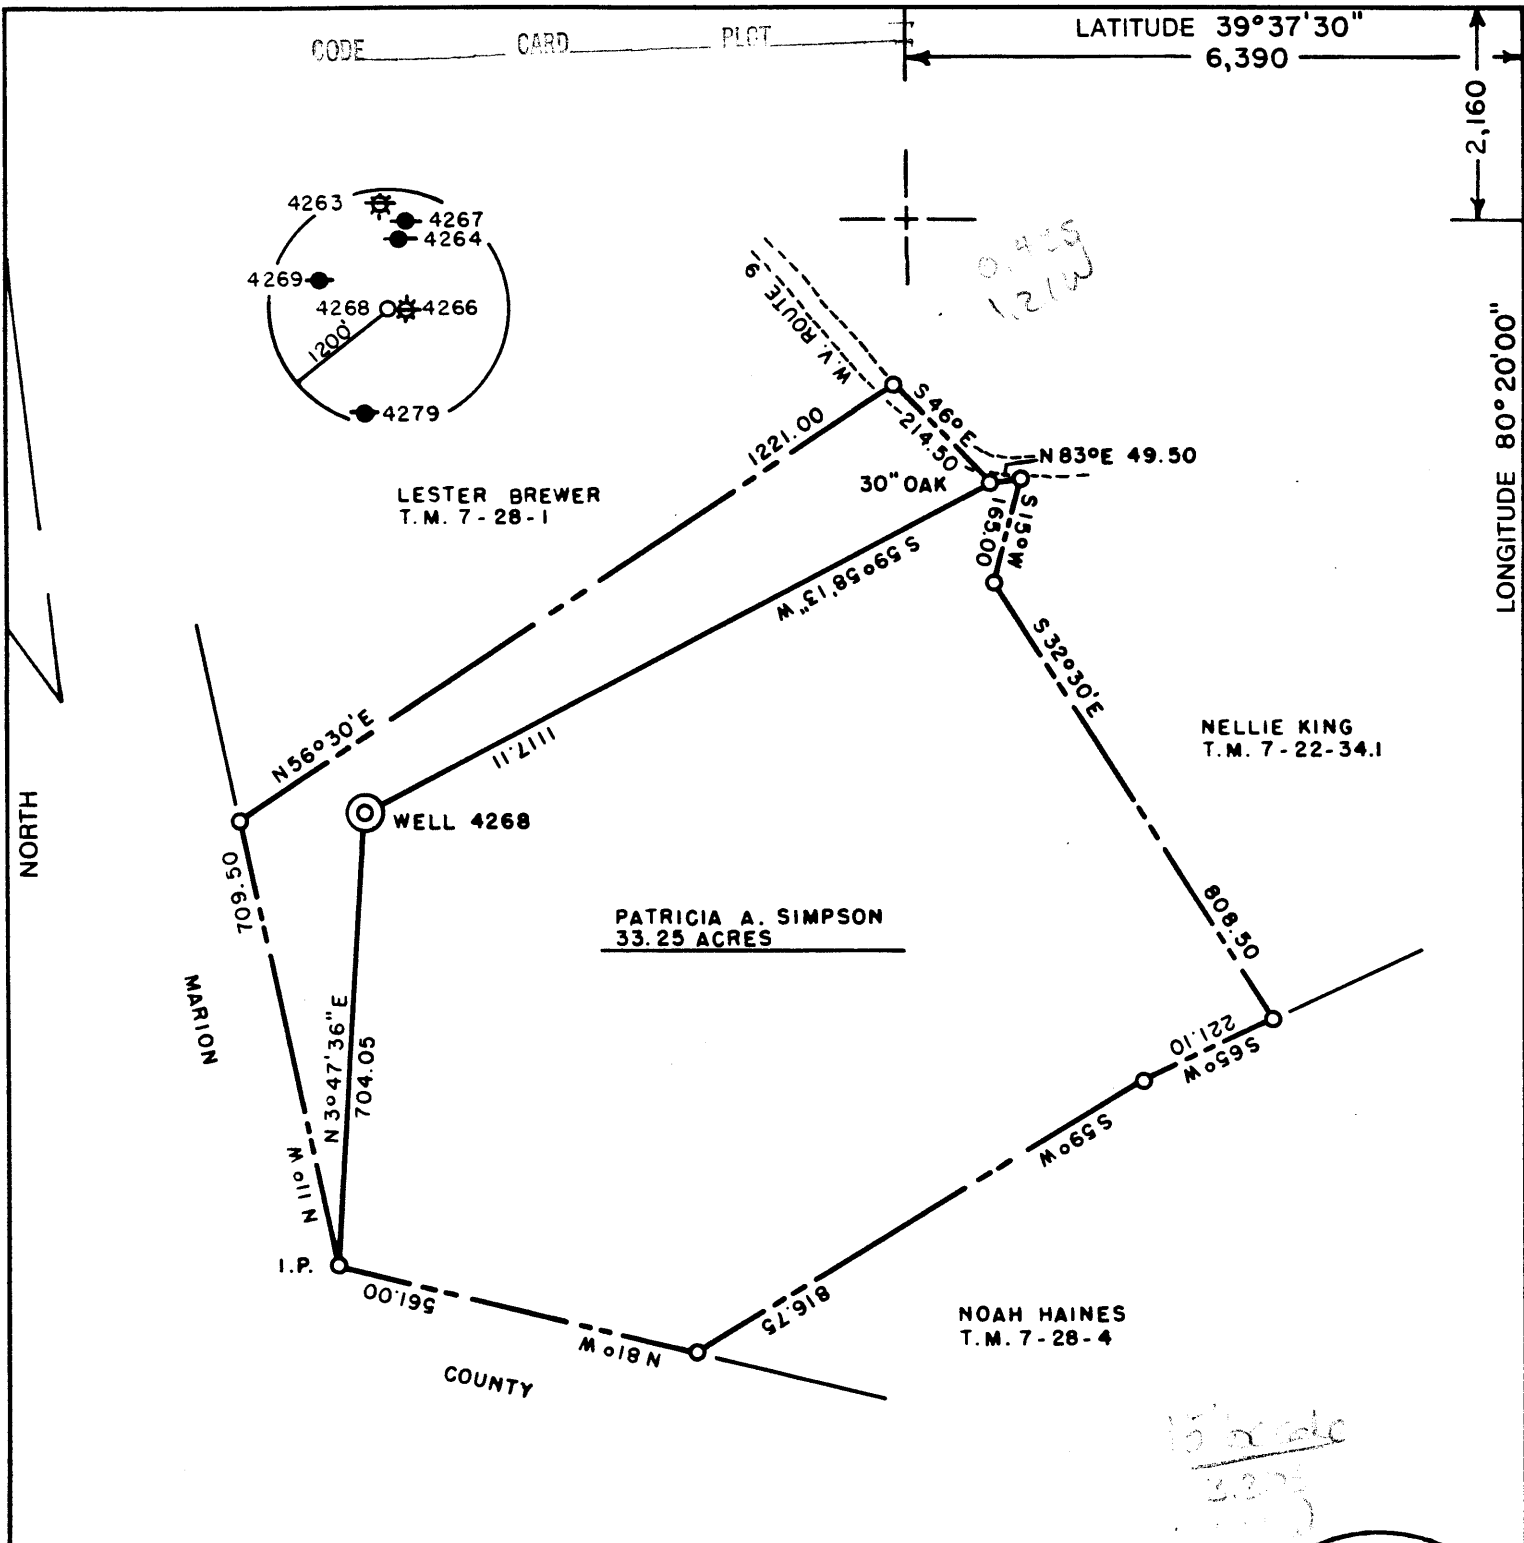

(+) DENOTES LOCATION OF WELL ON UNITED STATES TOPOGRAPHIC MAPS

FILE NO. _____
 DRAWING NO. _____
 SCALE 1" = 300'
 MINIMUM DEGREE OF ACCURACY 1 IN 5000
 PROVEN SOURCE OF ELEVATION COMPANY SURVEY
 TIED INTO THE U.S.G.S. NETWORK

I THE UNDERSIGNED, HEREBY CERTIFY THAT THIS PLAT IS CORRECT TO THE BEST OF MY KNOWLEDGE AND BELIEF AND SHOWS ALL THE INFORMATION REQUIRED BY LAW AND THE REGULATIONS ISSUED AND PRESCRIBED BY THE DEPARTMENT OF MINES.
 (SIGNED) R. Nelson McCoy
 R.P.E. _____ L.L.S. 118

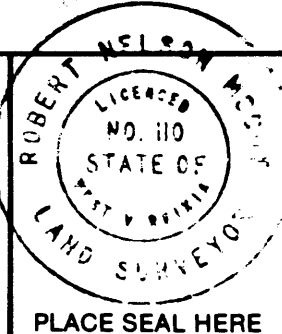

STATE OF WEST VIRGINIA
 DEPARTMENT OF MINES
OIL AND GAS DIVISION



DATE JANUARY 31, 19 85
 OPERATOR'S WELL NO. 4268
 API WELL NO. _____

WELL TYPE: OIL ___ GAS ___ LIQUID INJECTION ___ WASTE DISPOSAL ___ STATE COUNTY PERMIT
 (IF "GAS,") PRODUCTION ___ STORAGE ___ DEEP ___ SHALLOW X ABANDONED X

LOCATION: ELEVATION 1371.05 WATERSHED SOUTH FORK OF DUNKARD CREEK
 DISTRICT BATTELLE COUNTY MONONGALIA
 QUADRANGLE MANNINGTON, W.V. 7.5 #1510

SURFACE OWNER PATRICIA A. SIMPSON ACREAGE 33.25
 OIL & GAS ROYALTY OWNER UNKNOWN LEASE ACREAGE _____

PROPOSED WORK: DRILL ___ CONVERT ___ DRILL DEEPER ___ REDRILL X FRACTURE OR
 STIMULATE ___ PLUG OFF OLD FORMATION ___ PERFORATE NEW
 FORMATION ___ OTHER PHYSICAL CHANGE IN WELL (SPECIFY) _____

PLUG AND ABANDON ___ CLEAN OUT AND REPLUG X
 TARGET FORMATION NONE ESTIMATED DEPTH _____
 WELL OPERATOR CONSOLIDATION COAL COMPANY DESIGNATED AGENT ROGER E DUCKWORTH
 ADDRESS P.O. BOX 1314 MORGANTOWN, W.V. 26505 ADDRESS P.O. BOX 1314 MORGANTOWN, W.V. 26505

FORM IV-6 (8-78)
 H.T. HALL

COUNTY NAME
 PERMIT

AFFIDAVIT OF PLUGGING AND FILLING WELL

AFFIDAVIT SHOULD BE MADE IN TRIPLICATE, one copy mailed to the Department, one copy to be retained by the Well Operator and the third copy (and extra copies if required) should be mailed to each coal operator at their respective addresses.

Consolidation Coal Company
Coal Operator or Owner
P.O. Box 1314, Morgantown, WV 26507-1314
Address
Consolidation Coal Company
Coal Operator or Owner
P. O. Box 1314, Morgantown, WV 26507-1314
Address
Patricia A. Simpson
Lease or Property Owner

Address

Consolidation Coal Company
Name of Well Operator
P.O. Box 1314, Morgantown, WV 26507-1314
Complete Address
September 06, 19 85
WELL AND LOCATION
Battelle District
Monongalia County
WELL NO. 4268
Patricia A. Simpson Farm

STATE INSPECTOR SUPERVISING PLUGGING Don Ellis, Fairmont, WV 26554

AFFIDAVIT

STATE OF WEST VIRGINIA,
County of Monongalia
Calvin C. Lofton

ss:

Mark Wright

being first duly sworn according to law depose and say that they are experienced in the work of plugging and filling oil and gas wells and were employed by Consolidation Coal Company, well operator, and participated in the work of plugging and filling the above well, that said work was commenced on the 3rd day of August, 19 85, and that the well was plugged and filled in the following manner:

Sand or Zone Record Formation	Filling Material	Plugs Used Size & Kind	Casing	
			CSG PULLED	CSG LEFT IN
Cleaned out wellbore to 1,700 feet. Pulled 1,080 feet of 6 5/8 inch casing. Ran coal protection string as follows: 231.04 feet of 2 3/8 inch tubing followed by 1,312.84 feet of 4 1/2 inch casing. Latch down plug at 1,292.44 feet. Float valve at 1,312.84 feet. Circulated cement to surface as follows: Pumped 470 sacks of poz mix followed by 445 sacks of expanding cement. Displaced cement to 1,292.44 feet with water. Let set, bailed dry. Total plug 1,543.88 feet. Possible junk in front of coal.				
Coal Seams				
(Name) Pittsburgh 1,186 feet - 1,194 feet		5 feet of 4 1/2 inch casing with plaque stating:		
(Name)		Consol 4268		
(Name)		47-061-0765-P		

[Signature] 11/13/85

Description of Monument
5 feet of 4 1/2 inch casing with plaque stating:
Consol 4268
47-061-0765-P

and that the work of plugging and filling said well was completed on the 20th day of August, 19 85.

And further deponents saith not.

[Signature]
[Signature]

Sworn to and subscribed before me this 6th day of September, 19 85.

[Signature]
Notary Public

My commission expires:
September 08, 1988

Permit No. 47-061-0765-P