

WW-7
8-30-06



West Virginia Department of Environmental Protection
Office of Oil and Gas
WELL LOCATION FORM: GPS

API: 47-061-00779 WELL NO.: 1

FARM NAME: Amanda Tennant

RESPONSIBLE PARTY NAME: Noumenon Corporation

COUNTY: Monongalia DISTRICT: Clay

QUADRANGLE: Blacksville, WV

SURFACE OWNER: Norma R. Panrell

ROYALTY OWNER: Not Producing

UTM GPS NORTHING: 4391244.768

UTM GPS EASTING: 570738.607 GPS ELEVATION: 1035.18

The Responsible Party named above has chosen to submit GPS coordinates in lieu of preparing a new well location plat for a plugging permit or assigned API number on the above well. The Office of Oil and Gas will not accept GPS coordinates that do not meet the following requirements:

1. Datum: NAD 1983, Zone: 17 North, Coordinate Units: meters, Altitude: height above mean sea level (MSL) – meters.
2. Accuracy to Datum – 3.05 meters
3. Data Collection Method:

Survey grade GPS : Post Processed Differential

Real-Time Differential

Mapping Grade GPS : Post Processed Differential

Real-Time Differential

4. Letter size copy of the topography map showing the well location.

I the undersigned, hereby certify this data is correct to the best of my knowledge and belief and shows all the information required by law and the regulations issued and prescribed by the Office of Oil and Gas.

President


5/20/2016

Signature

Title

Date

Received
Office of Oil & Gas
MAY 26 2016

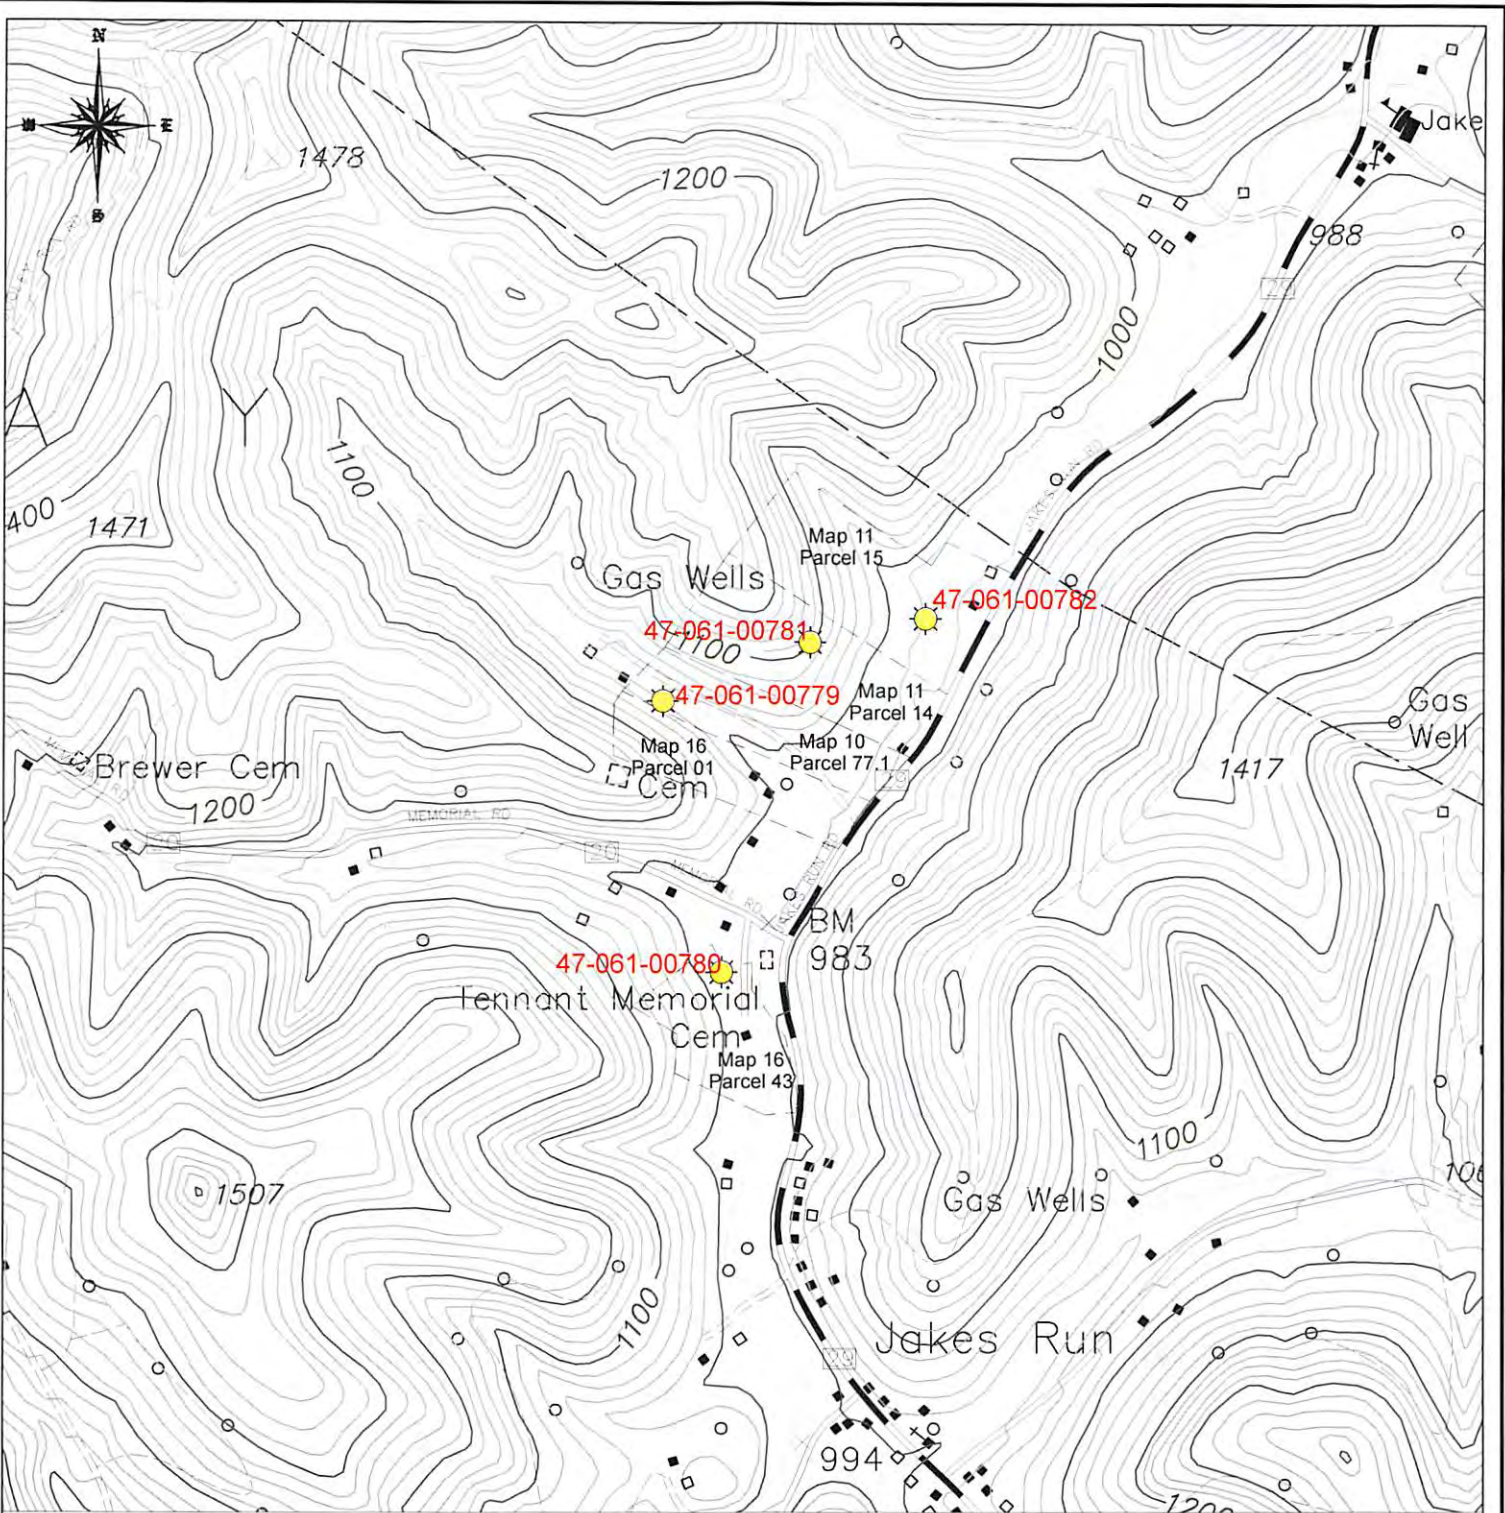

LEGEND

OIL WELL

Northing: 4391244.768

Easting: 570738.607

ELEVATION: 1035.18'

SURVEYED WELL LOCATION



PROPERTY LINE



0 FT 1000 FT 2000 FT



LOCATION MAP

NOUMENON CORPORATION

2461 MASON DIXON HIGHWAY, CORE, WV 26541

Received
Office of Oil & Gas

MAY 26 2016

API WELL NO. - 47-061-00779

OPERATOR'S WELL NO. - 1 - AMANDA TENNANT

CLAY DISTRICT- MONONGALIA COUNTY, WV

7.5 MINUTE SERIES- 20' CONTOUR INTERVAL

BLACKSVILLE, WV TOPO QUAD

06/17/2016