

RECEIVED  
Office of Oil and Gas

MAY 20 2016

WW-7  
8-30-06



WV Department of  
Environmental Protection

West Virginia Department of Environmental Protection  
Office of Oil and Gas

**WELL LOCATION FORM: GPS**

API: 47-061-00782 WELL NO.: 1

FARM NAME: Minor Tennant

RESPONSIBLE PARTY NAME: Noumenon Corporation

COUNTY: Monongalia DISTRICT: Clay

QUADRANGLE: Blacksville, WV

SURFACE OWNER: Leonard and Nancy Wilson

ROYALTY OWNER: Not Producing

UTM GPS NORTHING: 426527.637 = 4391361.436 N

UTM GPS EASTING: 1779806.978 = 571161.224 E GPS ELEVATION: 979.02

The Responsible Party named above has chosen to submit GPS coordinates in lieu of preparing a new well location plat for a plugging permit or assigned API number on the above well. The Office of Oil and Gas will not accept GPS coordinates that do not meet the following requirements:

1. Datum: NAD 1983, Zone: 17 North, Coordinate Units: meters, Altitude: height above mean sea level (MSL) – meters.
2. Accuracy to Datum – 3.05 meters
3. Data Collection Method:

Survey grade GPS  : Post Processed Differential

Real-Time Differential

Mapping Grade GPS  : Post Processed Differential

Real-Time Differential

4. Letter size copy of the topography map showing the well location.

I the undersigned, hereby certify this data is correct to the best of my knowledge and belief and shows all the information required by law and the regulations issued and prescribed by the Office of Oil and Gas.


President

5/20/2016

Signature

Title

Date

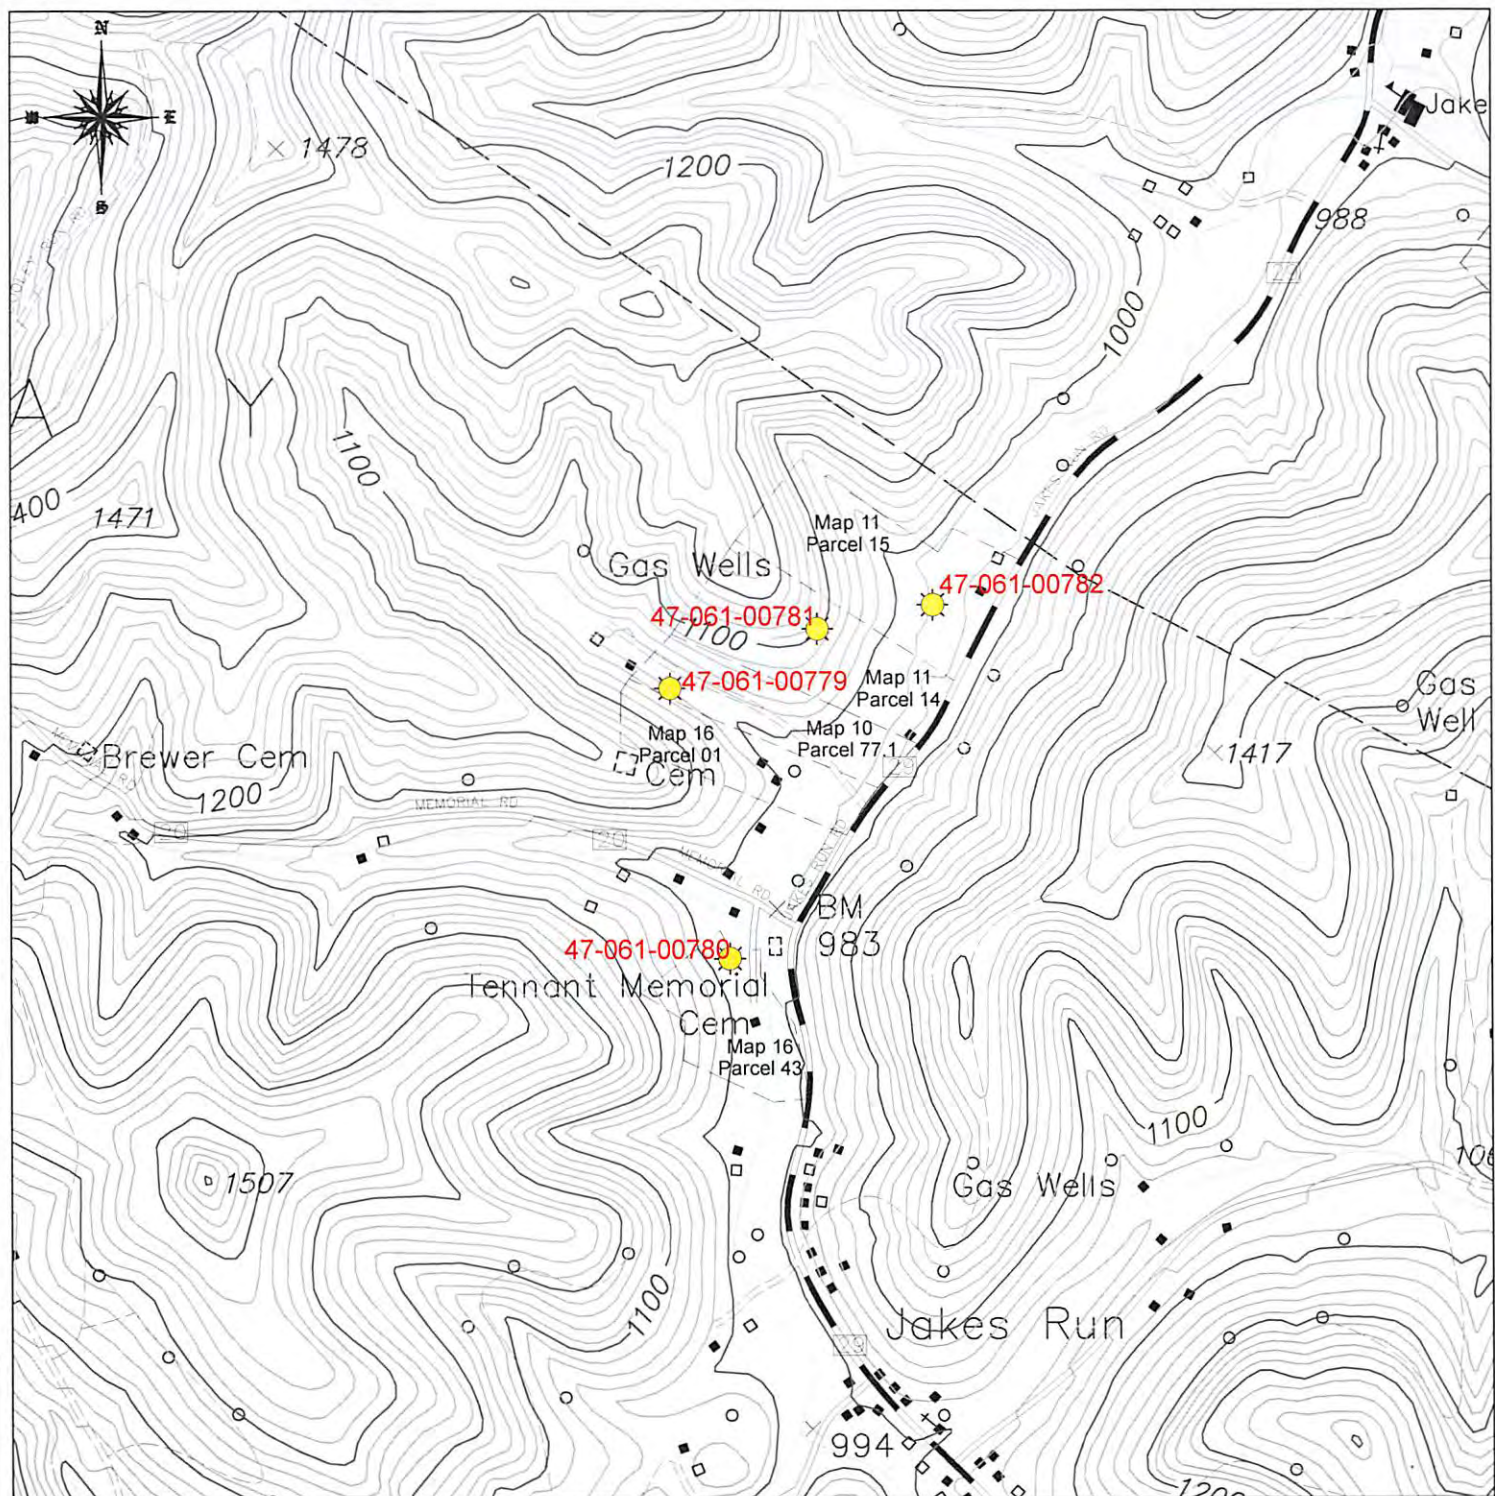

**LEGEND**

OIL WELL  
 LATITUDE: 39 40 08.9  
 LONGITUDE: 80 10 13.1  
 ELEVATION: 980'

HAND HELD GPS SURVEYED WELL LOCATION 

PROPERTY LINE 

0FT      1000FT      2000FT



**LOCATION MAP**

NOUMENON CORPORATION  
 2461 MASON DIXON HIGHWAY, CORE, WV 26541

APL WELL NO. **47-061-00782**  
 OPERATOR'S WELL NO. **1 MINOR TENNANT**

CLAY DISTRICT MONONGALIA COUNTY, WV  
 7.5 MINUTE SERIES - 20' CONTOUR INTERVAL  
 BLACKSVILLE, WV TOPO QUAD

RECEIVED  
 MAY 16 2016  
 WV Department of  
 Environmental Protection  
 06/17/2016