
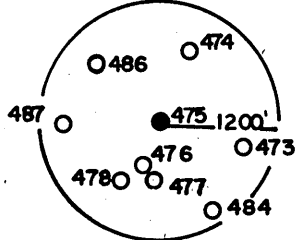



SFR 5/22/87

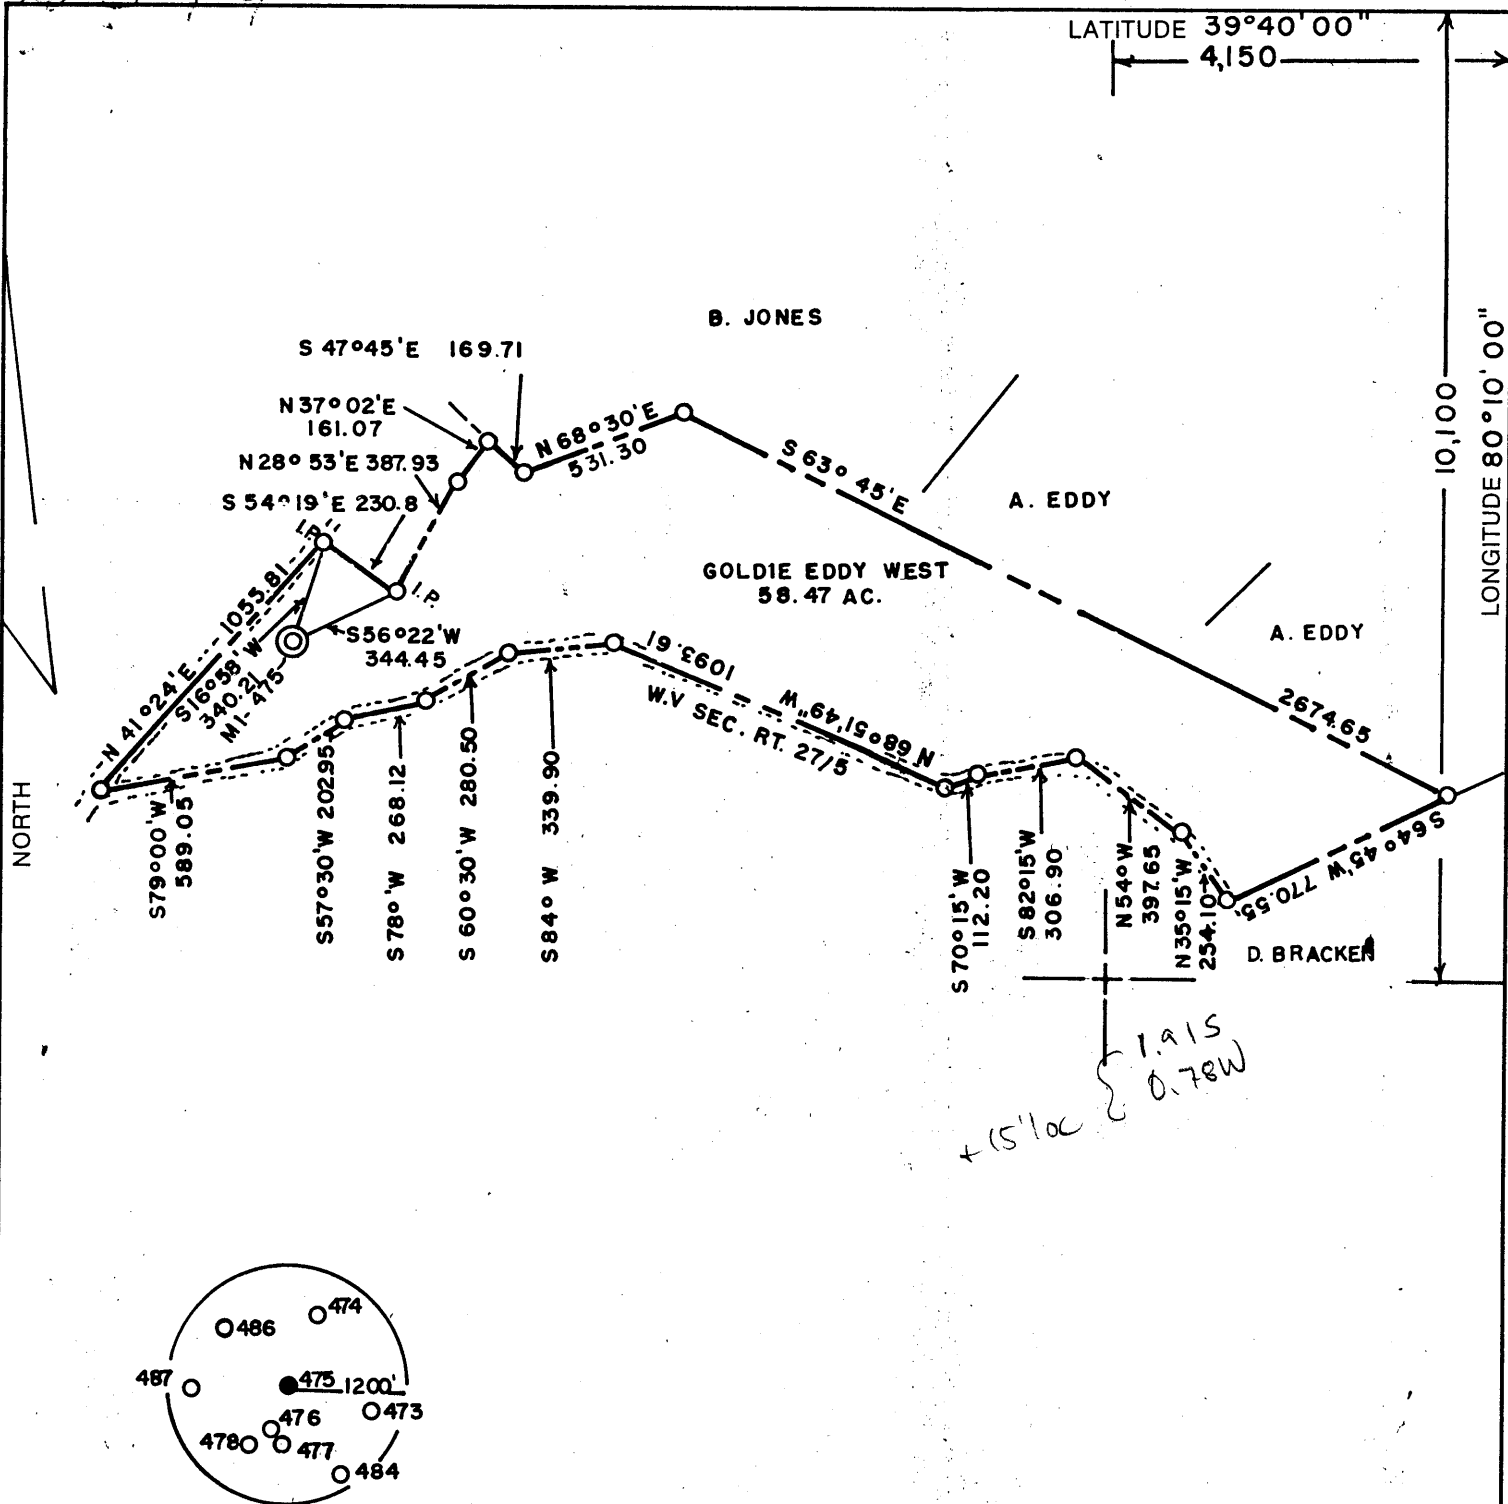

(+) DENOTES LOCATION OF WELL ON UNITED STATES TOPOGRAPHIC MAPS

FILE NO. _____
 DRAWING NO. _____
 SCALE 1" = 600'
 MINIMUM DEGREE OF ACCURACY 1 IN 5000
 PROVEN SOURCE OF ELEVATION COMPANY SURVEY TIED INTO U.S.G.S. NETWORK

I THE UNDERSIGNED, HEREBY CERTIFY THAT THIS PLAT IS CORRECT TO THE BEST OF MY KNOWLEDGE AND BELIEF AND SHOWS ALL THE INFORMATION REQUIRED BY LAW AND THE REGULATIONS ISSUED AND PRESCRIBED BY THE DEPARTMENT OF ENERGY.
 (SIGNED) R. Nelson McCoy
 R.P.E. _____ C.L.S. 110

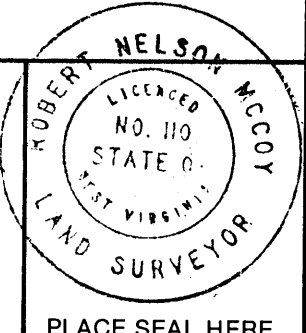

PLACE SEAL HERE

STATE OF WEST VIRGINIA
 DEPARTMENT OF ENERGY
 OIL AND GAS DIVISION



DATE 4-13, 19 87
 OPERATOR'S WELL NO. MI-475
 API WELL NO. _____

WELL TYPE: OIL GAS _____ LIQUID INJECTION _____ WASTE DISPOSAL _____
 (IF "GAS,") PRODUCTION _____ STORAGE _____ DEEP _____ SHALLOW ABANDONED
 LOCATION: ELEVATION 1042.0 WATERSHED JAKES RUN
 DISTRICT CLAY COUNTY MONONGALIA

QUADRANGLE BLACKSVILLE W.V. PA. 7.5 + 15 W.

SURFACE OWNER GOLDIE EDDY WEST ACREAGE 58.47

OIL & GAS ROYALTY OWNER M. EDDY & G. EDDY WEST LEASE ACREAGE _____

PROPOSED WORK: DRILL _____ CONVERT _____ DRILL DEEPER _____ REDRILL FRACTURE OR STIMULATE _____ PLUG OFF OLD FORMATION _____ PERFORATE NEW FORMATION _____ OTHER PHYSICAL CHANGE IN WELL (SPECIFY) _____

MAY 26 1987

PLUG AND ABANDON _____ CLEAN OUT AND REPLUG

TARGET FORMATION NONE ESTIMATED DEPTH _____

WELL OPERATOR CONSOLIDATION COAL COMPANY DESIGNATED AGENT ROGER E. DUCKWORTH

ADDRESS P.O. BOX 1314 MORGANTOWN W.V. 26505 ADDRESS P.O. BOX 1314 MORGANTOWN W.V. 26505

H.T. HALL 48673 FORM WW-6

COUNTY NAME _____ PERMIT _____

RECEIVED
NOV 06 1987

DIVISION OF OIL & GAS
DEPARTMENT OF ENERGY

AFFIDAVIT OF PLUGGING AND FILLING WELL

AFFIDAVIT SHOULD BE MADE IN TRIPLICATE, one copy mailed to the Division, one copy to be retained by the Well Operator and the third copy (and extra copies if required) should be mailed to each coal operator at their respective addresses.

Consolidation Coal Company
Coal Operator or Owner
P. O. Box 1314, Morgantown, WV 26507-1314

Consolidation Coal Company
Name of Well Operator
P.O. Box 1314, Morgantown, WV 26507-1314

Address

Complete Address

Consolidation Coal Company

September 25 19 87

Coal Operator or Owner
P. O. Box 1314, Morgantown, WV 26507-1314

WELL AND LOCATION
Clay District

Address

Monongalia County

Goldie M. Eddy West

WELL NO. M1-475

Lease or Property Owner
2509 Northcrest Road, Hagerstown, Md. 21740

Goldie M. Eddy West Farm

Address

STATE INSPECTOR SUPERVISING PLUGGING Don Ellis, 2604 Crabapple Lane, Fairmont, WV 26554

AFFIDAVIT

STATE OF WEST VIRGINIA,
County of Harrison

ss:

Calvin C. Lofton and J. Harold Wireman

being first duly sworn according to law depose and say that they are experienced in the work of plugging and filling oil and gas wells and were employed by Consolidation Coal Company, well operator, and participated in the work of plugging and filling the above well, that said work was commenced on the 11th day of September, 19 87, and that the well was plugged and filled in the following manner:

Sand or Zone Record Formation	Filling Material	Plugs Used Size & Kind	Casing	
			CSG PULLED	CSG LEFT IN
Cleaned out wellbore to 1,166.75 feet.				
Pulled 8 5/8" casing from 482' to 855'. Ran a 10 5/8" bit to 555' to check for 10" - none there.				
Ran coal protection string as follows: 457.77' of 2 3/8" tubing followed by .708.98' of 4 1/2" casing. Latch down plug at 650.40'. Float valve at 708.98'. Circulated cement to surface as follows: Pumped 520 sacks of poz mix followed by 280 sacks of expanding cement. Displaced cement to 650.40' with water. Let set, bailed dry.				
TOTAL PLUG 1,166.75 feet.				
Coal Seams		Description of Monument		
(Name) Pittsburgh	482 feet	5 feet of 4 1/2" casing with plaque stating:		
(Name)		Consol M1-475		
(Name)		47-061-0839-P		

and that the work of plugging and filling said well was completed on the 21st day of Septmeber, 19 87.

And further deponents saith not.

Sworn to and subscribed before me this 25th day of September, 19 87.

Calvin C. Lofton
J. Harold Wireman
J. L. Ewert
Notary Public NOV 23 1987