


*James 7/22/88*

LATITUDE 39° 37' 30"

+1,180  
2,520  
LONGITUDE 80° 17' 30"

NORTH

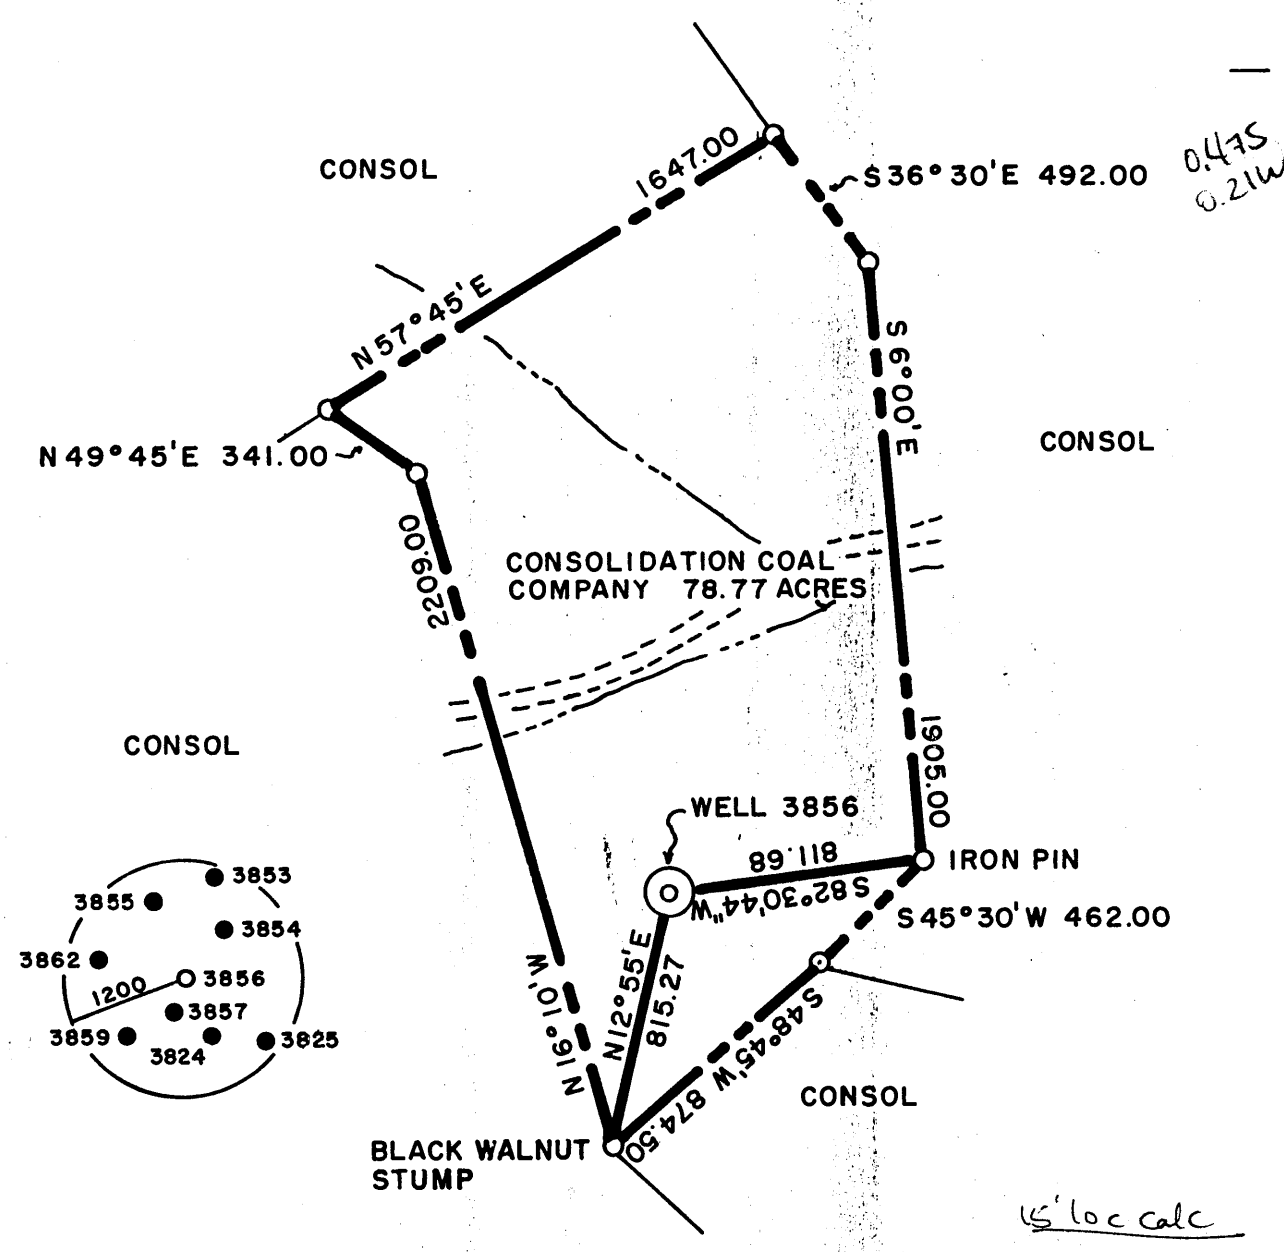

(+) DENOTES LOCATION OF WELL ON UNITED STATES TOPOGRAPHIC MAPS

FILE NO. \_\_\_\_\_  
DRAWING NO. \_\_\_\_\_  
SCALE 1" = 600'  
MINIMUM DEGREE OF ACCURACY 1 IN 5000  
PROVEN SOURCE OF ELEVATION COMPANY SURVEY  
TIED INTO THE U.S.G.S. NETWORK

I THE UNDERSIGNED, HEREBY CERTIFY THAT THIS PLAT IS CORRECT TO THE BEST OF MY KNOWLEDGE AND BELIEF AND SHOWS ALL THE INFORMATION REQUIRED BY LAW AND THE REGULATIONS ISSUED AND PRESCRIBED BY THE DEPARTMENT OF ENERGY.  
(SIGNED) Carl Morris  
R.P.E. \_\_\_\_\_ L.L.S. 460

PLACE SEAL HERE

STATE OF WEST VIRGINIA  
DEPARTMENT OF ENERGY  
OIL AND GAS DIVISION



DATE MAY 11 19 88  
OPERATOR'S WELL NO. 3856  
API WELL NO. 47 61 0874-P

WELL TYPE: OIL \_\_\_ GAS \_\_\_ LIQUID INJECTION \_\_\_ WASTE DISPOSAL \_\_\_ STATE COUNTY PERMIT  
(IF "GAS,") PRODUCTION \_\_\_ STORAGE \_\_\_ DEEP \_\_\_ SHALLOW X ABANDONED X  
LOCATION: ELEVATION 1341.91 WATERSHED PAW PAW CREEK  
DISTRICT BATTELLE COUNTY MONONGALIA  
QUADRANGLE MANNINGTON W.V. 7.5 +15 EC  
SURFACE OWNER CONSOLIDATION COAL COMPANY ACREAGE 78.77  
OIL & GAS ROYALTY OWNER UNKNOWN LEASE ACREAGE \_\_\_\_\_  
LEASE NO. \_\_\_\_\_  
PROPOSED WORK: DRILL \_\_\_ CONVERT \_\_\_ DRILL DEEPER \_\_\_ REDRILL X FRACTURE OR  
STIMULATE \_\_\_ PLUG OFF OLD FORMATION \_\_\_ PERFORATE NEW  
FORMATION \_\_\_ OTHER PHYSICAL CHANGE IN WELL (SPECIFY) \_\_\_\_\_

PLUG AND ABANDON \_\_\_ CLEAN OUT AND REPLUG X  
TARGET FORMATION NONE ESTIMATED DEPTH \_\_\_\_\_  
WELL OPERATOR CONSOLIDATION COAL COMPANY DESIGNATED AGENT ROGER E. DUCKWORTH  
ADDRESS P.O. BOX 1314 MORGANTOWN W.V. 26505 ADDRESS P.O. BOX 1314 MORGANTOWN W.V. 26505

AUG 01 1988

H.T. HALL 48673 FORM WW-6

COUNTY NAME  
PERMIT

**RECEIVED**  
JAN 26 1989

DIVISION OF OIL & GAS  
DEPARTMENT OF ENERGY

AFFIDAVIT OF PLUGGING AND FILLING WELL

AFFIDAVIT SHOULD BE MADE IN TRIPLICATE, one copy mailed to the Division, one copy to be retained by the Well Operator and the third copy (and extra copies if required) should be mailed to each coal operator at their respective addresses.

Consolidation Coal Company  
Coal Operator or Owner  
P. O. Box 1314, Morgantown, WV 26507-1314  
Address

Consolidation Coal Company  
Name of Well Operator  
P. O. Box 1314, Morgantown, WV 26507-1314  
Complete Address

Coal Operator or Owner  
Address

August 29, 19 88  
WELL AND LOCATION  
Battelle District

Consolidation Coal Company  
Lease or Property Owner  
P. O. Box 1314, Morgantown, WV 26507-1314  
Address

Monongalia County  
WELL NO. 3856

Consolidation Coal Company Farm

STATE INSPECTOR SUPERVISING PLUGGING Don Ellis, Fairmont, WV 26554

AFFIDAVIT

STATE OF WEST VIRGINIA,  
County of Harrison

ss:

Calvin C. Lofton and George R. Gore  
being first duly sworn according to law depose and say that they are experienced in the work of plugging and filling oil and gas wells and were employed by Consolidation Coal Company, well operator, and participated in the work of plugging and filling the above well, that said work was commenced on the 11th day of August, 19 88, and that the well was plugged and filled in the following manner:

Sand or Zone Record Formation	Filling Material	Plugs Used Size & Kind	Casing	
			CSG PULLED	CSG LEFT IN
Cleaned 9 7/8" hole to 1,096' at 1,096'. Cleaned 7 7/8" hole to 1,659'. Drilled 9 7/8" hole thru Pittsburgh Coal (1,046' to 1,054') Pulled 8 5/8" casing from 1,096' to 1,395'. 8 5/8" casing left in hole from 1,395' to 1,535'. Ran coal protection string as follows: 407.97' of 2 3/8" tubing followed by 1,206.13' of 4 1/2" casing. Latch down plug at 1,188.81'. Float valve at 1,206.13'. Swedge at 1,207.13'. Circulated cement to surface as follows: Pumped 720 sacks of poz mix followed by 250 sacks of expanding cement. Displaced cement to 1,188.81' with water. Let set, bailed dry.				
TOTAL DEPTH: 1,614.10 feet				
Coal Seams			Description of Monument	
(Name) Pittsburgh	1,046 feet to 1,054 feet		5 feet of 4 1/2" casing with plaque stating:	
(Name)			Consol #3856	
(Name)			#47-061-0874-P	

**RECEIVED**  
SEP 06 1988  
REGIONAL  
ENGINEERING  
2/2/89

and that the work of plugging and filling said well was completed on the 24th day of August, 19 88.

And further deponents saith not.

Calvin C. Lofton  
George R. Gore

Sworn to and subscribed before me this 29th day of August, 19 88.

My commission expires:  
April 21, 1993

Notary Public FEB 3 1989

Permit No. 47-061-0874-P