


Janie 1/4/89

LATITUDE 39° 40' 00"

9,150

LONGITUDE 80° 10' 00"

8,500

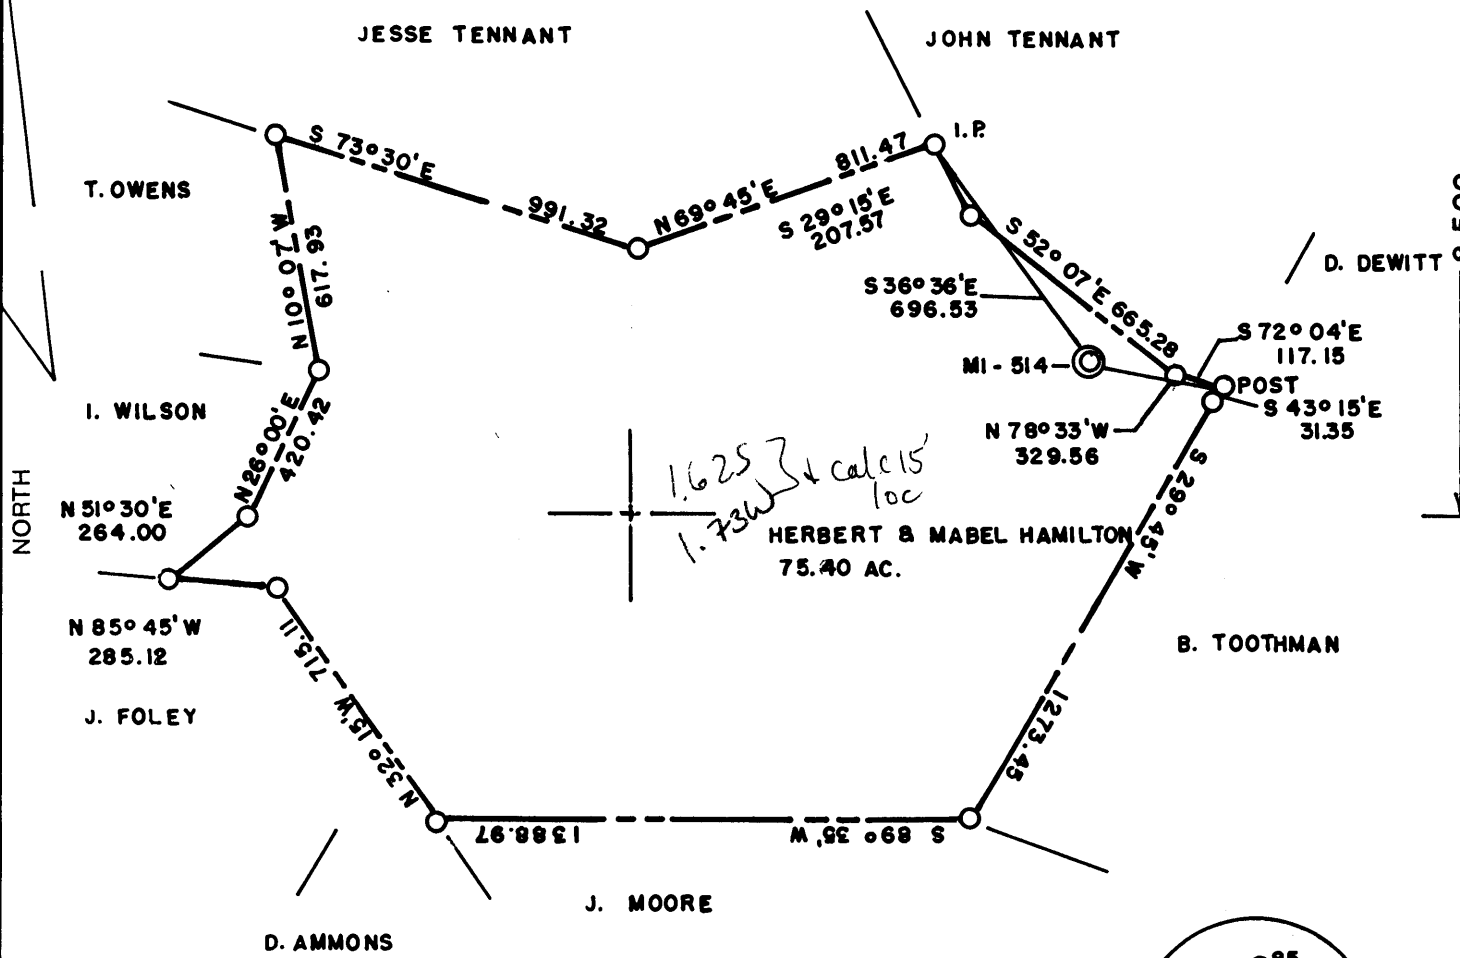


(+) DENOTES LOCATION OF WELL ON UNITED STATES TOPOGRAPHIC MAPS

FILE NO. _____
 DRAWING NO. _____
 SCALE 1" = 500'
 MINIMUM DEGREE OF ACCURACY 1 IN 5000
 PROVEN SOURCE OF ELEVATION COMPANY SURVEY
 TIED INTO U.S.G.S. NETWORK

I THE UNDERSIGNED, HEREBY CERTIFY THAT THIS PLAT IS CORRECT TO THE BEST OF MY KNOWLEDGE AND BELIEF AND SHOWS ALL THE INFORMATION REQUIRED BY LAW AND THE REGULATIONS ISSUED AND PRESCRIBED BY THE DEPARTMENT OF ENERGY.

(SIGNED) R. Nelson McCoy
 R.P.E. _____ L.L.S. 110

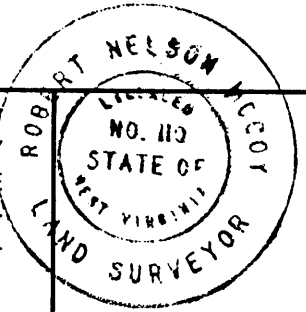

PLACE SEAL HERE

STATE OF WEST VIRGINIA
 DEPARTMENT OF ENERGY
 OIL AND GAS DIVISION



DATE APRIL 24, 1988
 OPERATOR'S WELL NO. MI-514
 API WELL NO. _____

WELL TYPE: OIL ___ GAS ___ LIQUID INJECTION ___ WASTE DISPOSAL ___
 (IF "GAS,") PRODUCTION ___ STORAGE ___ DEEP ___ SHALLOW X ABANDONED X
 LOCATION: ELEVATION 1514.52 WATERSHED JAKES RUN

DISTRICT CLAY COUNTY MONONGALIA
 QUADRANGLE BLACKSVILLE W.V. PA. 7.5 + 15' WC

SURFACE OWNER HERBERT & MABEL HAMILTON ACREAGE 75.40
 OIL & GAS ROYALTY OWNER JOHN L. TENNANT HEIRS LEASE ACREAGE _____

PROPOSED WORK: DRILL ___ CONVERT ___ DRILL DEEPER ___ REDRILL ___ FRACTURE OR
 STIMULATE ___ PLUG OFF OLD FORMATION ___ PERFORATE NEW
 FORMATION ___ OTHER PHYSICAL CHANGE IN WELL (SPECIFY) _____

PLUG AND ABANDON ___ CLEAN OUT AND REPLUG X
 TARGET FORMATION NONE ESTIMATED DEPTH _____

WELL OPERATOR CONSOLIDATION COAL CO. DESIGNATED AGENT ROGER E. DUCKWORTH
 ADDRESS P.O. BOX 1314 MORGANTOWN W.V. 26505 ADDRESS P.O. BOX 1314 MORGANTOWN W.V. 26505

JAN 06 1988

H.T. HALL 48673 FORM WW-6

COUNTY NAME PERMIT

AFFIDAVIT OF PLUGGING AND FILLING WELL

AFFIDAVIT SHOULD BE MADE IN TRIPLICATE, one copy mailed to the Division, one copy to be retained by the Well Operator and the third copy (and extra copies if required) should be mailed to each coal operator at their respective addresses.

Consolidation Coal Co.
Coal Operator or Owner
P.O. Box 1314, Morgantown, W. Va. 26507
Address

Consolidation Coal Co.
Coal Operator or Owner
P.O. Box 1314, Morgantown, W. Va. 26507
Address

Herbert & Mabel Hamilton
Lease or Property Owner
Rt. 2 Fairview, W. Va. 26570
Address

Consolidation Coal Co.
Name of Well Operator
P.O. Box 1314, Morgantown, W. Va.
Complete Address

July 20 19 89
WELL AND LOCATION
Clay District
Monongalia County

WELL NO. M1-514
Hamilton

STATE INSPECTOR SUPERVISING PLUGGING Don Ellis
AFFIDAVIT

RECEIVED
JUL 27 1989

DIVISION OF OIL & GAS
DEPARTMENT OF ENERGY

STATE OF WEST VIRGINIA,
County of Monongalia ss:

Larry L. Yost and Douglas J. Skinner
being first duly sworn according to law depose and say that they are experienced in the work of plugging and filling oil and gas wells and were employed by Consolidation Coal Co., well operator, and participated in the work of plugging and filling the above well, that said work was commenced on the 21st day of June, 19 89, and that the well was plugged and filled in the following manner:

Sand or Zone Record Formation	Filling Material	Plugs Used Size & Kind	Casing	
			CSG PULLED	CSG LEFLIN
	Cleaned wellbore to 1520 ft.	8 1/2"	380'	
	Pulled 380 ft. of 8 1/2" casing. Pulled 694 ft. of 10" casing. Ran coal protection string as follows; 1243 ft. of 4 1/2" casing; 262 ft. of 2 3/8" tubing; Latch down plug at 1235 ft.; Float valve at 1243 ft.; Swedge at 1244 ft. Circulated cement to surface as follows; 1020 sacks of Poz Mix; 375 sacks of expanding type cement; 1,000 gal. of mud flush. Let set, bailed dry, set monument.	10"	1257'	2
Coal Seams		Description of Monument		
(Name) Pittsburgh-1030 ft.		6 ft. of 4 1/2" casing with plaque stating Consol		
(Name)		M1-514.		
(Name)		47-61-0898-P		

and that the work of plugging and filling said well was completed on the 14th day of July, 19 89.

And further deponents saith not.

Sworn to and subscribed before me this 14th day of July, 19 89.

Larry L. Yost
Douglas J. Skinner
Gelli D. Wilson
Notary Public

My commission expires:
March 15, 1993