
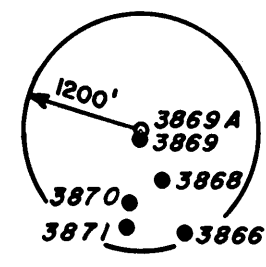


Jamie 5/26/89

LATITUDE 39° 37' 30"
 4,697'
 3,548'
 60° 17' 30"
 LONGITUDE

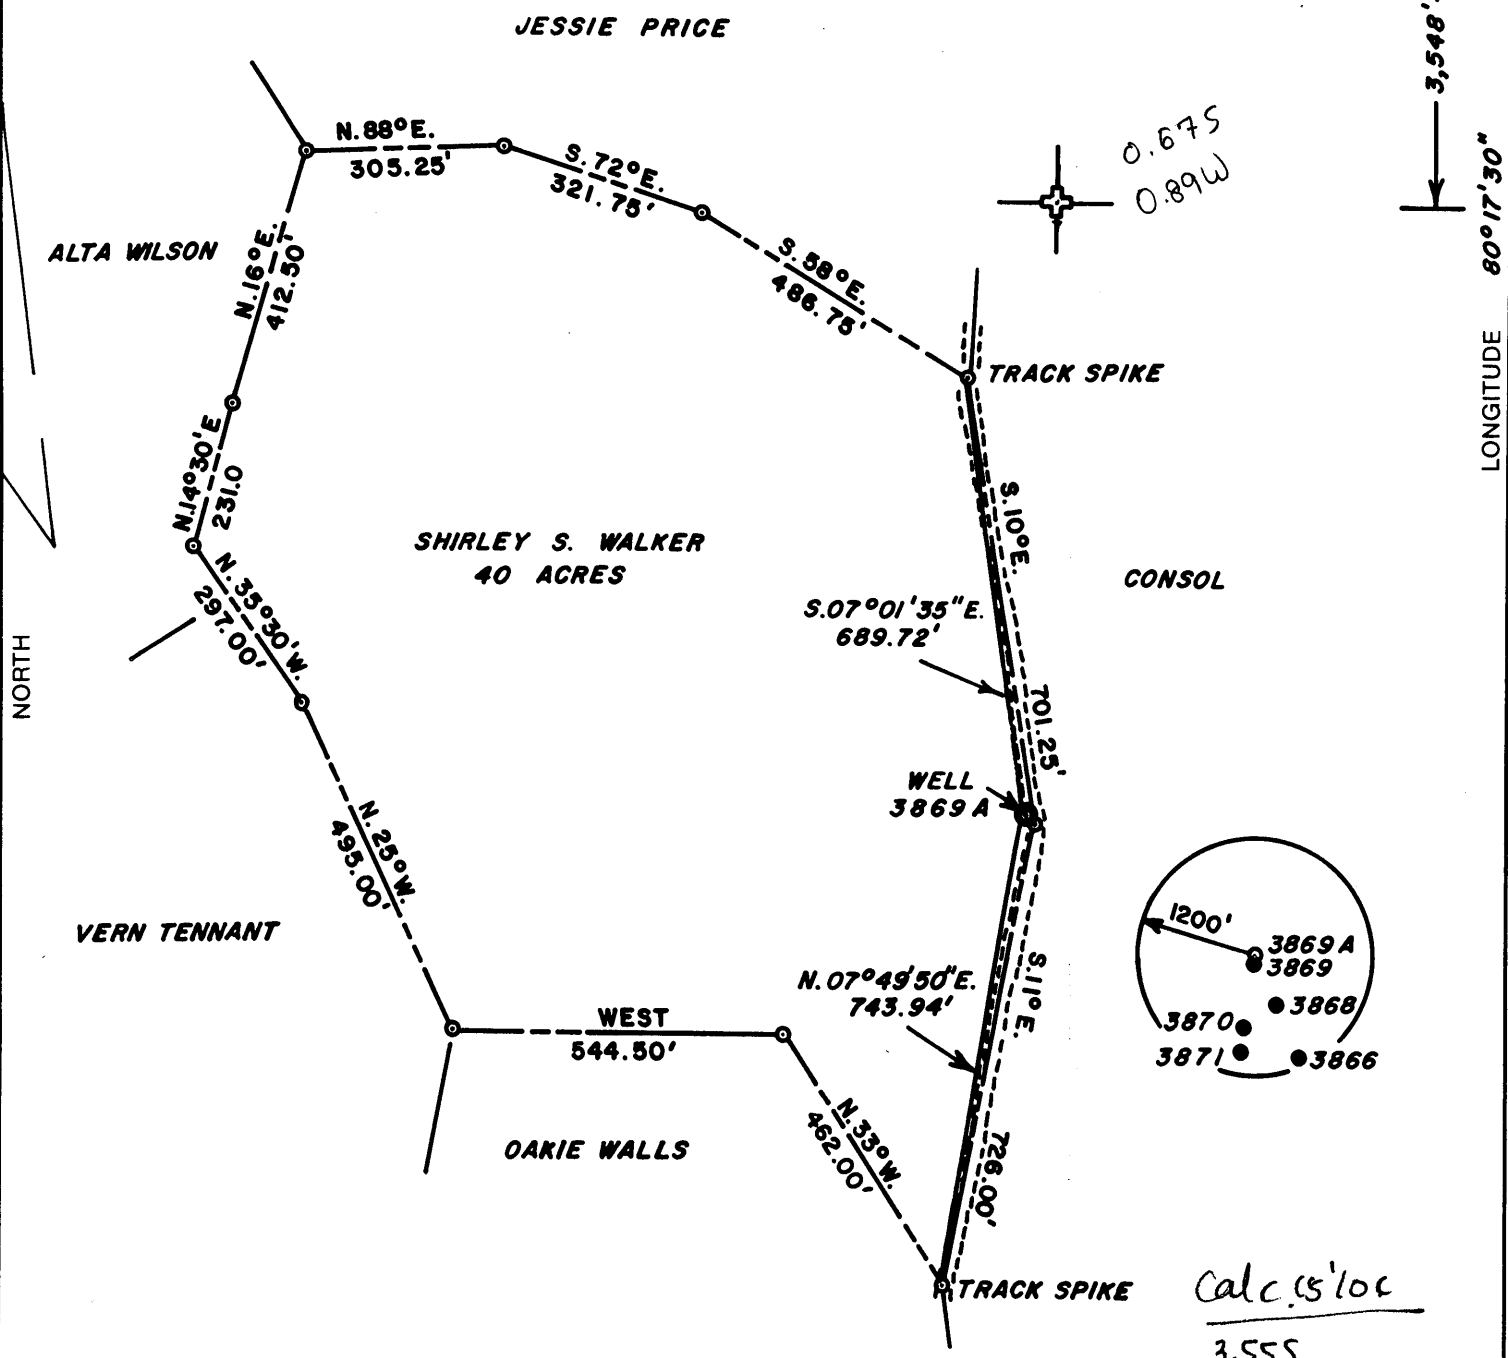

Calc. 15' loc
 3.555
 3.11w

(+) DENOTES LOCATION OF WELL ON UNITED STATES TOPOGRAPHIC MAPS

FILE NO. _____
 DRAWING NO. _____
 SCALE 1" = 300'
 MINIMUM DEGREE OF ACCURACY 1 IN 5000
 PROVEN SOURCE OF ELEVATION COMPANY SURVEY
 TIED INTO THE U.S.G.S. NETWORK

I THE UNDERSIGNED, HEREBY CERTIFY THAT THIS PLAT IS CORRECT TO THE BEST OF MY KNOWLEDGE AND BELIEF AND SHOWS ALL THE INFORMATION REQUIRED BY LAW AND THE REGULATIONS ISSUED AND PRESCRIBED BY THE DEPARTMENT OF ENERGY.
 (SIGNED) Van W. Pitman
 R.P.E. 10356 L.L.S. _____

PLACE SEAL HERE

STATE OF WEST VIRGINIA
 DEPARTMENT OF ENERGY
 OIL AND GAS DIVISION



DATE MAY 18 1989
 OPERATOR'S WELL NO. 3869 A
 API WELL NO. _____

WELL TYPE: OIL ___ GAS ___ LIQUID INJECTION ___ WASTE DISPOSAL ___
 (IF "GAS,") PRODUCTION ___ STORAGE ___ DEEP ___ SHALLOW X ABANDONED X
 LOCATION: ELEVATION 1607 WATER SHED MIRACLE RUN

DISTRICT BATTELLE COUNTY MONONGALIA

QUADRANGLE MANNINGTON, WV 7.5' 15' EC

SURFACE OWNER SHIRLEY S. WALKER ACREAGE 40

OIL & GAS ROYALTY OWNER UNKNOWN LEASE ACREAGE _____

LEASE NO. _____

PROPOSED WORK: DRILL ___ CONVERT ___ DRILL DEEPER ___ REDRILL X FRACTURE OR STIMULATE ___ PLUG OFF OLD FORMATION ___ PERFORATE NEW FORMATION ___ OTHER PHYSICAL CHANGE IN WELL (SPECIFY) _____

PLUG AND ABANDON ___ CLEAN OUT AND REPLUG X

TARGET FORMATION NONE ESTIMATED DEPTH _____

WELL OPERATOR CONSOLIDATION COAL COMPANY DESIGNATED AGENT ROGER E. DUCKWORTH
 ADDRESS P.O. BOX 1314 MORGANTOWN, WV 26505 ADDRESS P.O. BOX 1314 MORGANTOWN, WV 26505

JUN 2 1989

COUNTY NAME
 PERMIT

RECEIVED
NOV 19 91
 Division of Energy
 Oil and Gas Section

FORM WR-38
 (Affidavit of Plugging)

STATE OF WEST VIRGINIA
 DEPARTMENT OF ENERGY
 OIL AND GAS WELLS DIVISION

AFFIDAVIT OF PLUGGING AND FILLING WELL

AFFIDAVIT SHOULD BE MADE IN TRIPPLICATE, one copy mailed to the Division, one copy to be retained by the Well Operator and the third copy (and extra copies if required) should be mailed to each coal operator at their respective addresses.

Consolidation Coal Company
 Coal Operator or Owner
P. O. Box 1314 Morgantown, WV 26507-1314
 Address

Coal Operator or Owner
 Address
Shirley Sue Walker
 Lease or Property Owner
Box 153, Blacksville, WV 25681
 Address

Consolidation Coal Company
 Name of Well Operator
P. O. Box 1314, Morgantown, WV 26507-1314
 Complete Address

May 28 19 89

WELL AND LOCATION

Battelle District
Monongalia County

WELL NO. 3869-A

Shirley Sue Walker Farm

STATE INSPECTOR SUPERVISING PLUGGING Don Ellis, 2604 Crabapple Lane, Fairmont, WV 26554

AFFIDAVIT

STATE OF WEST VIRGINIA,
 County of Harrison

ss:

Calvin C. Lofton and George R. Gore

being first duly sworn according to law depose and say that they are experienced in the work of plugging and filling oil and gas wells and were employed by Consolidation Coal Company, well operator, and participated in the work of plugging and filling the above well, that said work was commenced on the 15th day of May, 19 89, and that the well was plugged and filled in the following manner:

Sand or Zone Record Formation	Filling Material	Plugs Used Size & Kind	Casing	
			CSG PULLED	CSG LEFT IN
Cleaned 9 7/8" hole to 27'	Reduced hole to 7 7/8"			
Cleaned 7 7/8" hole to 1,800' in hole from 1,155' to 1,800'	8 5/8" casing remaining Extreme difficulty working with 8". 8" left in coal, perforated 8" casing 30 holes in coal section. Ran coal protection string as follows: 299.85' of 2 3/8" tubing followed by 1,454.50' of 4 1/2" casing. Latch down plug at 1,434.70'. Float valve at 1,454.50'. Swedge at 1,455.30'. Circulated cement to surface as follows: Pumped 25 sacks of poz mix followed by 160 sacks of thixotropic cement. Used 1,000 gallons of mud flush. Displaced cement to 1,434.70' with water.			
Let set, bailed dry.				
Ran 7 7/8" bit thru coal seam	Ran 10" mill 1,155 feet			
TOTAL DEPTH: 1,754.35 feet				
Coal Seams Pittsburgh	1,311 feet to 1,320 feet			
(Name)			Description of Monument	
(Name)			5 feet of 4 1/2" casing with plaque stating:	
(Name)			Consol WV #3869A	
(Name)			47-061-0809-P - deleted this section	

Permit # should be 061-0917-P

11/20/91

and that the work of plugging and filling said well was completed on the 28th day of May, 19 89.
 And further deponents saith not.

Sworn to and subscribed before me this 28th day of May, 19 89.

Calvin C. Lofton
George R. Gore
Timothy L. Cook
 Notary Public

My commission expires: