

Janie 7/24/89

LATITUDE 39° 40' 00"

6,700


LONGITUDE 80° 01' 00"

001' 6"


NORTH

DIANA DEWITT

ANDY TENNANT

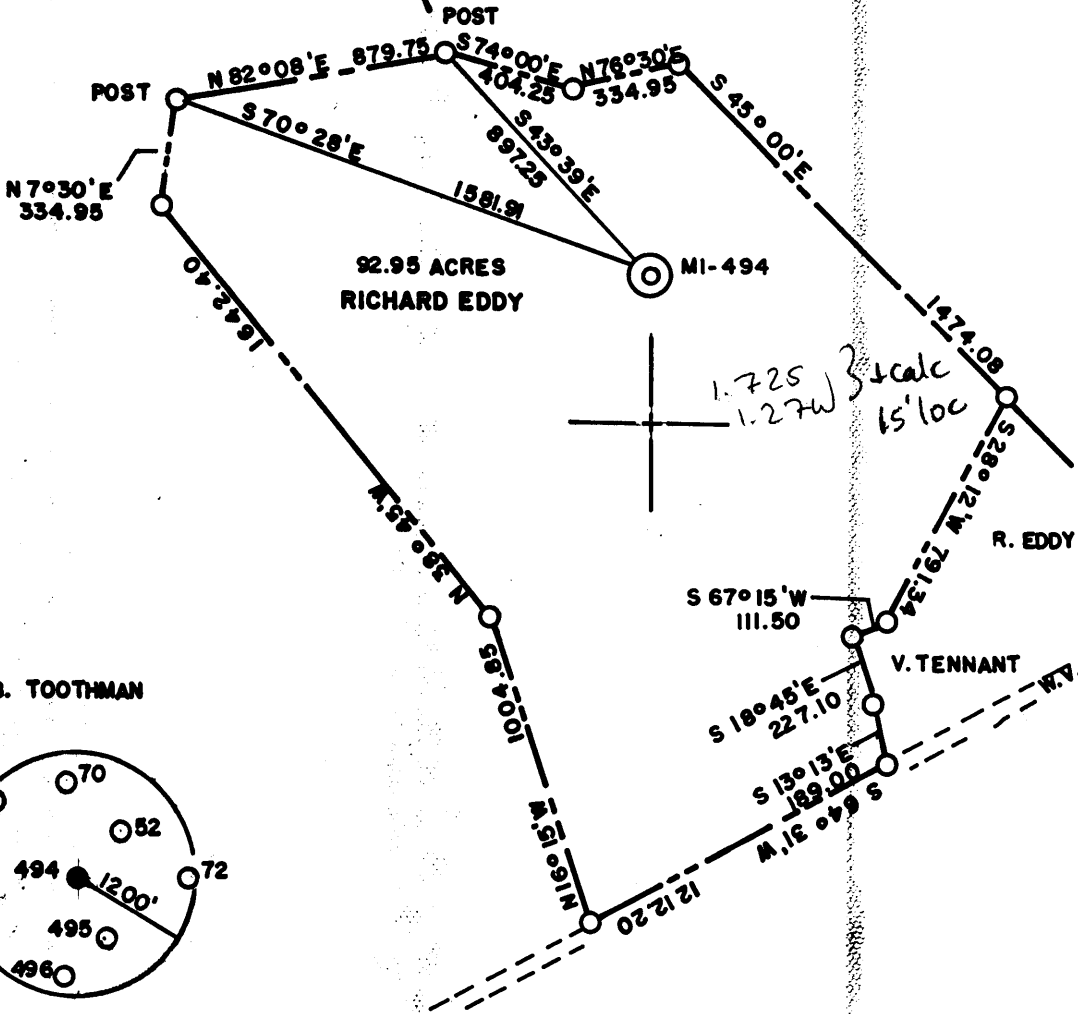


B. TOOTHMAN

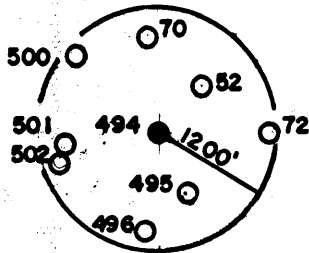

(+) DENOTES LOCATION OF WELL ON UNITED STATES TOPOGRAPHIC MAPS

FILE NO. _____
 DRAWING NO. _____
 SCALE 1" = 600'
 MINIMUM DEGREE OF ACCURACY 1 IN 5000
 PROVEN SOURCE OF ELEVATION COMPANY SURVEY TIED INTO U.S.G.S. NETWORK

I THE UNDERSIGNED, HEREBY CERTIFY THAT THIS PLAT IS CORRECT TO THE BEST OF MY KNOWLEDGE AND BELIEF AND SHOWS ALL THE INFORMATION REQUIRED BY LAW AND THE REGULATIONS ISSUED AND PRESCRIBED BY THE DEPARTMENT OF ENERGY.
 (SIGNED) R. Nelson McCoy
 R.P.E. _____ L.L.S. 110

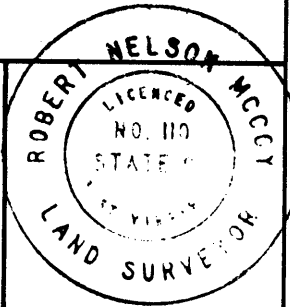

PLACE SEAL HERE

STATE OF WEST VIRGINIA
 DEPARTMENT OF ENERGY
 OIL AND GAS DIVISION



DATE APRIL 23, 19 87
 OPERATOR'S WELL NO. MI-494
 API WELL NO. _____

WELL TYPE: OIL GAS LIQUID INJECTION WASTE DISPOSAL
 (IF "GAS,") PRODUCTION STORAGE DEEP SHALLOW
 LOCATION: ELEVATION 1292.80 WATERSHED JAKES RUN
 DISTRICT CLAY COUNTY MONONGALIA
 QUADRANGLE BLACKSVILLE W.V., PA. 7.5 x 15' WC
 SURFACE OWNER RICHARD EDDY ACREAGE 92.95
 OIL & GAS ROYALTY OWNER UNKNOWN LEASE ACREAGE _____
 LEASE NO. _____

PROPOSED WORK: DRILL CONVERT DRILL DEEPER REDRILL FRACTURE OR STIMULATE PLUG OFF OLD FORMATION PERFORATE NEW FORMATION OTHER PHYSICAL CHANGE IN WELL (SPECIFY) _____

PLUG AND ABANDON CLEAN OUT AND REPLUG
 TARGET FORMATION NONE ESTIMATED DEPTH _____
 WELL OPERATOR CONSOLIDATION COAL CO. DESIGNATED AGENT ROGER E. DUCKWORTH
 ADDRESS P.O. BOX 1314 MORGANTOWN W.V. 26505 ADDRESS P.O. BOX 1314 MORGANTOWN W.V. 26505

H.T. HALL 48673 FORM WW-6

COUNTY NAME

PERMIT

STATE OF WEST VIRGINIA
DEPARTMENT OF ENERGY
OIL AND GAS WELLS DIVISION

AFFIDAVIT OF PLUGGING AND FILLING WELL

AFFIDAVIT SHOULD BE MADE IN TRIPLICATE, one copy mailed to the Division, one copy to be retained by the Well Operator and the third copy (and extra copies if required) should be mailed to each coal operator at their respective addresses.

Consolidation Coal Co.
Coal Operator or Owner
P.O. Box 1314, Morgantown, W.Va. 26507
Address

Consolidation Coal Co.
Coal Operator or Owner
P.O. Box 1314, Morgantown, W.Va. 26507
Address

Richard Eddy
Lease or Property Owner
Rt. 2 Fairview, W.Va. 26570
Address

Consolidation Coal Co.
Name of Well Operator
P.O. Box 1314, Morgantown, W.Va. 26507
Complete Address

August 24 19 89
WELL AND LOCATION

Clay District

Monongalia County

WELL NO. M1-494

Eddy Farm



STATE INSPECTOR SUPERVISING PLUGGING Don Ellis

AFFIDAVIT

STATE OF WEST VIRGINIA,
County of Monongalia ss:

Larry L. Yost and Dennis L. Yost
being first duly sworn according to law depose and say that they are experienced in the work of plugging and filling oil and gas wells and were employed by Consolidation Coal Co., well operator, and participated in the work of plugging and filling the above well, that said work was commenced on the 7th day of August, 19 89, and that the well was plugged and filled in the following manner:

Sand or Zone Record Formation	Filling Material	INDEXED ft. Size & Kind	Casing	
			CSG PULLED	CSG LEFT IN
	Cleaned wellbore to 1300 ft.			
	Pulled 322 ft. of 8 1/2" casing. Recleaned wellbore to 1412 ft. Ran coal protection string as follows; 1003 ft. of 4 1/2" casing; 409 ft. of 2 3/8" tubing; Latch down plug at 986 ft.; Float valve at 1003 ft.; Swedge at 1003 ft.	8 1/2"	322'	TOP 1125' BOTTOM ?
	Circulated cement to surface as follows; 720 sacks of Poz Mix; 300 sacks of expanding type cement; 1,000 gal. of mud flush. Let set, bailed dry, set monument.			
Coal Seams				
(Name) Pittsburgh-785 ft.				6 ft. of 4 1/2" casing with plaque stating Consol M1-494
(Name)				47-061-0926P
(Name)				
(Name)				

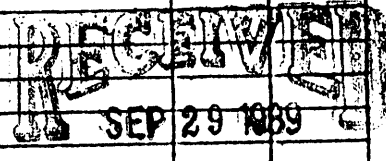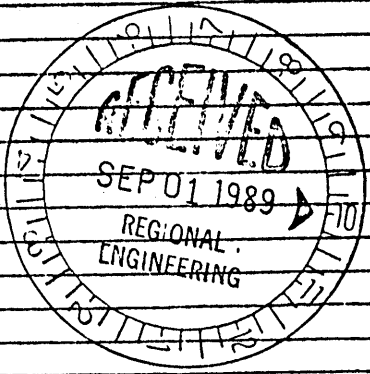

DIVISION OF OIL & GAS
DEPARTMENT OF ENERGY

10/2/89

and that the work of plugging and filling said well was completed on the 17th day of August, 19 89.

And further deponents saith not.

Sworn to and subscribed before me this 24th day of August, 19 89.

Larry Yost
Dennis Yost
Zelli H. Wilson
Notary Public

OCT 6 1989

My commission expires:
March 15, 1993

Permit No. 47-061-0926