

Jan 8/3/89


LATITUDE 39°37'30"

390 →


3720

LONGITUDE

80°17'30"

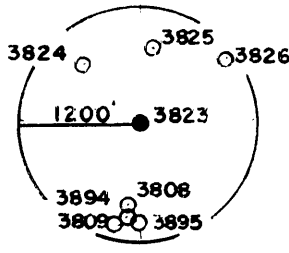

0.715
0.08w

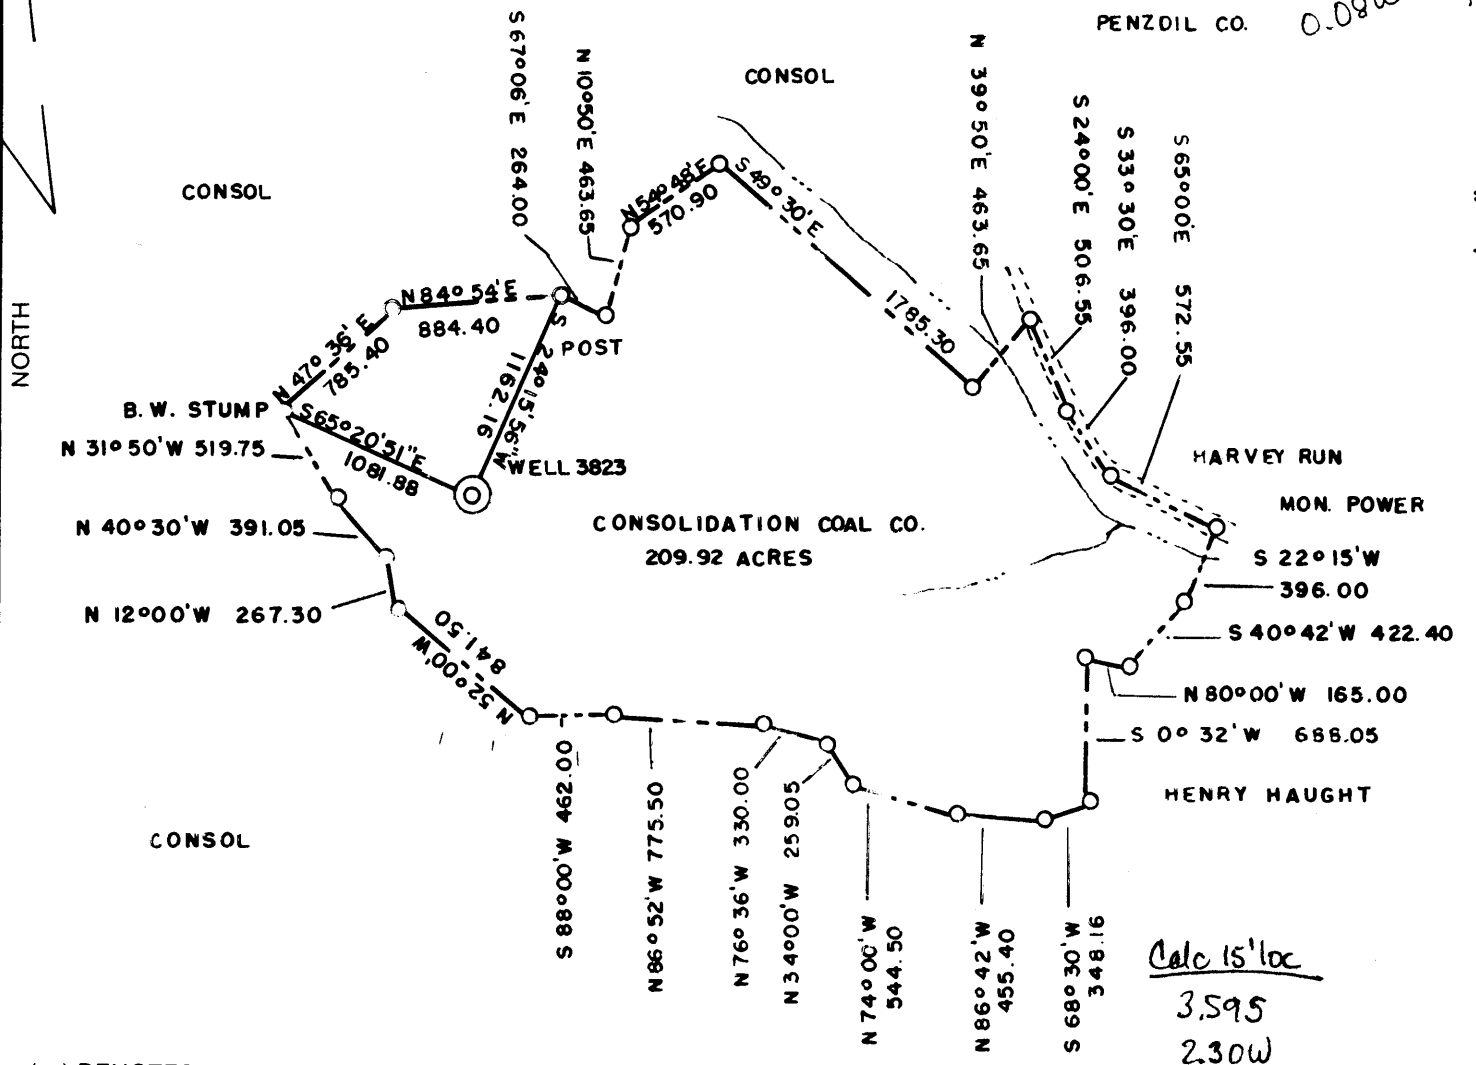

Calc 15' loc
3.595
2.30w

(+) DENOTES LOCATION OF WELL ON UNITED STATES TOPOGRAPHIC MAPS

FILE NO. _____
DRAWING NO. _____
SCALE 1" = 1000'
MINIMUM DEGREE OF ACCURACY 1 IN 5000
PROVEN SOURCE OF ELEVATION COMPANY SURVEY
TIED INTO THE U.S.G.S. NETWORK

I THE UNDERSIGNED, HEREBY CERTIFY THAT THIS PLAT IS CORRECT TO THE BEST OF MY KNOWLEDGE AND BELIEF AND SHOWS ALL THE INFORMATION REQUIRED BY LAW AND THE REGULATIONS ISSUED AND PRESCRIBED BY THE DEPARTMENT OF ENERGY.
(SIGNED) Carl Morris
R.P.E. _____ L.L.S. 460

PLACE SEAL HERE

STATE OF WEST VIRGINIA
DEPARTMENT OF ENERGY
OIL AND GAS DIVISION



DATE APRIL 27, 19 88
OPERATOR'S WELL NO. 3823
API WELL NO. _____

WELL TYPE: OIL ___ GAS ___ LIQUID INJECTION ___ WASTE DISPOSAL ___
(IF "GAS,") PRODUCTION ___ STORAGE ___ DEEP ___ SHALLOW X ABANDONED X.
LOCATION: ELEVATION 1355.61 WATERSHED PAW PAW

DISTRICT BATTELLE COUNTY MONONGALIA
QUADRANGLE MANNINGTON W.V. 15°E C

SURFACE OWNER CONSOLIDATION COAL CO. ACREAGE 209.92
OIL & GAS ROYALTY OWNER _____ LEASE ACREAGE _____

LEASE NO. _____
PROPOSED WORK: DRILL ___ CONVERT ___ DRILL DEEPER ___ REDRILL X FRACTURE OR STIMULATE ___ PLUG OFF OLD FORMATION ___ PERFORATE NEW FORMATION ___ OTHER PHYSICAL CHANGE IN WELL (SPECIFY) _____

PLUG AND ABANDON ___ CLEAN OUT AND REPLUG X
TARGET FORMATION NONE ESTIMATED DEPTH _____
WELL OPERATOR CONSOLIDATION COAL CO. DESIGNATED AGENT ROGER E. DUCKWORTH
ADDRESS P.O. BOX 1314 MORGANTOWN W.V. 26505 ADDRESS P.O. BOX 1314 MORGANTOWN W.V. 26505

H.T. HALL - 3823 FORM WW-6

COUNTY NAME

PERMIT

AFFIDAVIT OF PLUGGING AND FILLING WELL

AFFIDAVIT SHOULD BE MADE IN TRIPLICATE, one copy mailed to the Division, one copy to be retained by the Well Operator and the third copy (and extra copies if required) should be mailed to each coal operator at their respective addresses.

Consolidation Coal Company
Coal Operator or Owner
P. O. Box 1314, Morgantown, WV 26507-1314
Address

Coal Operator or Owner
Address

Consolidation Coal Company
Lease or Property Owner
P. O. Box 1314, Morgantown, WV 26507-1314
Address

Consolidation Coal Company
Name of Well Operator
P. O. Box 1314, Morgantown, WV 26507-1314
Complete Address
August 26, 1989 19 89

WELL AND LOCATION
Battelle District
Monongalia County

WELL NO. 3823
Consolidation Coal Co. Farm

STATE INSPECTOR SUPERVISING PLUGGING Don Ellis, Fairmont, WV 26554

AFFIDAVIT

STATE OF WEST VIRGINIA,
County of Harrison

ss:

Calvin C. Lofton

and

George R. Gore

being first duly sworn according to law depose and say that they are experienced in the work of plugging and filling oil and gas wells and were employed by Consolidation Coal Company, well operator, and participated in the work of plugging and filling the above well, that said work was commenced on the 12th day of August, 1989, and that the well was plugged and filled in the following manner:

Sand or Zone Record Formation	Filling Material	Plugs Used Size & Kind	Casing	
			CSG PULLED	CSG LEFT IN
Cleaned 9 7/8" hole to 270'. Reduced hole to 7/7" at 270'. Cleaned 7 7/8" hole to 394'. Reduced hole to 6 1/2" at 394'. Cleaned 6 1/2" hole from 394' to 1,563'.				
Drilled 6 1/2" hole thru Pittsburgh coal from 974' to 981'. Ran coal protection string as follows: 401.19' of 2 3/8" tubing followed by 1,137.67' of 4 1/2" casing. Latch down plug at 1,125.54'. Float valve at 1,137.67' Swedge at 1,138.67'. Circulated cement to surface as follows: Pumped 800 sacks of poz mix followed by 350 sacks of expanding cement. Used 1,000 gallons of mud flush. Displaced cement to 1,125.54' with water. Let set, bailed dry.				
TOTAL DEPTH: 1,538.86 feet.				
Coal Seams				
(Name) Pittsburgh	974' to 981'	5 feet of 4 1/2" casing with plaque stating:		
(Name)		Consol WV #3823		
(Name)		#47-061-0933-P		

RECEIVED
SEP 29 1989


DIVISION OF OIL & GAS
DEPARTMENT OF ENERGY

10/2/89

and that the work of plugging and filling said well was completed on the 16th day of August, 19 89.

And further deponents saith not.

Calvin C. Lofton
George R. Gore
Charlotte Heater
Notary Public

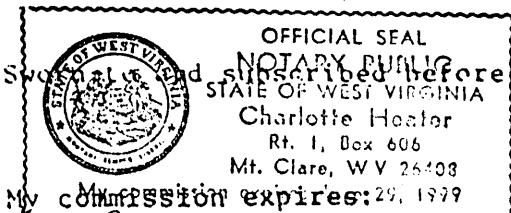

Subscribed and sworn to before me this 26th day of August, 19 89.

OCT 6 1989