

3400'


INSTRUCTIONS

LATITUDE 39° 40' 00"

1) Attach a photo copy of the location of the well on a 7.5 minute Quadrangle with the corresponding Longitude and Latitude.
 2) Designate the location of the well with the symbol(+).

LONGITUDE 80° 07' 30"

7300'

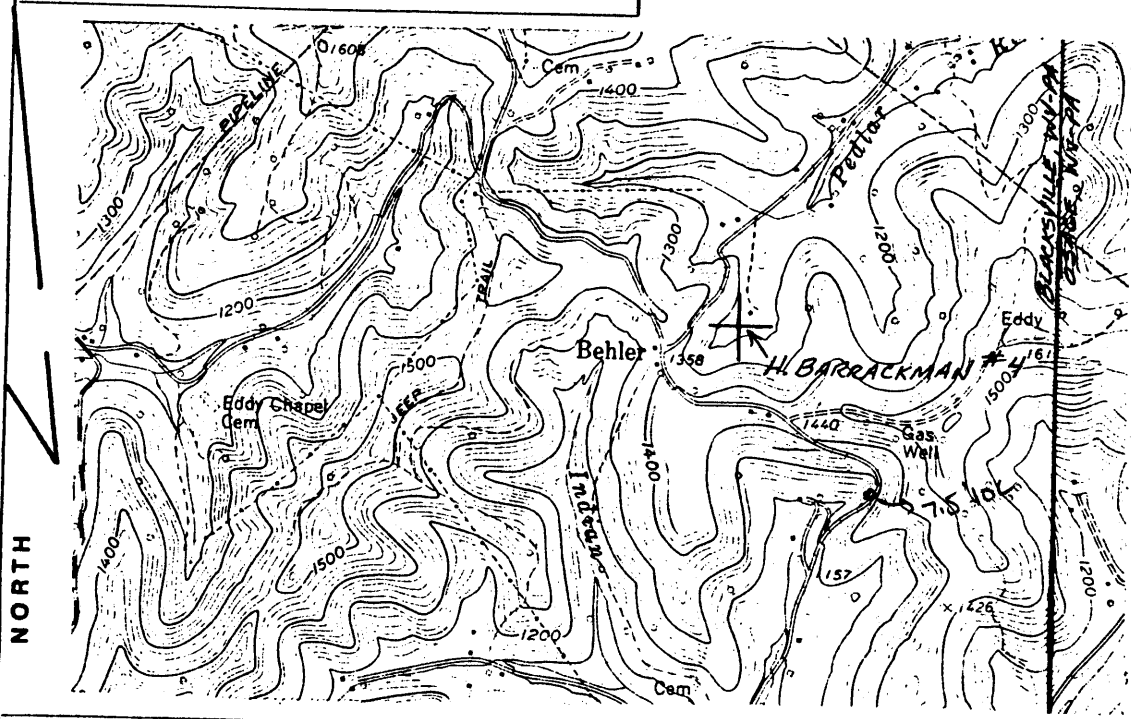

I, the undersigned, hereby certify that this plat is correct to the best of my knowledge and belief.

SIGNED Mark Eddy
 TITLE Harry Eddy
 DATE NOVEMBER 6, 1989
 OPERATORS WELL NO. H. BARRACKMAN #4
 API WELL NO. 061-0989

STATE OF WEST VIRGINIA (was 061 71389)
 DEPARTMENT OF ENERGY
 OIL AND GAS DIVISION

WELL TYPE: OIL GAS LIQUID INJECTION WASTE DISPOSAL
 (IE "GAS" PRODUCTION STORAGE DEEP SHALLOW
 LOCATION: ELEVATION 1160' WATER SHED MONONGAHELA RIVER
 DISTRICT CLAY 3 COUNTY MONONGALIA
 QUADRANGLE BLACKSVILLE, WV-PA.
 SURFACE OWNER MARK & HARRY EDDY ACREAGE 50.00 AC.
 OIL & GAS ROYALTY OWNER MARK & HARRY EDDY LEASE ACREAGE 50.00 AC.
 LEASE NO. _____
 PRODUCING FORMATION BIG INJUN TOTAL DEPTH 1800-2400'
 WELL OPERATOR MARK & HARRY EDDY DESIGNATED AGENT _____
 ADDRESS ROUTE 1, BOX 43 ADDRESS _____
CORE, WV 26529

11799

137
063