


800'

INSTRUCTIONS

LATITUDE 39° 40' 00"

1) Attach a photo copy of the location of the well on a 7.5 minute Quadrangle with the corresponding Longitude and Latitude.  
 2) Designate the location of the well with the symbol (+).

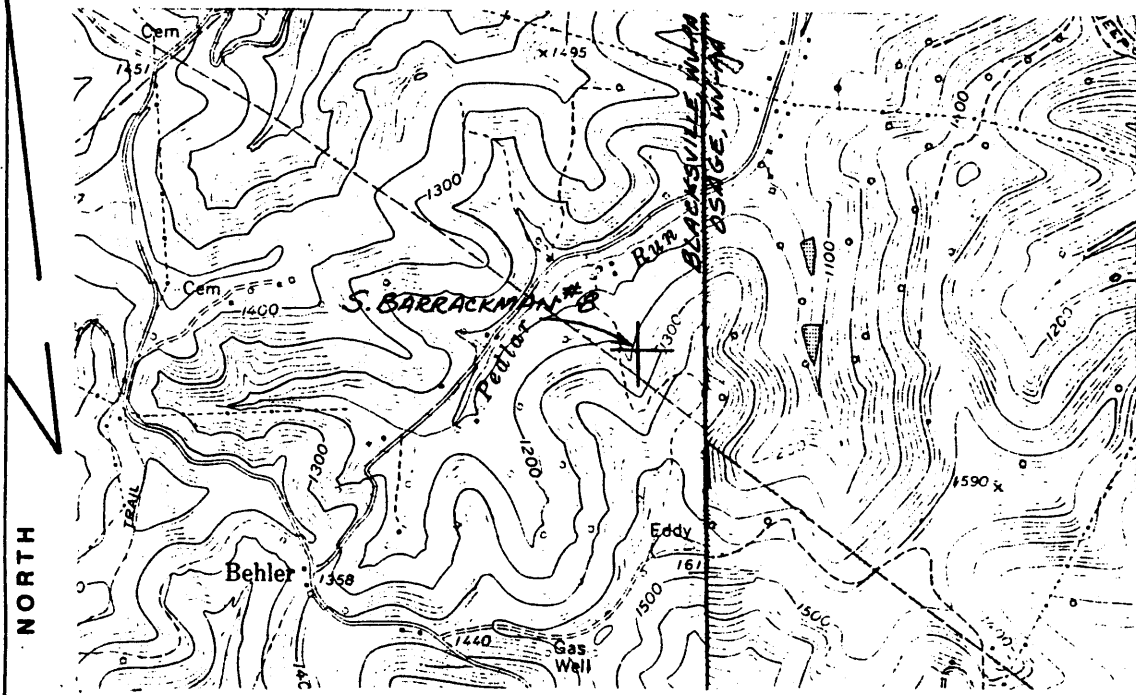

LONGITUDE 80° 07' 30"

5270'

7.5' loc

1.00  
0.15

I, the undersigned, hereby certify that this plat is correct to the best of my knowledge and belief.

SIGNED Mark Eddy

TITLE Harry Eddy

DATE NOVEMBER 6, 1989

OPERATORS WELL NO. S. BARRACKMAN

API WELL NO. 061-0991 #8

STATE OF WEST VIRGINIA  
 DEPARTMENT OF ENERGY  
 OIL AND GAS DIVISION

WELL TYPE: OIL  GAS  LIQUID INJECTION  WASTE DISPOSAL   
 (If "GAS" PRODUCTION  STORAGE  DEEP  SHALLOW

LOCATION: ELEVATION 1220' WATER SHED MONONGAHELA RIVER  
 DISTRICT CLAY 3 COUNTY MONONGALIA  
 QUADRANGLE BLACKSVILLE, WV-PA

SURFACE OWNER MARK & HARRY EDDY ACREAGE 99.00 Ac.

OIL & GAS ROYALTY OWNER MARK & HARRY EDDY LEASE ACREAGE 99.00 Ac.  
 LEASE NO. \_\_\_\_\_

PRODUCING FORMATION BIG INJUN TOTAL DEPTH 1800-2400'

WELL OPERATOR MARK & HARRY EDDY DESIGNATED AGENT \_\_\_\_\_

ADDRESS ROUTE 1, BOX 43 ADDRESS \_\_\_\_\_

CORE, WV 26529

11797

FEB 1 1991