


3280'

INSTRUCTIONS

LATITUDE 39° 40' 00"

- 1) Attach a photo copy of the location of the well on a 7.5 minute Quadrangle with the corresponding Longitude and Latitude.
- 2) Designate the location of the well with the symbol (+).

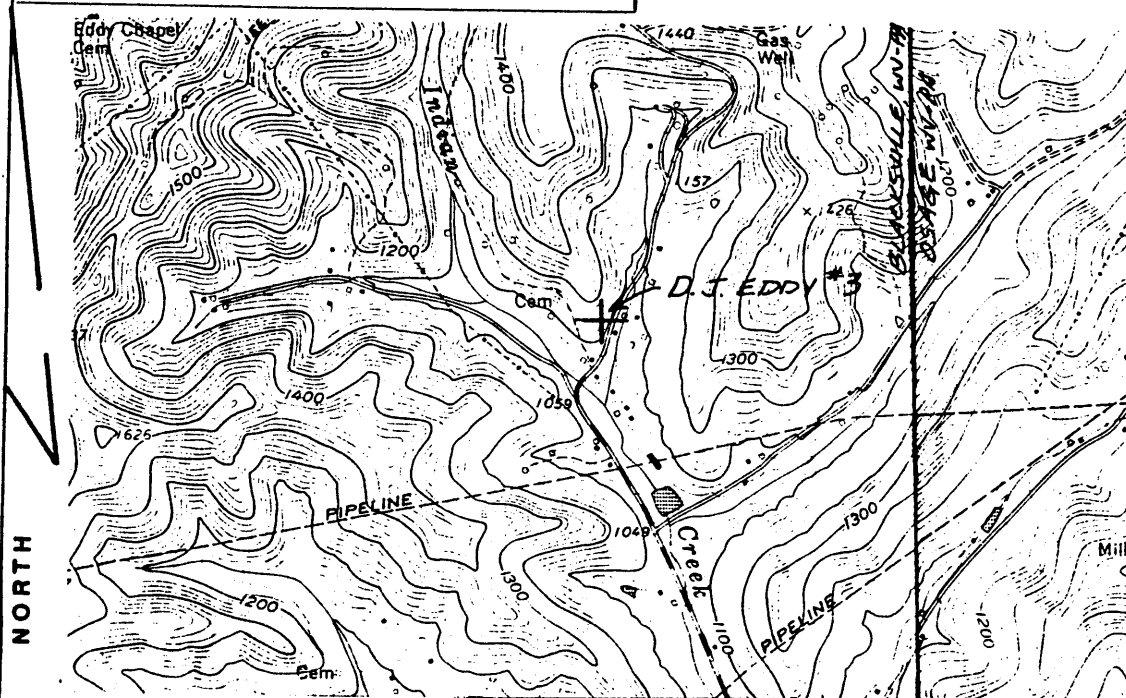

LONGITUDE 80° 07' 30"

11,230'

I, the undersigned, hereby certify that this plat is correct to the best of my knowledge and belief.

SIGNED Mark Eddy 2.135
 TITLE Harry Eddy

75' loc. DATE NOVEMBER 6, 19 89
 OPERATORS WELL NO. D.J. EDDY #3
 API WELL NO. 061-0993

STATE OF WEST VIRGINIA
 DEPARTMENT OF ENERGY
 OIL AND GAS DIVISION

WELL TYPE: OIL GAS LIQUID INJECTION WASTE DISPOSAL
 (IF "GAS" PRODUCTION STORAGE DEEP SHALLOW

LOCATION: ELEVATION 1130' WATER SHED MONONGAHELA RIVER
 DISTRICT CLAY 3 COUNTY MONONGALIA
 QUADRANGLE BLACKSVILLE WV-PA

SURFACE OWNER MARK & HARRY EDDY ACREAGE 209.00 AC.
 OIL & GAS ROYALTY OWNER MARK & HARRY EDDY LEASE ACREAGE 209.00 AC.
 LEASE NO. _____

PRODUCING FORIATION BIG INJUN TOTAL DEPTH 1800-2400'

WELL OPERATOR MARK & HARRY EDDY DESIGNATED AGENT -

ADDRESS ROUTE 1, BOX 43 ADDRESS -
CORE, WV 26529

11795-