


Jamie
9/23/91

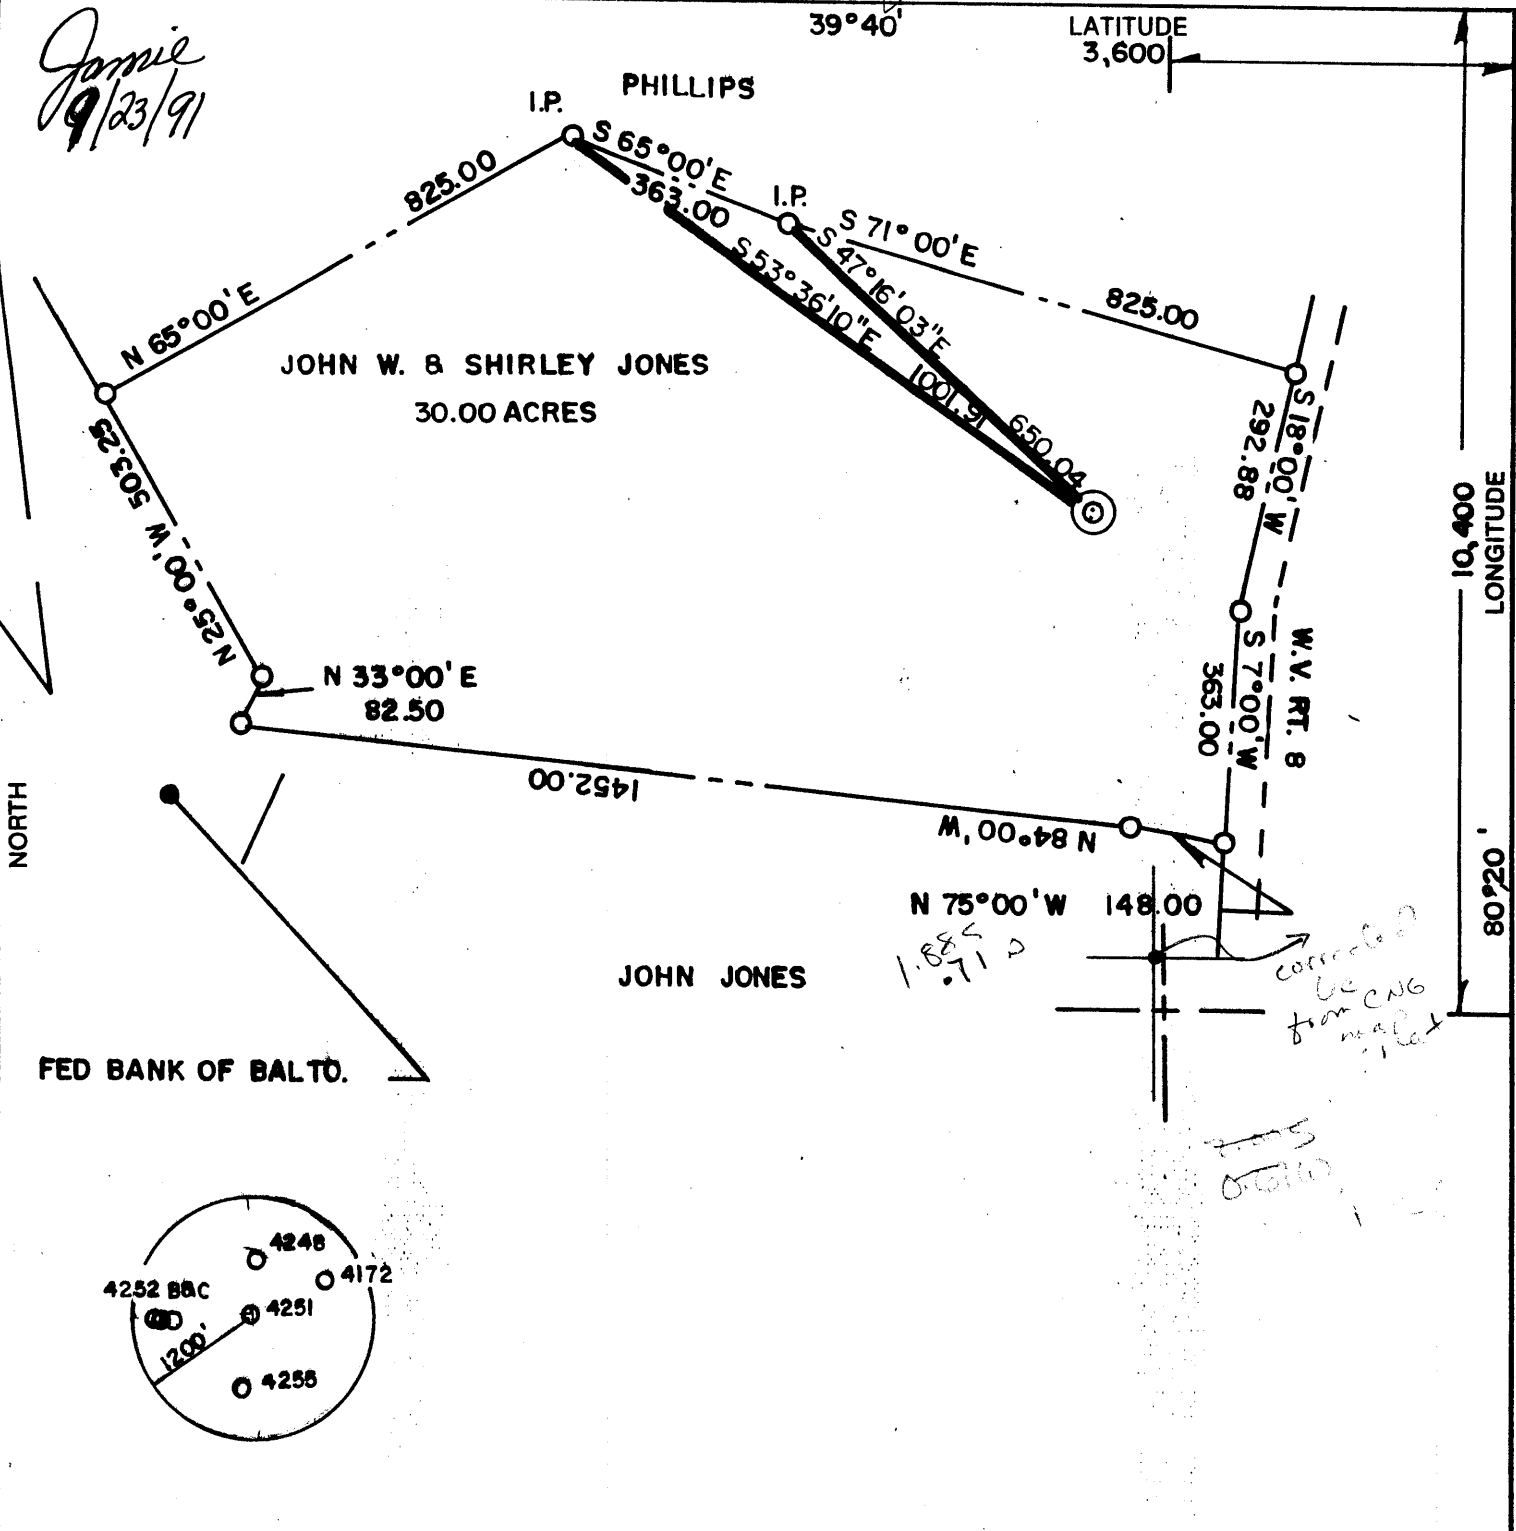


FED BANK OF BALTO.

(+) DENOTES LOCATION OF WELL ON UNITED STATES TOPOGRAPHIC MAPS

FILE NO. _____
 DRAWING NO. _____
 SCALE 1" = 300'
 MINIMUM DEGREE OF ACCURACY 1 IN 5000
 PROVEN SOURCE OF ELEVATION COMPANY SURVEY
TIED INTO U.S.G.S. NETWORK

I THE UNDERSIGNED, HEREBY CERTIFY THAT THIS PLAT IS CORRECT TO THE BEST OF MY KNOWLEDGE AND BELIEF AND SHOWS ALL THE INFORMATION REQUIRED BY LAW AND THE REGULATIONS ISSUED AND PRESCRIBED BY THE DEPARTMENT OF ENERGY.
 (SIGNED) Paul D. Harbert
 R.P.E. _____ L.L.S. 862

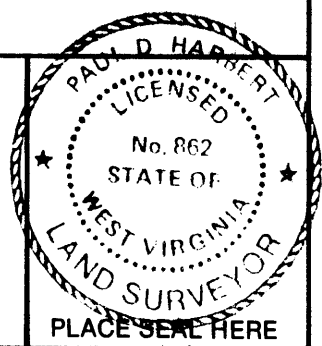

STATE OF WEST VIRGINIA
 DEPARTMENT OF ENERGY
 OIL AND GAS DIVISION

DATE 9-13, 19 91
 OPERATOR'S WELL NO. 4251
 API WELL NO. 47-61-01041-P

WELL TYPE: OIL ___ GAS ___ LIQUID INJECTION ___ WASTE DISPOSAL ___
 (IF "GAS,") PRODUCTION ___ STORAGE ___ DEEP ___ SHALLOW ___ ABANDONED X

LOCATION: ELEVATION 1122.8 WATER SHED RANGE RUN
 DISTRICT BATTELLE COUNTY MONONGALIA
 QUADRANGLE WADESTOWN W.V., PA.

SURFACE OWNER JOHN W. & SHIRLEY JONES ACREAGE 30.00
 OIL & GAS ROYALTY OWNER _____ LEASE ACREAGE _____
 LEASE NO. _____

PROPOSED WORK: DRILL ___ CONVERT ___ DRILL DEEPER ___ REDRILL ___ FRACTURE OR STIMULATE ___ PLUG OFF OLD FORMATION ___ PERFORATE NEW FORMATION ___ OTHER PHYSICAL CHANGE IN WELL (SPECIFY) _____

PLUG AND ABANDON ___ CLEAN OUT AND REPLUG X
 TARGET FORMATION NONE ESTIMATED DEPTH _____
 WELL OPERATOR CONSOLIDATION COAL CO. DESIGNATED AGENT ROGER E DUCKWORTH
 ADDRESS P.O. BOX 1314 MORGANTOWN W.V. 26505 ADDRESS P.O. BOX 1314 MORGANTOWN W.V. 26505

SEP 30 1991

FORM WW-6
 068065
 HALLS INC.

LONGITUDE 10,400
 80°20'

COUNTY NAME
 PERMIT

RECEIVED
 Office of Oil & Gas
 AUG 12 1992
 Division, Environmental Protection

AFFIDAVIT OF PLUGGING AND FILLING WELL

AFFIDAVIT SHOULD BE MADE IN TRIPLICATE, one copy mailed to the Division, one copy to be retained by the Well Operator and the third copy (and extra copies if required) should be mailed to each coal operator at their respective addresses.

Consolidation Coal Company
 Coal Operator or Owner
 P. O. Box 1314, Morgantown, WV 26507
 Address

Consolidation Coal Company
 Name of Well Operator
 P. O. Box 1314, Morgantown, WV 26507
 Complete Address

Coal Operator or Owner
 Address

January 17, 1991
 WELL AND LOCATION
 Battelle District
 Monongalia County

Lease or Property Owner
 John W. Jones
 Address
 Route 1, Box 20, Wadestown, WV 26589

WELL NO. 4251
 John W. Jones Farm

STATE INSPECTOR SUPERVISING PLUGGING Don Ellis, Fairmont, WV 26554

AFFIDAVIT

STATE OF WEST VIRGINIA,
 County of Harrison

ss:

Calvin C. Lofton and Kevin Wright

being first duly sworn according to law depose and say that they are experienced in the work of plugging and filling oil and gas wells and were employed by Consolidation Coal Company, well operator, and participated in the work of plugging and filling the above well, that said work was commenced on the 2nd day of January, 1992, and that the well was plugged and filled in the following manner:

Sand or Zone Record Formation	Filling Material	Plugs Used Size & Kind	Casing	
			CSG PULLED	CSG LEFT IN
Cleaned 9 7/8" hole to 812' and cleaned 7 7/8" hole to 1,398'. Cleaned 6 1/2" hole to 1,527.04'	Reduced hole to 7 7/8" and 6 1/4" and Cleaned 7 7/8" hole thru Pittsburgh coal from 954.41' to 961.7'. Left 10" casing in hole from 188' to 208'. Pulled 8" casing from 891' to 1,268'. Left 8" casing in hole from 1,208' to 1,342'. Left 7" casing in hole from 1,398' to 1,527.04'. Ran mine protection string as follows: 326.16' of 2" tubing followed by 1,145.40' of 4 1/4" casing. Cemented hole from 1,527.04' back to surface. Latch down plug at 1,101.28'. Float valve at 1,145.40'. Swedge at 1,140.40'. Circulated cement to surface as follows: Pumped 480 sacks of poz mix followed by 275 sacks of thixotropic cement. Used 1,000 gallons of mud flush. Displaced cement to 1,101.28' with water. Let set and bailed dry. TOTAL DEPTH: 1,527.04'			
Coal Seams		Description of Monument		
(Name) Pittsburgh	954.40' to 961.7'	5 feet of 4 1/4" casing with plaque stating: Consol WV #3713 Permit #47-061-01041-P		

and that the work of plugging and filling said well was completed on the 7th day of January, 1992.

And further deponents saith not.

Sworn to and subscribed before me this 17th day of January

Kevin Wright
Calvin C. Lofton
 AUG 21 1992
 OFFICIAL SEAL
 NOTARY PUBLIC
 STATE OF WEST VIRGINIA
 Charlotte Foster
 Notary Public
 My commission expires
 Permit No. 47-061-01041-P

My commission expires:

June 29, 1999