
. 00 13, LONGITUDE 80°

4,150


NORTH

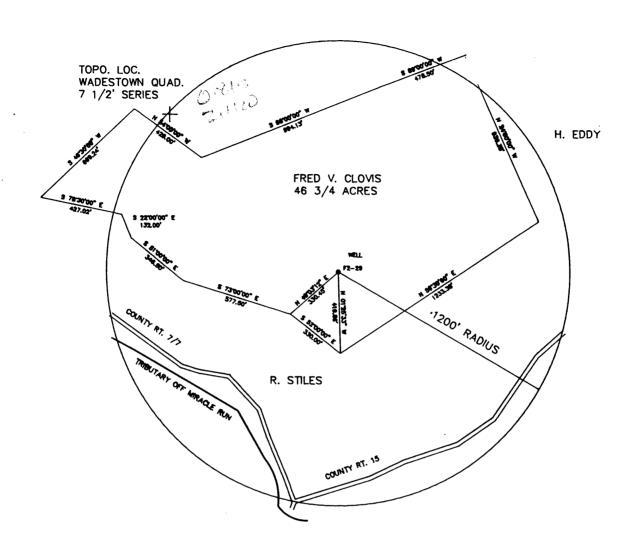

3,69 2.110

FILE NO. <u>F2-1-19</u>5 DRAWING NO. F2-2-230 SCALE 1'' = 500'MINIMUM DEGREE OF ACCURACY 1/2500' PROVEN SOURCE OF ELEVATION \_ USGS B.M.

I THE UNDERSIGNED, HEREBY CERTIFY THAT THIS PLAT IS CORRECT TO THE BEST OF MY KNOWLEDGE AND BELIEF AND SHOWS ALL THE INFORMATION REQUIRED BY LAW AND THE REGULATIONS ISSUED AND PRESCRIBED BY THE DEPARTMENT OF MINES. Ewel 7 (SIGNED) Ŕ.P/.E

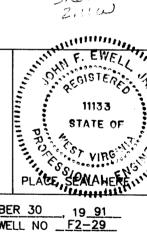

(+) DENOTES LOCATION OF WELL ON UNITED STATES TOPPGRAPHIC MAPS

FORM IV-6

(8-78)

STATE OF WEST VIRGINIA DEPARTMENT OF MINES OIL AND GAS DIVISION

OCTOBER 30 DATE. OPERATOR'S WELL NO \_F2-29 API WELL NO.

1043-1  $\frac{47}{\text{STATE}} - \frac{061}{\text{COUNTY}} -$ PERMIT

WELL TYPE: OIL X GAS LIQUID INJECTION WASTE DISPOSAL (IF"GAS", PRODUCTION STORAGE DEEP SHALLOW X
LOCATION: ELEVATION 1239 WATERSHED RIGHT BRANCH OF MIRACLE RUN
DISTRICT_BATTELLE COUNTY_MONONGALIA
QUADRANGLE WADESTOWN
SURFACE OWNER FRED F. CLOVIS ACREAGE 228
OIL & GAS ROYALTY OWNER FORMERLY SPOC. LEASE ACREAGE N/A
LEASE NON/A
PROPOSED WORK: DRILL CONVERT DRILL DEEPER REDRILL X FRACTURE OR
STIMULATEPLUG OFF OLD FORMATIONPERFORATE NEW
FORMATIONOTHER PHYSICAL CHANGE IN WELL (SPECIFY)
PLUG AND ABANDON_XCLEAN OUT AND REPLUG
TARGET FORMATION BIG INJUN ESTIMATED DEPTH 1943
WELL OPERATOR EASTERN ASSOC. COAL DESIGNATED AGENT TERRY O. HENDERSHOT
ADRESS ROUTE 1 BOX 144 ADRESS ROUTE 1 BOX 144
FAIRVIEW WV. 26570 FAIRVIEW WV. 26570

## STATE OF WEST VIRGINIA DIVISION OF ENVIRONMENTAL PROTECTION SECTION OF OIL AND GAS

## AFFIDAVIT OF PLUGGING AND FILLING WELL

AFFIDAVIT SHOULD BE IN TRIPLICATE, one copy mailed to the Division, one copy to be retained by the Well Operator and the third copy (and extra copies if required) should be mailed to each coal operator at their respective addresses.

Farm name: CLOVIS, FRED (HARKER #2) Operator Well No.:F2-29

					A CONTRACTOR	and the state of t	**************************************	
LOCATION:	Elevation:	1239.00	Quadra	ngle:	WADESTO	WN		
	District:	BATTELLE			County	MONONGA	LIA	
	Latitude:	4150 Feet	t South	of 39	9 Deg.	42 Min.	30 Sec.	
	Latitude: Longitude	11100 Feet	t West	of 8	O Deg. :	l5 Min.	O Sec.	
Well Type:	OIL X	GAS	-					
Company: Ea	stern Assoc. C	Coal Corp.		Coal	Operator	Factorn	Acces - Co-1	•
Ro	ute 1 - Box 14	.4		or O	wner	Route 1	Assoc. Coal - Box 144	Corp.
Fa	irview, WV 26	570				Fairviev	v, WV 26570	
Agont. To:	O H1	•						
Agent: Te	iry O. Henders	not	-	or O	Operator	·		
Permit Issu	ed: 11/08/93	1		01 01	WITEL			
			AFFIDAV	<i>7</i> T TT				
STATE OF WE	ST VIRGINIA	,						
County of 1	Monongalia	_ ss:						
			•					
first duly	eg Packs	edina to la	and	Danı	y Stoneki	ng	b	eing
in the work	k of pluggir	ng and fill	iw depos	se and	say tna	t they a	are experie	nced
the above	named well	operator.	and pa	artici	inated ir	i the wor	rk of plua	~ : ~ ~
and filling Gas Inspect	g the above	well, and	Randy	Mick	-puttu II	#01	oil	and
Gas Inspect	tor repres	senting th	e Dire	ctor	, say t	hat sa	id work	was
commenced	on the _	23rd	day of	Janua	ırv	_, 1992,	, and that	
commenced the well wa	as plugged	and fille	ed in t	he fo	ollowing	manner:	<b>}</b>	
111	out to depth o	FROM	ı	TO	PIPE	REMOVE	) LEFT	
Run Gamma	Ray, Neutron	and 6 Arm C	T		-		_	
Run 4½" 1	pipe to 1343	Gelled hol	e with 13	) eke	- 11			
Run 300 s	pipe to 1343 sks. Portland,	150 sks. Ch	em. Comp.	. ceme	ent and pu	lled 4½" t	0 10681	
Run 750 s	sks. Portland latch down, pl	and 150 sks.	Chem. Co	omp., c	ement. ci	rculated.	<u> </u>	<del></del>
Railed wa	ater out insid	ug to 1048'.	_					
	ter out ms u	e 42 and che	ecked bit	ıg (	<u> </u>	10.1	_{	
Pittsburg	gh Coal 940' t	0 948'.			_	1/1/	= 1 3/3×103	
		/,1,1	" x 2" sv	edge,	metal plan	te with AP	T#	!
Descrip	otion of mon	lument: and	la atch h	hannu			< <i>J</i>	
and the	ic the work	or brada	ing and	1111	ing said	well wa	s complete	d on
	lay of Feb	ruary	_, 1992	<b>_•</b>				
And furthur	deponents s	aith not.			naan 1	Dales		
	<del>-</del>			9		00	A.	<del></del>
C			1		January	Ton	King	
Sworn and su	DSCribe bet	ore me thi	5 20Th	_ day	of	Febru	199 , 199	2
My commissio	m expires 2	fere ( / C)	77	10/0	nen I	1 1	000	
	V			$\omega_{\nu}$	Marie A	Otary Pu	blic	
				$\mathcal{L}$	0	ocary ru		≈ \$ ± ± 3
	Oil an	d Gas Insp	ector:	_ka	ndal ir	nuch	THE COLUMN TWO IS NOT	
				7		-	<del></del>	
	1 - 1	ļi v						
				,	E STATE OF THE STA	'	· .	