


Jamie
3/6/92

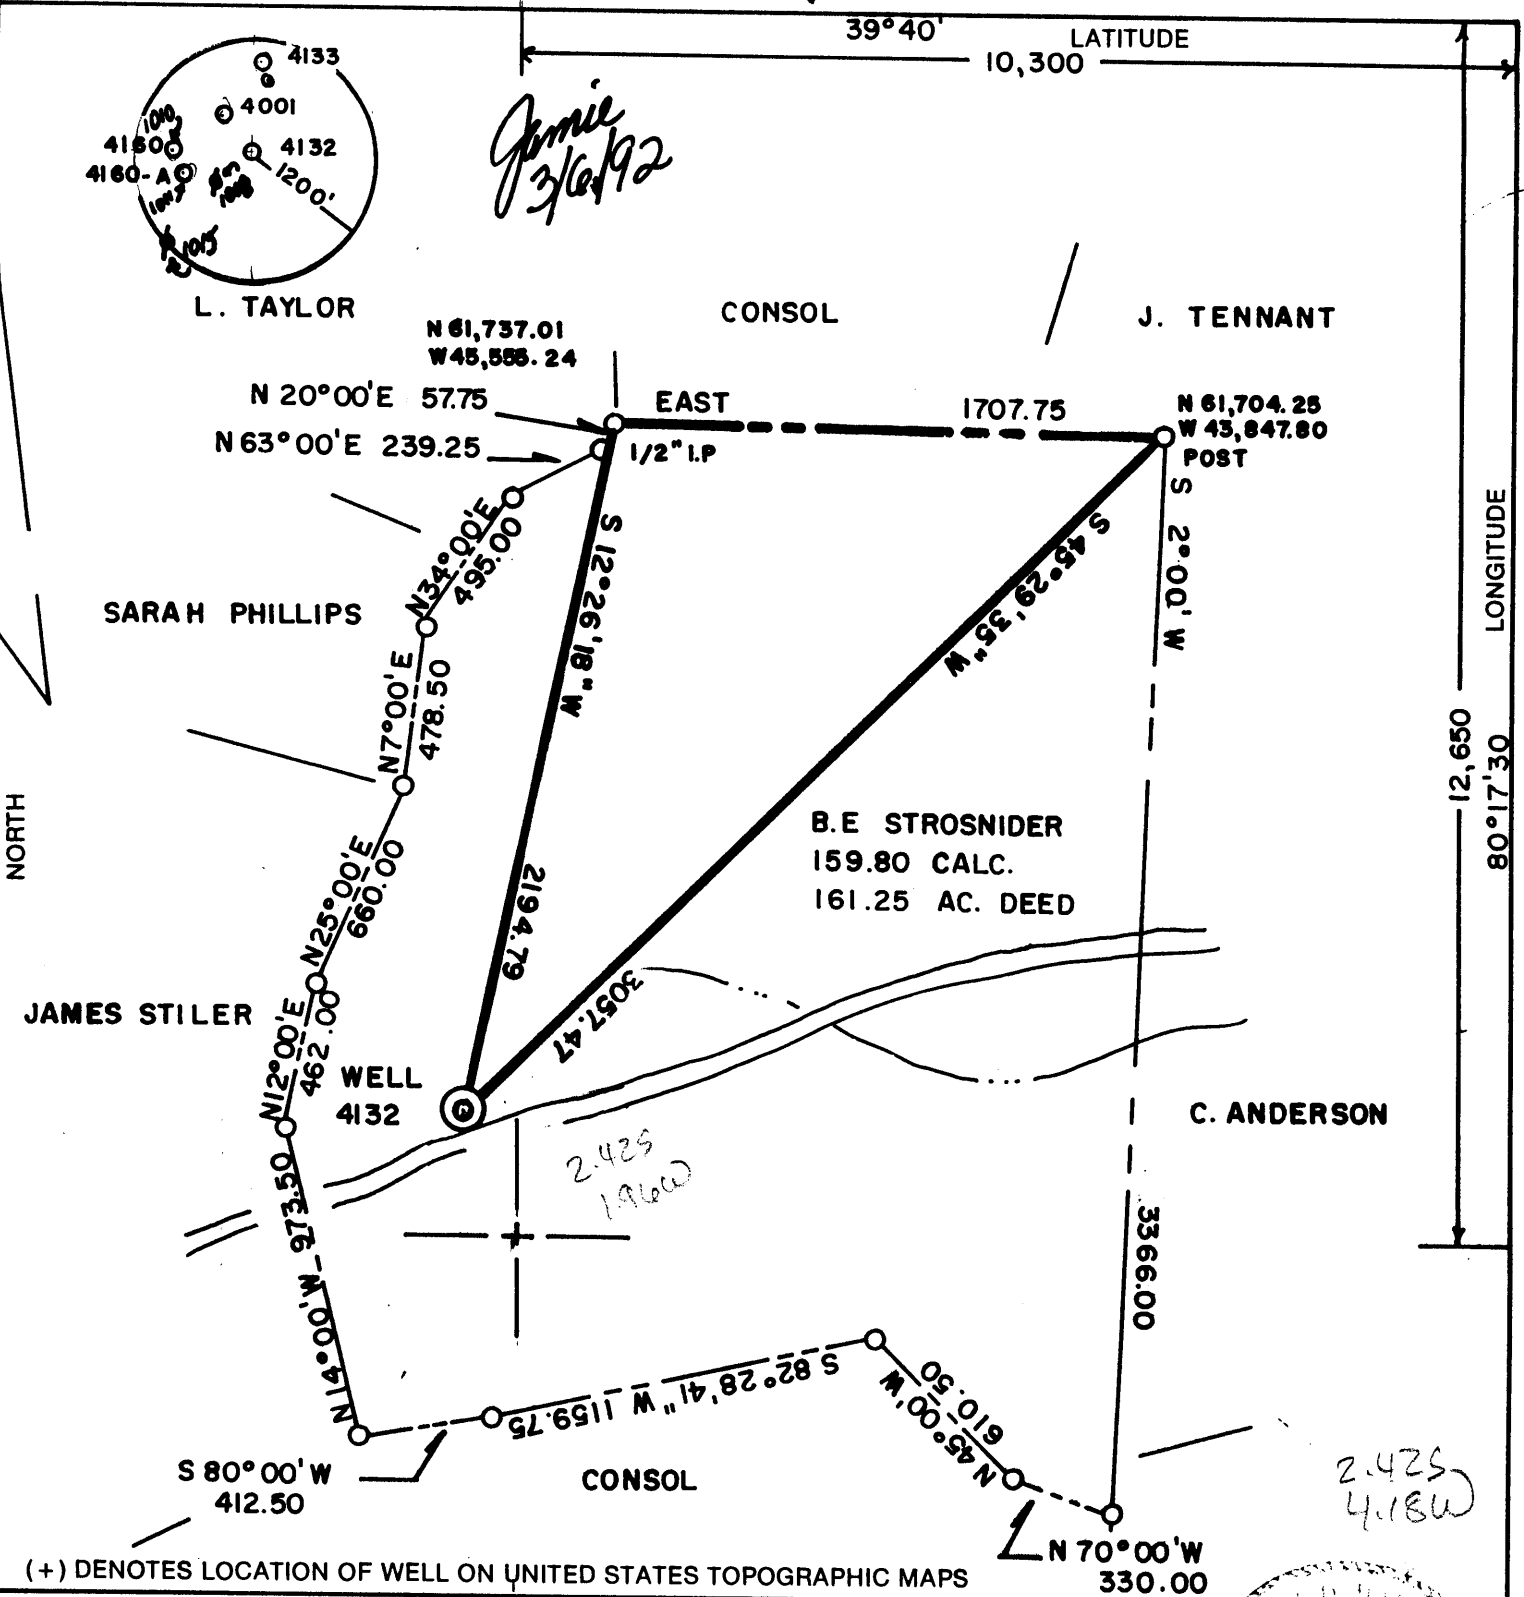

FILE NO. _____
 DRAWING NO. _____
 SCALE 1" = 600'
 MINIMUM DEGREE OF ACCURACY 1 IN 5000
 PROVEN SOURCE OF ELEVATION COMPANY SURVEY
 TIED INTO U.S.G.S. NETWORK

I THE UNDERSIGNED, HEREBY CERTIFY THAT THIS PLAT IS CORRECT TO THE BEST OF MY KNOWLEDGE AND BELIEF AND SHOWS ALL THE INFORMATION REQUIRED BY LAW AND THE REGULATIONS ISSUED AND PRESCRIBED BY THE DEPARTMENT OF ENERGY.
 (SIGNED) *Paul D. Herbert*
 R.P.E. _____ L.L.S. 862

PLACE SEAL HERE

STATE OF WEST VIRGINIA
 DEPARTMENT OF ENERGY
 OIL AND GAS DIVISION



DATE 2-22, 19 90
 OPERATOR'S WELL NO. 4132
 API WELL NO. 47 61 1064-P
 STATE COUNTY PERMIT

WELL TYPE: OIL ___ GAS ___ LIQUID INJECTION ___ WASTE DISPOSAL ___
 (IF "GAS,") PRODUCTION ___ STORAGE ___ DEEP ___ SHALLOW X ABANDONED X
 LOCATION: ELEVATION 1402.44 WATERSHED MIRACLE RUN
 DISTRICT BATTELLE COUNTY MONONGALIA
 QUADRANGLE WADESTOWN W.V., PA.

SURFACE OWNER B.E. STROSNIDER ACREAGE 161.25
 OIL & GAS ROYALTY OWNER _____ LEASE ACREAGE _____

PROPOSED WORK: DRILL ___ CONVERT ___ DRILL DEEPER ___ REDRILL ___ FRACTURE OR STIMULATE ___ PLUG OFF OLD FORMATION ___ PERFORATE NEW FORMATION ___ OTHER PHYSICAL CHANGE IN WELL (SPECIFY) _____

PLUG AND ABANDON ___ CLEAN OUT AND REPLUG X
 TARGET FORMATION NONE ESTIMATED DEPTH _____
 WELL OPERATOR CONSOLIDATION COAL CO. DESIGNATED AGENT ROGER E. DUCKWORTH
 ADDRESS P.O. BOX 1314 MORGANTOWN W.V. 26505 ADDRESS P.O. BOX 1314 MORGANTOWN W.V. 26505

FORM WW-6
 H.T. HALL 48673

LONGITUDE 80°17'30" 12,650

COUNTY NAME

PERMIT

MAR 6 1990

AFFIDAVIT OF PLUGGING AND FILLING WELL

AFFIDAVIT SHOULD BE MADE IN TRIPLICATE, one copy mailed to the Division, one copy to be retained by the Well Operator and the third copy (and extra copies if required) should be mailed to each coal operator at their respective addresses.

Consolidation Coal Company
Coal Operator or Owner
P.O. ox 1314, Morgantown, WV 26507-1314
Address

Consolidation Coal Company
Name of Well Operator
P.O. Box 1314, Morgantown, WV 26507-1314
Complete Address

Coal Operator or Owner
Address

april 27, 19 92
WELL AND LOCATION

B. E. Strosnider
Lease or Property Owner
6250 Sherman Terrace, Mason, Ohio 45040
Address

Battelle District
Monongalia County
WELL NO. 4132

B. E. Strosnider Farm

STATE INSPECTOR SUPERVISING PLUGGING

Randal Mick

AFFIDAVIT

STATE OF WEST VIRGINIA,
County of Harrison ss:

Calvin C. Lofton and George R. Gore

being first duly sworn according to law depose and say that they are experienced in the work of plugging and filling oil and gas wells and were employed by Consolidation Coal Comany, well operator, and participated in the work of plugging and filling the above well, that said work was commenced on the 17th day of March, 19 92, and that the well was plugged and filled in the following manner:

Sand or Zone Record Formation	Filling Material	Plugs Used Size & Kind	Casing	
			CSG PULLED	CSG LEFT IN
Cleaned 9 7/8" hole to 664' and cleaned 7 7/8" hole to 1,550'. Reamed 12 1/4" hole to 1,070', washed over 8" from 1,072' to 1,092'. Pulled 47' of 8". Total 8" pulled 467 feet. Eight inch ripped and tore up, shot 1,380' 40 times in coal seam. Pittsburgh coal from 1,17' to string as follows: 126.18' of 4 1/2" casing cemented coal protection string from 1,523.97' back to surface using 1,000 sacks of poz mix and 160 sacks of thixotropic cement. Used 1000 gallons of mud flush. Displaced cement to 1,366.58' with water, let set and bailed dry. Cement did circulate.	Reduced hole to 7 7/8" and Pulled 420' of 8" casing. Total 8" pulled 467 feet. Eight 8" casing from 1,170' to 1,204'. Ran coal protection 2" tubing followed by 1,397.79' Latch down plug at 1,366.58' Float valve at 1,397.79' Swedge at 1,398.79'			
TOTAL DEPTH: 1,550 feet				8/2/93
Coal Seams			Description of Monument	
(Name) Pittsburgh	1,197 feet to 1,204 feet		8' of 4 1/2" casing with plaque stating: Consol WV #4132 Permit #47-061-1064-P	

and that the work of plugging and filling said well was completed on the 9th day of April, 19 92.

And further deponents saith not.

Sworn to and subscribed before me this

My commission expires:

Calvin C. Lofton
NOTARY PUBLIC
STATE OF WEST VIRGINIA
129 Grand
Bridgeport, WV 26330
My commission expires June 29, 1999
AUG 06 1993
061-1064-P
Permit No. 47-061-1064-P