

LATITUDE 39°45'00"

80°07'30"

LONGITUDE

75'
+
1070P

7'5 OGIS topo location

7.5' loc	<u>2.525</u>	15' loc	<u>2.825</u>
	<u>1.164W</u>	(calc.)	<u>3.860</u>

Company _____

Farm _____

Quad Blacksuille NC


County Monongalia

District Clay

WELL LOCATION MAP

File No. OGW-1070P

April 31/92

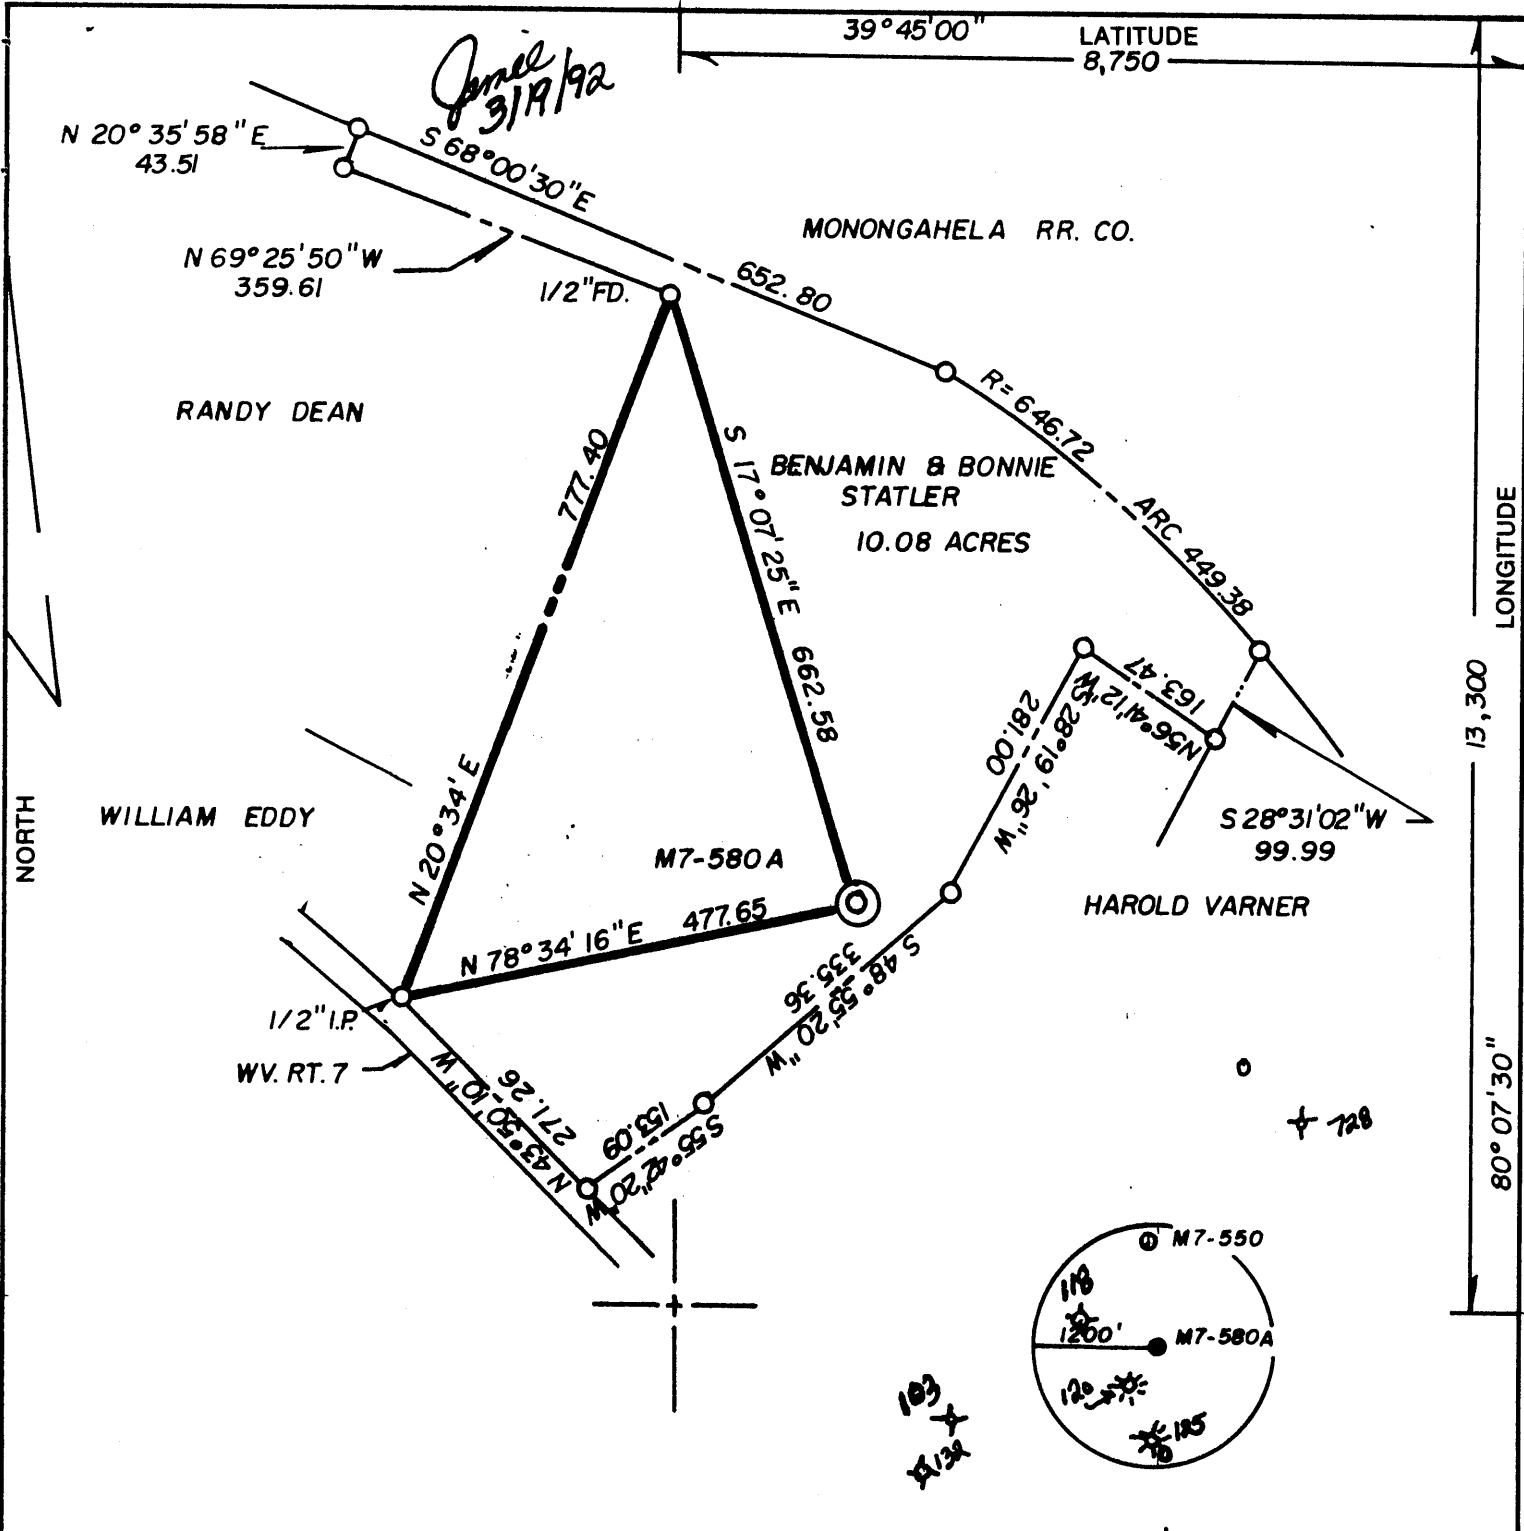

FILE NO. _____
 DRAWING NO. _____
 SCALE 1" = 200'
 MINIMUM DEGREE OF ACCURACY 1 IN 5000
 PROVEN SOURCE OF ELEVATION COMPANY SURVEY TIED INTO U.S.G.S. NETWORK

I THE UNDERSIGNED, HEREBY CERTIFY THAT THIS PLAT IS CORRECT TO THE BEST OF MY KNOWLEDGE AND BELIEF AND SHOWS ALL THE INFORMATION REQUIRED BY LAW AND THE REGULATIONS ISSUED AND PRESCRIBED BY THE DEPARTMENT OF ENERGY.
 (SIGNED) Paul D. Harbert
 R.P.E. _____ L.L.S. 862

PLACE SEAL HERE

STATE OF WEST VIRGINIA
 DEPARTMENT OF ENERGY
 OIL AND GAS DIVISION

DATE 1-17, 19 92
 OPERATOR'S WELL NO. M7-580A
 API WELL NO. 47-061-1070-P

WELL TYPE: OIL ___ GAS ___ LIQUID INJECTION ___ WASTE DISPOSAL ___
 (IF "GAS,") PRODUCTION ___ STORAGE ___ DEEP ___ SHALLOW X ABANDONED X

LOCATION: ELEVATION 998.6 WATERSHED DUNKARD CREEK
 DISTRICT CLAY COUNTY MONONGALIA
 QUADRANGLE BLACKSVILLE WV, PA

SURFACE OWNER BENJAMIN & BONNIE STATLER ACREAGE 10.08
 OIL & GAS ROYALTY OWNER _____ LEASE ACREAGE _____
 LEASE NO. _____

PROPOSED WORK: DRILL ___ CONVERT ___ DRILL DEEPER ___ REDRILL ___ FRACTURE OR STIMULATE ___ PLUG OFF OLD FORMATION ___ PERFORATE NEW FORMATION ___ OTHER PHYSICAL CHANGE IN WELL (SPECIFY) _____

PLUG AND ABANDON ___ CLEAN OUT AND REPLUG X
 TARGET FORMATION NONE ESTIMATED DEPTH _____
 WELL OPERATOR CONSOLIDATION COAL CO. DESIGNATED AGENT ROGER E. DUCKWORTH
 ADDRESS P.O. BOX 1314 MORGANTOWN WV. 26505 ADDRESS P.O. BOX 1314 MORGANTOWN WV 26505

FORM WW-6

LONGITUDE 13,300
80° 07' 30"

AFFIDAVIT OF PLUGGING AND FILLING WELL

AFFIDAVIT SHOULD BE MADE IN TRIPLICATE, one copy mailed to the Division, one copy to be retained by the Well Operator and the third copy (and extra copies if required) should be mailed to each coal operator at their respective addresses.

Consolidation Coal Company
Coal Operator or Owner
P. O. Box 1314, Morgantown, WV 26507-1314
Address

Coal Operator or Owner
Address
Benjamin Statler
Lease or Property Owner
27 Fieldcrest Dr., Wheeling, WV 26003
Address

Consolidation Coal Company
Name of Well Operator
P.O. Box 1314, Morgantown, WV 26507-1314
Complete Address

April 30, 19 92
WELL AND LOCATION

Clay District
Monongalia County

WELL NO. M7-580-A

Benjamin & Bonnie Statler Farm

STATE INSPECTOR SUPERVISING PLUGGING

Randal Micks
AFFIDAVIT

STATE OF WEST VIRGINIA,
County of West Virginia

ss:


Calvin C. Lofton and George R. Gore

being first duly sworn according to law depose and say that they are experienced in the work of plugging and filling oil and gas wells and were employed by Consolidation Coal Company, well operator, and participated in the work of plugging and filling the above well, that said work was commenced on the 15th day of April, 19 92, and that the well was plugged and filled in the following manner:

Sand or Zone Record Formation	Filling Material	Plugs Used Size & Kind	Casing	
			C5G PULLED	C5G LEFT IN
Tripped in hole and cleaned 9 hole to 7 7/8" and cleaned 7 170' of 8" casing. Cleined 7 Coal from 592' to 600'. Ran follows: 429.95' of 2 3/8" 4 1/2" casing. Total 1,230.34'. Float valve at 800.39'. Swedge to surface as follows: Pumped flush. Displaced cement to bailed dry.	7/8" hole to 570' Reduced 7/8" hole to 1,250' Pilled 7/8" hole through Pittsburgh coal protection string as follows: 429.95' of 2 3/8" tubing followed by 800.39' of 4 1/2" casing. Total 1,230.34'. Latch down plug at 768.87'. Swedge at 801.39'. Circulated cement 500 sack of poz mix and 340 Used 1,000 gallons of mud 764.48' with water. Let set and			
TOTAL DEPTH: 1,250 feet				
Coal Seams		Description of Monument		
(Name) Pittsburgh	592 feet to 600 feet	8 feet of 4 1/2" casing with plaque stating: Consol WV m7-580-A Permit 47-61-01070-P		
(Name)				
(Name)				
(Name)				

and that the work of plugging and filling said well was completed on the 21st day of April, 19 92.

And further deponents saith not.

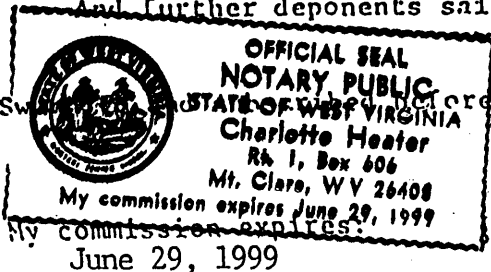

Sworn before me this 30th day of April, 19 92

Calvin C. Lofton
George R. Gore
Charlotte Heater
Notary Public