


Jimmie
4/21/92

LATITUDE 39°42'30" 1,650

W.D. TENNANT HRS.
&
W.L. TENNANT EST.

MARVIN TENNANT

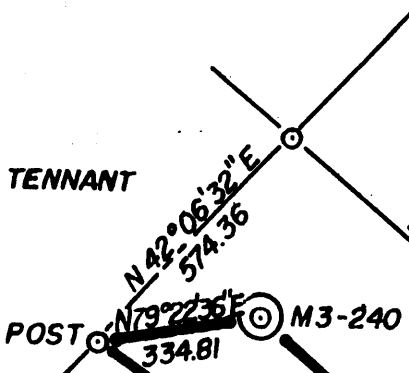

LEONARD WILSON

REBECCA B. MOORE

FRANK D. ROSE

DEED ACREAGE 21.25
CALC. ACREAGE 22.287


JAKES RUN
WV RT. 29

1/2" I.P.
S 46° 00' W 271.20
S 68° 04' 56" W 75.05

NORTH

LONGITUDE 80° 10'

14,300

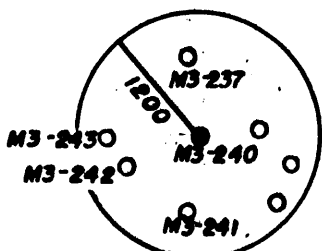

(+) DENOTES LOCATION OF WELL ON UNITED STATES TOPOGRAPHIC MAPS

FILE NO. _____
DRAWING NO. _____
SCALE 1" = 400'
MINIMUM DEGREE OF ACCURACY 1 IN 5000
PROVEN SOURCE OF ELEVATION COMPANY SURVEYED TIED INTO USGS NETWORK

I THE UNDERSIGNED, HEREBY CERTIFY THAT THIS PLAT IS CORRECT TO THE BEST OF MY KNOWLEDGE AND BELIEF AND SHOWS ALL THE INFORMATION REQUIRED BY LAW AND THE REGULATIONS ISSUED AND PRESCRIBED BY THE DEPARTMENT OF ENERGY.

(SIGNED) Paul D. Darbent

R.P.E. _____ L.L.S. 862

PLACE SEAL HERE

STATE OF WEST VIRGINIA
DEPARTMENT OF ENERGY
OIL AND GAS DIVISION



DATE 3-25, 1992

OPERATOR'S WELL NO. M3-240

API WELL NO. 47-061-0107-P

STATE COUNTY PERMIT

WELL TYPE: OIL ___ GAS ___ LIQUID INJECTION ___ WASTE DISPOSAL ___
(IF "GAS,") PRODUCTION ___ STORAGE ___ DEEP ___ SHALLOW X ABANDONED X

LOCATION: ELEVATION 1157.15 WATERSHED JAKES RUN

DISTRICT CLAY COUNTY MONONGALIA

QUADRANGLE BLACKSVILLE

SURFACE OWNER REBECCA B. MOORE

OIL & GAS ROYALTY OWNER _____ ACREAGE 22.287

LEASE NO. _____ LEASE ACREAGE _____

PROPOSED WORK: DRILL ___ CONVERT ___ DRILL DEEPER ___ REDRILL ___ FRACTURE OR STIMULATE ___ PLUG OFF OLD FORMATION ___ PERFORATE NEW FORMATION ___ OTHER PHYSICAL CHANGE IN WELL (SPECIFY) _____

PLUG AND ABANDON ___ CLEAN OUT AND REPLUG ___

TARGET FORMATION NONE ESTIMATED DEPTH _____

WELL OPERATOR CONSOLIDATION COAL CO. DESIGNATED AGENT ROGER E. DUCKWORTH

ADDRESS P.O. BOX 1314 MORGANTOWN 26505 ADDRESS P.O. BOX 1314 MORGANTOWN 26505

COUNTY NAME

PERMIT

061-1071-P

STATE OF WEST VIRGINIA
DEPARTMENT OF ENERGY
OIL AND GAS WELLS DIVISION

AFFIDAVIT OF PLUGGING AND FILLING WELL

AFFIDAVIT SHOULD BE MADE IN TRIPLICATE, one copy mailed to the Division, one copy to be retained by the Well Operator and the third copy (and extra copies if required) should be mailed to each coal operator at their respective addresses.

<u>Consolidation Coal Company</u> Coal Operator or Owner <u>P. O. Box 1314, Morgantown, WV 26507-1314</u> Address <u>Coal Operator or Owner</u> <u>Address</u> <u>Rebecca Moore</u> Lease or Property Owner <u>Route 2, Box 130, Fairview, WV 26570</u> Address	<u>Consolidation Coal Company</u> Name of Well Operator <u>P. O. Box 1314, Morgantown, WV 26507-1314</u> Complete Address <u>May 28,</u> 19 <u>92</u> WELL AND LOCATION <u>Clay</u> District <u>Monongalia</u> County WELL NO. <u>M3-240</u>
--	--

Rebecca B. Moore Farm

STATE INSPECTOR SUPERVISING PLUGGING

Randal Mick

AFFIDAVIT

STATE OF WEST VIRGINIA,

County of Harrison

ss:

Calvin C. Lofton and Kevin Wright

being first duly sworn according to law depose and say that they are experienced in the work of plugging and filling oil and gas wells and were employed by Consolidation Coal Company, well operator, and participated in the work of plugging and filling the above well, that said work was commenced on the 13 day of May, 19 92, and that the well was plugged and filled in the following manner:

Sand or Zone Record Formation	Filling Material	Plugs Used Size & Kind	Casing	
			C50 PULLED	C50 LEFT IN
Cleaned 12 1/4" hole to 622' Reduced hole to 6 1/2" and cleaned 6 1/2" hole from 622' to 1,763'. Extreme difficulty getting in side of 7" casing. Pulled 349.21' of 7" casing. Cleaned 9 7/8" from 622' to 848'. Cleaned 9 7/8" hole thru Pittsburgh Coal from 678' to 687'. Jell plug from 1,763' back to 1,395.67'. Ran coal protection string as follows: 500.15' of 2" tubing followed by 895.52' of 4 1/2" casing. Cemented hole from 1,395.67' back to surface as follows: Pumped 495 sacks of poz mix followed by 300 sacks of thixotropic cement. Used 1,000 gallons of mud flush. Displaced cement to 864.67' with water, let set and bailed dry.				
TOTAL DEPTH: 1,763 feet				
Coal Seams			Description of Monument	
(Name) Pittsburgh	678 feet to 687 feet		8 feet of 4 1/2" casing with plaque stating:	
(Name)			Consol WV M3-240	
(Name)			Permit 47-061-1071-P	
(Name)				

and that the work of plugging and filling said well was completed on the 22nd day of May, 19 92.

And further deponents saith not.

Sworn to and subscribed before me this 28th day of May, 19 92

Calvin C. Lofton
Kevin Wright

Notary Public