

WW-7
8-30-06



West Virginia Department of Environmental Protection
Office of Oil and Gas
WELL LOCATION FORM: GPS

API: 4706101072 WELL NO.: 004570

FARM NAME: Shuman Inc

RESPONSIBLE PARTY NAME: CNX

COUNTY: Monongalia DISTRICT: Battelle

QUADRANGLE: Wadestown

SURFACE OWNER: Hennen Buck & Linda

ROYALTY OWNER: Hennen Buck & Linda

UTM GPS NORTHING: 4394232.21

UTM GPS EASTING: 561872.01 GPS ELEVATION: 1134.65

The Responsible Party named above has chosen to submit GPS coordinates in lieu of preparing a new well location plat for a plugging permit or assigned API number on the above well. The Office of Oil and Gas will not accept GPS coordinates that do not meet the following requirements:

1. Datum: NAD 1983, Zone: 17 North, Coordinate Units: meters, Altitude: height above mean sea level (MSL) – meters.
2. Accuracy to Datum – 3.05 meters
3. Data Collection Method:

Survey grade GPS : Post Processed Differential _____

Real-Time Differential

Mapping Grade GPS _____ : Post Processed Differential _____

Real-Time Differential _____

4. Letter size copy of the topography map showing the well location.

I the undersigned, hereby certify this data is correct to the best of my knowledge and belief and shows all the information required by law and the regulations issued and prescribed by the Office of Oil and Gas.


[Signature]
Signature

Project Manager
Title

12-3-20
Date

RECEIVED
Office of Oil and Gas
DEC 10 2020
WV Department of Environmental Protection

47-061-01072P

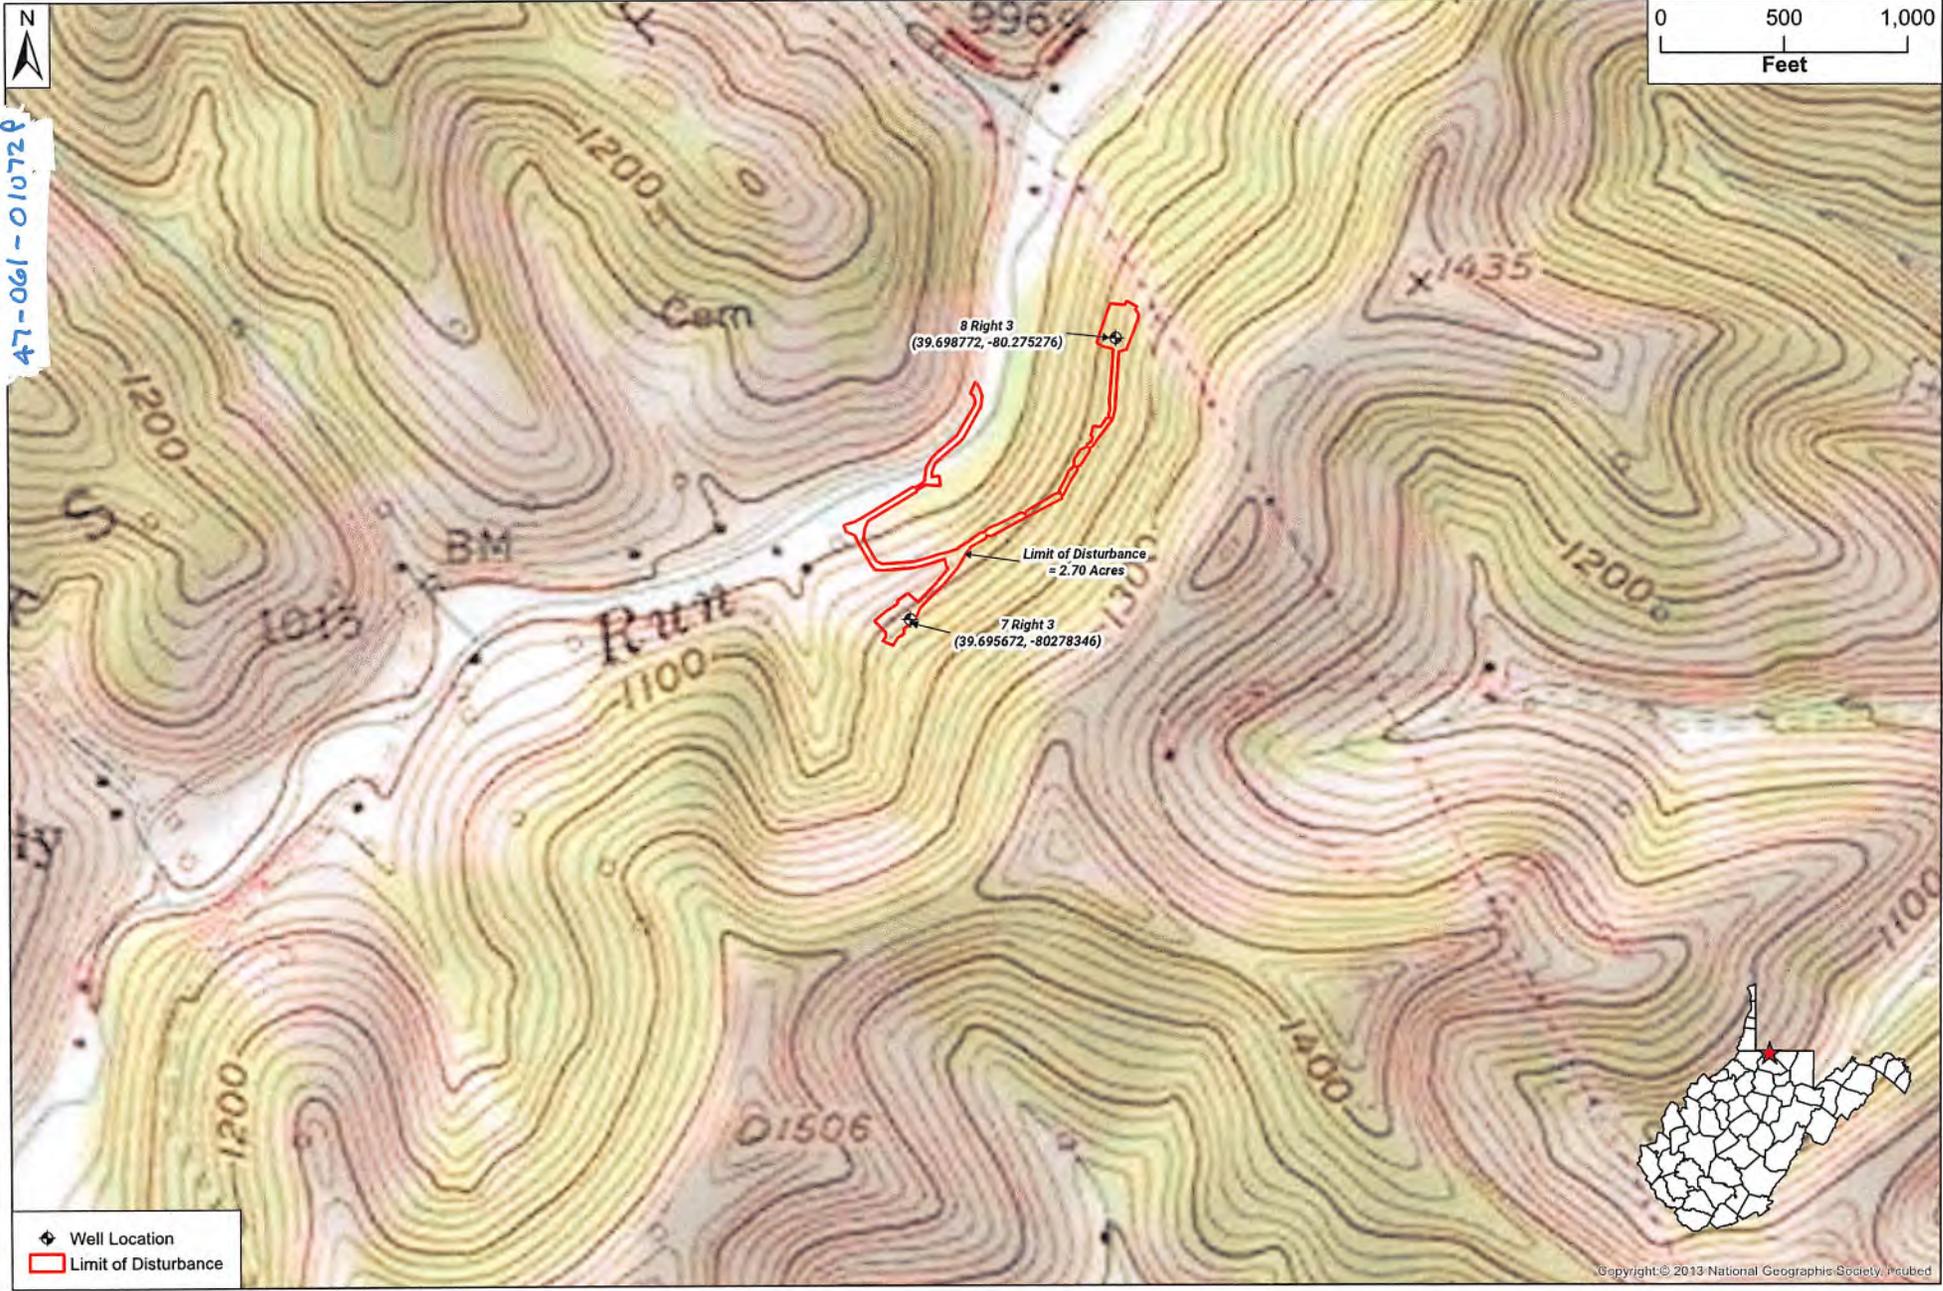

◆ Well Location
 □ Limit of Disturbance

Copyright © 2013 National Geographic Society, Inc.

7 Right 3 (004570) & 8 Right 3 (004613) Well Heads

Site Location Topographic Map
 Monongalia County, West Virginia



Date: 11/19/21
 By: J. Stascak