


39° 45' LATITUDE
10,100

LONGITUDE
12,801
80° 07' 30"

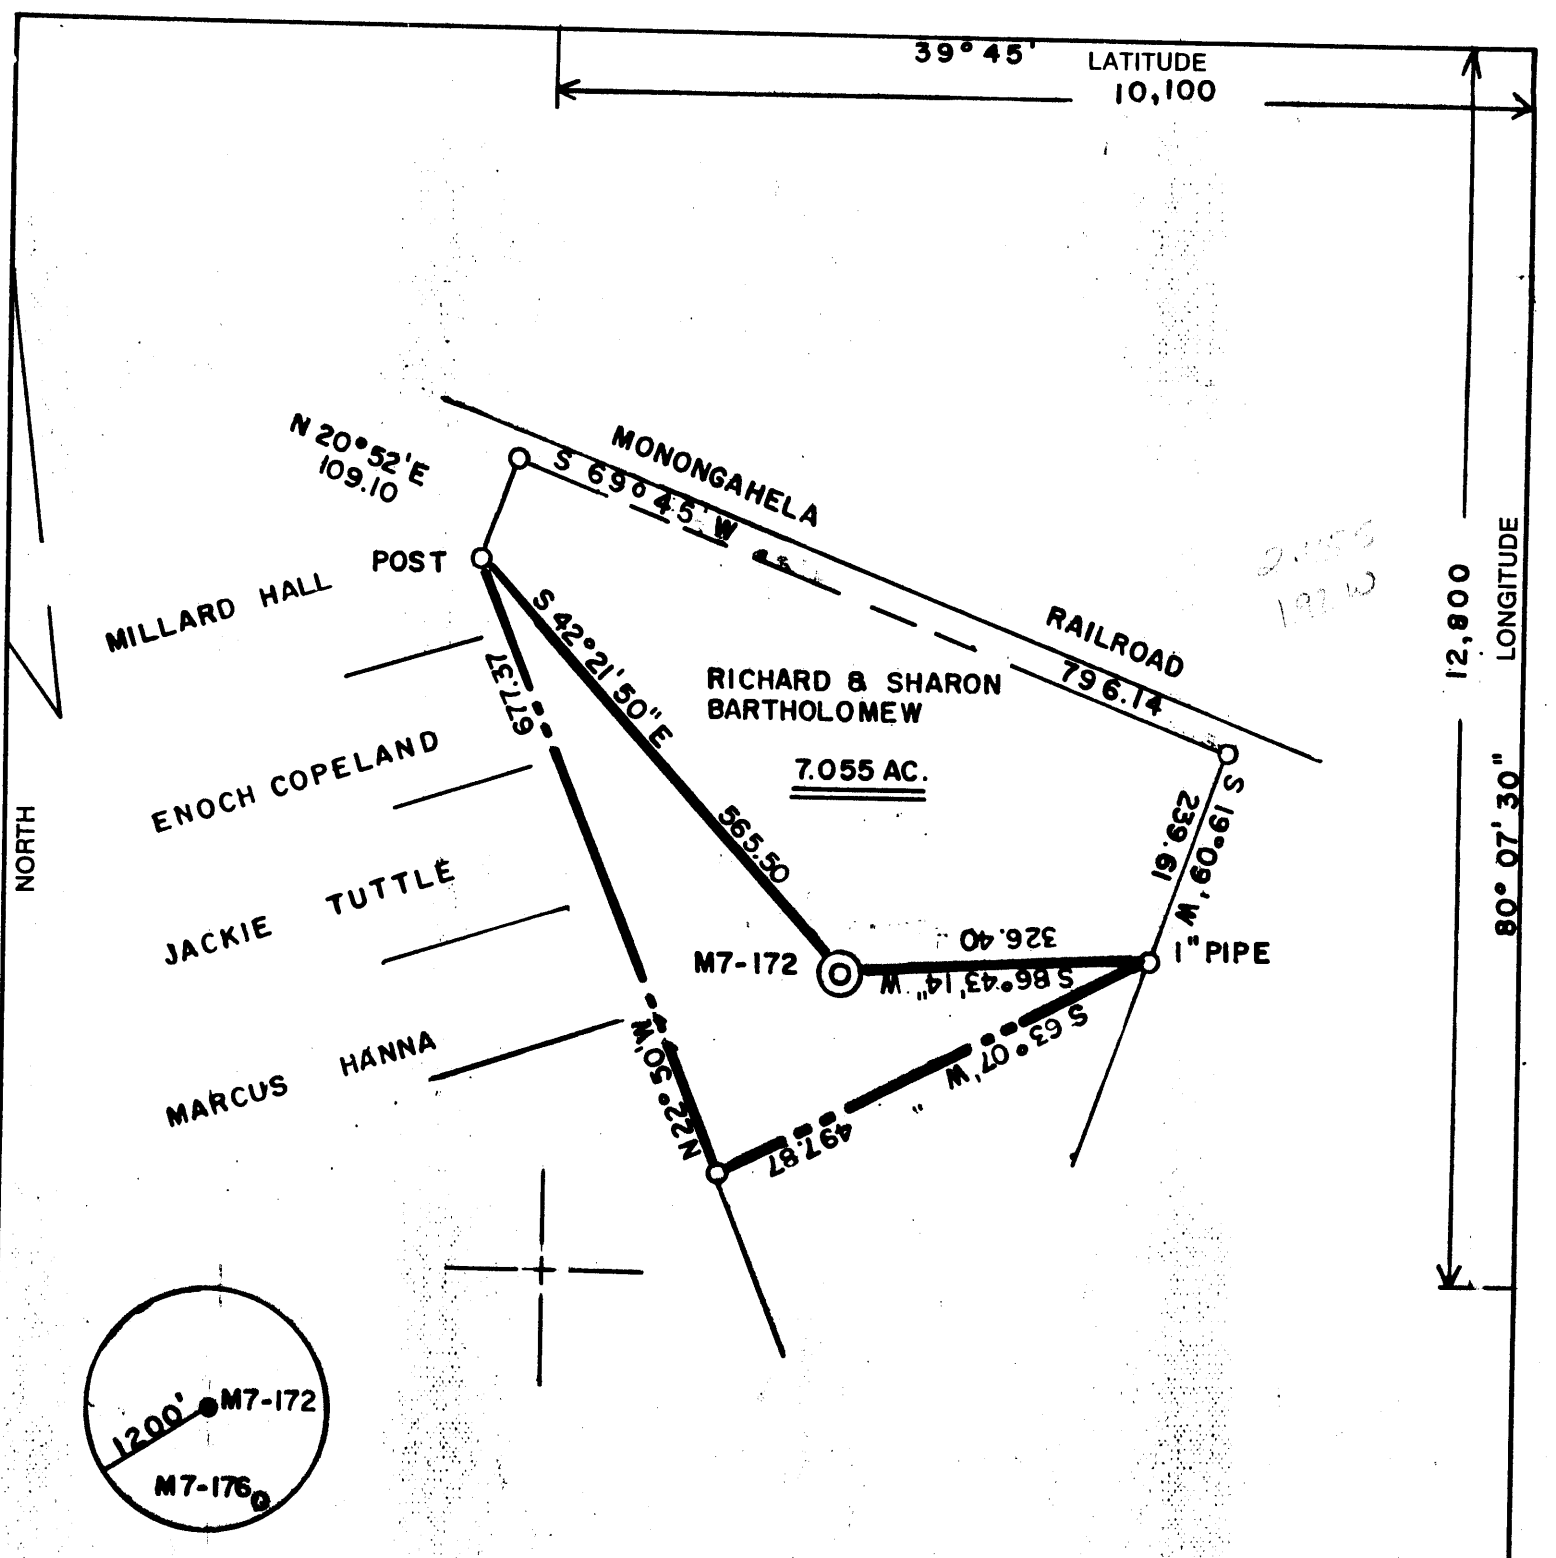


(+) DENOTES LOCATION OF WELL ON UNITED STATES TOPOGRAPHIC MAPS

FILE NO. _____
 DRAWING NO. _____
 SCALE 1" = 200'
 MINIMUM DEGREE OF ACCURACY 1 IN 5000
 PROVEN SOURCE OF ELEVATION COMPANY SURVEY
TIED INTO U.S.G.S NETWORK

I THE UNDERSIGNED, HEREBY CERTIFY THAT THIS PLAT IS CORRECT TO THE BEST OF MY KNOWLEDGE AND BELIEF AND SHOWS ALL THE INFORMATION REQUIRED BY LAW AND THE REGULATIONS ISSUED AND PRESCRIBED BY THE DEPARTMENT OF ENERGY.

(SIGNED) Carl Morris
 R.P.E. _____ L.L.S. 460

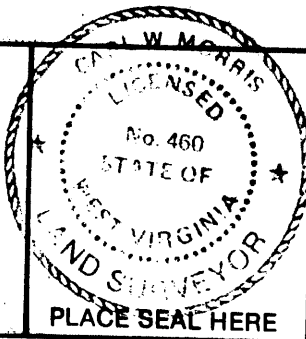

STATE OF WEST VIRGINIA
 DEPARTMENT OF ENERGY
 OIL AND GAS DIVISION



DATE DEC. 19, 19 89
 OPERATOR'S WELL NO. M7-172
 API WELL NO. _____

WELL TYPE: OIL ___ GAS ___ LIQUID INJECTION ___ WASTE DISPOSAL ___
 (IF "GAS,") PRODUCTION ___ STORAGE ___ DEEP ___ SHALLOW X ABANDONED X STATE COUNTY PERMIT

LOCATION: ELEVATION 985.27 WATER SHED DUNKARD CREEK
 DISTRICT CLAY COUNTY MONONGALIA

QUADRANGLE WADESTOWN WV, PA
 SURFACE OWNER RICHARD & SHARON BARTHOLOMEW ACREAGE 7.055

OIL & GAS ROYALTY OWNER _____ LEASE ACREAGE _____ LEASE NO. _____

PROPOSED WORK: DRILL ___ CONVERT ___ DRILL DEEPER ___ REDRILL ___ FRACTURE OR STIMULATE ___ PLUG OFF OLD FORMATION ___ PERFORATE NEW FORMATION ___ OTHER PHYSICAL CHANGE IN WELL (SPECIFY) _____

PLUG AND ABANDON ___ CLEAN OUT AND REPLUG X

TARGET FORMATION NONE ESTIMATED DEPTH _____

WELL OPERATOR CONSOLIDATION COAL CO. DESIGNATED AGENT ROGER E. DUCKWORTH
 ADDRESS P.O. BOX 1314 MORGANTOWN WV 26505 ADDRESS P.O. BOX 1314 MORGANTOWN WV 26505

COUNTY NAME PERMIT

REC'D
OFFICE OF OIL AND GAS
DEC 02 1996
WV Division of
Environmental Protection

AFFIDAVIT OF PLUGGING AND FILLING WELL

AFFIDAVIT SHOULD BE MADE IN TRIPLICATE, one copy mailed to the Division, one copy to be retained by the Well Operator and the third copy (and extra copies if required) should be mailed to each coal operator at their respective addresses.

Consolidation Coal Co.
Coal Operator or Owner
E.O. Box 1314 Morgantown, W.Va. 26507
Address

Consolidation Coal Co.
Coal Operator or Owner
P.O. Box 1314 Morgantown, W.Va.
Address

Richard & Sharon Bartholomew
Lease or Property Owner
Rt. 1 Box 63-J Core, W.Va. 26529
Address

Consolidation Coal Co.
Name of Well Operator
P.O. Box 1314 Morgantown, W.Va. 26507
Complete Address

June 11 19 92
WELL AND LOCATION

Clay District

Monongalia County

WELL NO. M7-172

STATE INSPECTOR SUPERVISING PLUGGING Richard & Sharon Bartholomew, Farm
Randall Mick *Randall Mick*
AFFIDAVIT

STATE OF WEST VIRGINIA,
County of Monongalia ss:

Larry L. Yost and Dennis L. Yost
being first duly sworn according to law depose and say that they are experienced in the work of plugging and filling oil and gas wells and were employed by Consolidation Coal Co., well operator, and participated in the work of plugging and filling the above well, that said work was commenced on the 1st day of June, 19 92, and that the well was plugged and filled in the following manner:

Sand or Zone Record Formation	Filling Material	Plugs Used Size & Kind	Casing	
			CSG PULLED	CSG LEFT IN
	Cleaned wellbore to 1135 ft.			
	Ran coal protection string as follows; 728 ft. of 4 1/2" casing; 394 ft. of 2 3/8" tubing; Latch down plug at 708 ft.; Float valve at 728 ft.; Swedge at 729 ft.			
	Circulated cement to surface as follows; 200 sacks of Poz Mix; 275 sacks of expanding type cement; 1,000 gal. of mud flush.			
	Let set, bailed dry, set monument.			
Coal Seams		Description of Monument		
(Name) Pittsburgh-582'-592'		6 ft. of 4 1/2" casing with plaque stating Consol		
(Name)		M7-172.		
(Name)		47-61-01073-P		

and that the work of plugging and filling said well was completed on the 10th day of June, 19 92.

My commission expires March 12, 2002

OFFICIAL SEAL
Notary Public, State of West Virginia
CHERAL A. SKINNER
FAIRVIEW, WV 26570

further deponents said not.
Subscribed and sworn to before me this 11th day of June, 19 92.
Larry L. Yost
Dennis L. Yost
Cheral A. Skinner
Notary Public

My commission expires: MARCH 12, 2002
Permit No. 47-61-01073