

*Janie*  
6/29/92

LATITUDE 39° 42' 30"


9125

TOPO. LOC.  
WADESTOWN QUAD.  
7 1/2' SERIES

6 N 173 W  
173 W

2275


LONGITUDE 80° 17' 30"

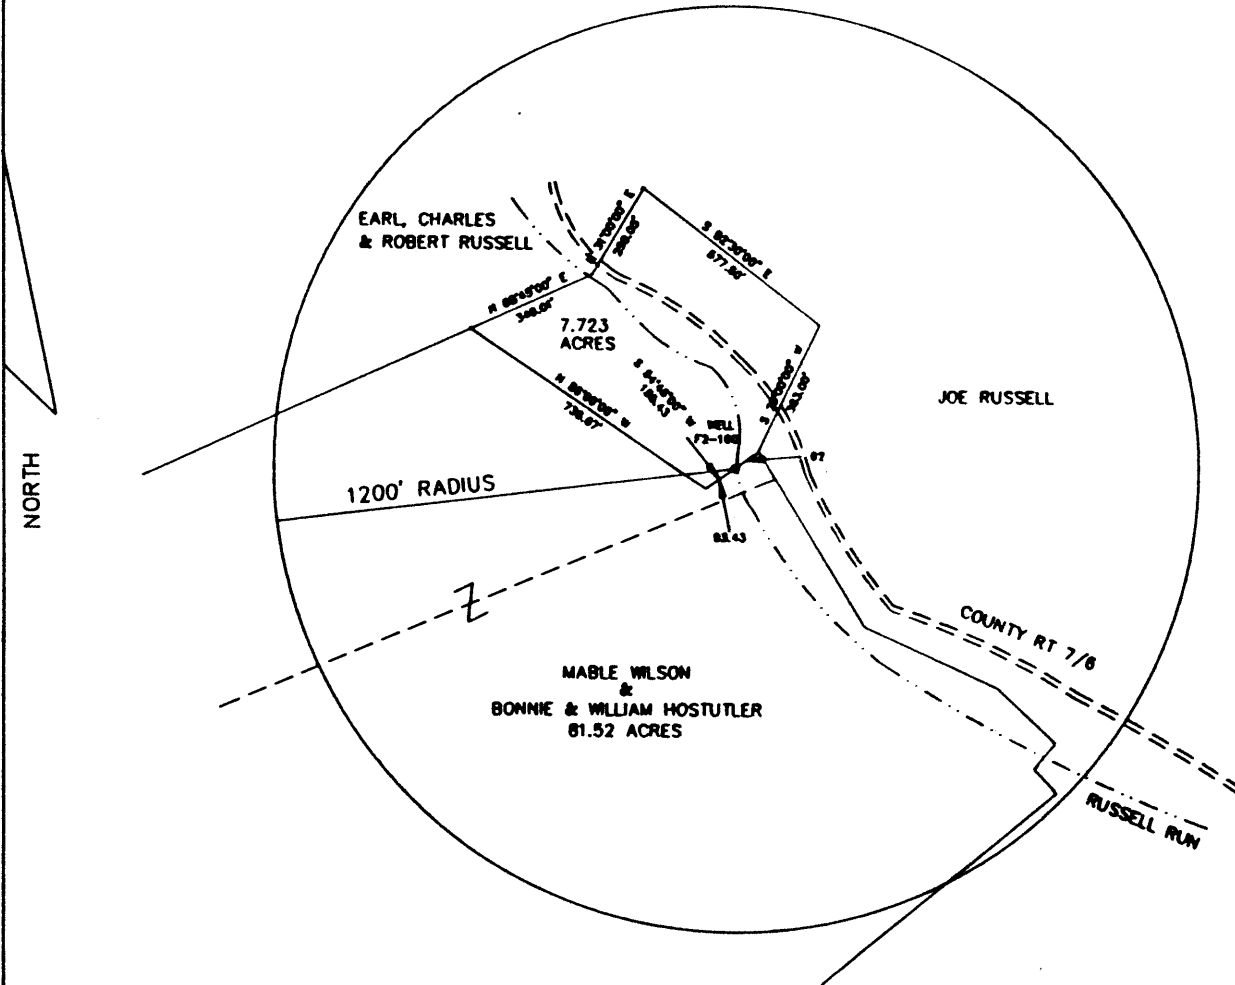

15'  
3.315  
3950

FILE NO. F2-1-198  
 DRAWING NO. F2-2-245  
 SCALE 1" = 500'  
 MINIMUM DEGREE OF  
 ACCURACY 1/2500'  
 PROVEN SOURCE OF  
 ELEVATION USGS B.M.

I THE UNDERSIGNED, HEREBY CERTIFY  
 THAT THIS PLAT IS CORRECT TO THE  
 BEST OF MY KNOWLEDGE AND BELIEF AND  
 SHOWS ALL THE INFORMATION REQUIRED  
 BY LAW AND THE REGULATIONS ISSUED  
 AND PRESCRIBED BY THE DEPARTMENT OF  
 MINES.  
 (SIGNED) John F. Ewell, Jr.  
 R.P.E. 11133 L.L.S.

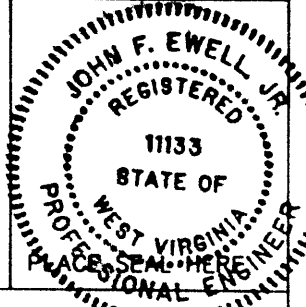

(+) DENOTES LOCATION OF  
 WELL ON UNITED STATES  
 TOPOGRAPHIC MAPS

FORM IV-6  
 (8-78)

STATE OF WEST VIRGINIA  
 DEPARTMENT OF MINES  
 OIL AND GAS DIVISION

DATE JUNE 3, 1992  
 OPERATOR'S WELL NO. F2-160  
 API WELL NO. 47-061-1000-P  
 STATE COUNTY PERMIT

was 061-78152  
 #24A on 1912  
 Co. Rt. Map

WELL TYPE: OIL \_\_\_ GAS X LIQUID INJECTION \_\_\_ WASTE DISPOSAL \_\_\_  
 (IF "GAS", PRODUCTION \_\_\_ STORAGE \_\_\_ DEEP \_\_\_ SHALLOW X \_\_\_)  
 LOCATION: ELEVATION 1065 WATERSHED RUSSELL RUN  
 DISTRICT BATTELLE COUNTY MONONGALIA  
 QUADRANGLE WADESTOWN  
 SURFACE OWNER ROSANNA RUSSELL EST. ACREAGE 7.723  
 OIL & GAS ROYALTY OWNER FORMERLY HOPE GAS CO. LEASE ACREAGE 100  
 LEASE NO. 4009  
 PROPOSED WORK: DRILL \_\_\_ CONVERT \_\_\_ DRILL DEEPER \_\_\_ REDRILL X FRACTURE OR  
 STIMULATE \_\_\_ PLUG OFF OLD FORMATION \_\_\_ PERFORATE NEW  
 FORMATION \_\_\_ OTHER PHYSICAL CHANGE IN WELL (SPECIFY) \_\_\_  
 PLUG AND ABANDON X CLEAN OUT AND REPLUG \_\_\_  
 TARGET FORMATION FIFTH SAND ESTIMATED DEPTH 3223  
 WELL OPERATOR EASTERN ASSOC. COAL DESIGNATED AGENT TERRY O. HENDERSHOT  
 ADDRESS ROUTE 1 BOX 144 ADDRESS ROUTE 1 BOX 144  
FAIRVIEW WV. 26570 FAIRVIEW WV. 26570

JUL 2 1992

STATE OF WEST VIRGINIA  
DIVISION OF ENVIRONMENTAL PROTECTION  
SECTION OF OIL AND GAS

AFFIDAVIT OF PLUGGING AND FILLING WELL

AFFIDAVIT SHOULD BE IN TRIPPLICATE, one copy mailed to the Division, one copy to be retained by the Well Operator and the third copy (and extra copies if required) should be mailed to each coal operator at their respective addresses.

Farm name: HOSTETTLER, BONNIE Operator Well No.: F 2 160

LOCATION: Elevation: 1065.00 Quadrangle: WADESTOWN  
District: BATTELLE County: MONONGALIA  
Latitude: 2275 Feet South of 39 Deg. 42 Min. 30 Sec.  
Longitude 9125 Feet West of 80 Deg. 17 Min. 30 Sec.

Well Type: OIL \_\_\_\_\_ GAS X

Company: Eastern Associated Coal Corp. Coal Operator Eastern Assoc. Coal Corp.  
Route 1 - Box 144 or Owner Route 1 - Box 144  
Fairview, WV 26570 Fairview, WV 26570

Agent: Terry O. Hendershot Coal Operator \_\_\_\_\_  
or Owner \_\_\_\_\_  
Permit Issued: 07/01/92

AFFIDAVIT

STATE OF WEST VIRGINIA,  
County of Monongalia ss:

Fred Chisler and Craig Park being first duly sworn according to law depose and say that they are experienced in the work of plugging and filling oil and gas wells and were employed by the above named well operator, and participated in the work of plugging and filling the above well, and Randal Mick Oil and Gas Inspector representing the Director, say that said work was commenced on the 13th day of July, 1992, and that the well was plugged and filled in the following manner:

TYPE	FROM	TO	PIPE REMOVED	LEFT
Cleaned out to depth of	1721'			
Run 2 3/8" tubing to	1721'	run 250 sks Portland cement and pulled all tubing.		
Logged well Gamma Ray Neutron and 4 Arm Caliper.				
Run 4 1/2" pipe to 1051', run 650 sks Portland and 200 sks Chem. Comp.				
Cement, circulated, pumped plug to 990'				
Bailed water out inside 4 1/2" and checked plug -- OK.				
Pittsburgh Coal 837' to	844'			

Description of monument: 4 1/2" x 2" swedge, metal plate with A.P.I. No.  
and date plugged. 11/2/92  
and that the work of plugging and filling said well was completed on the 29th day of July, 1992.

And further deponents saith not.

Fredrick C Chisler  
Craig Park  
William J Tuttle  
Notary Public

Sworn and subscribe before me this 31 day of July, 1992  
My commission expires: June 17, 1997

Oil and Gas Inspector: Randal Mick

NOV 6 1992