

Janice
10/1/92


LATITUDE 39° 42' 30"

7,950'

3,325'


LONGITUDE 80° 15' 00"

NORTH

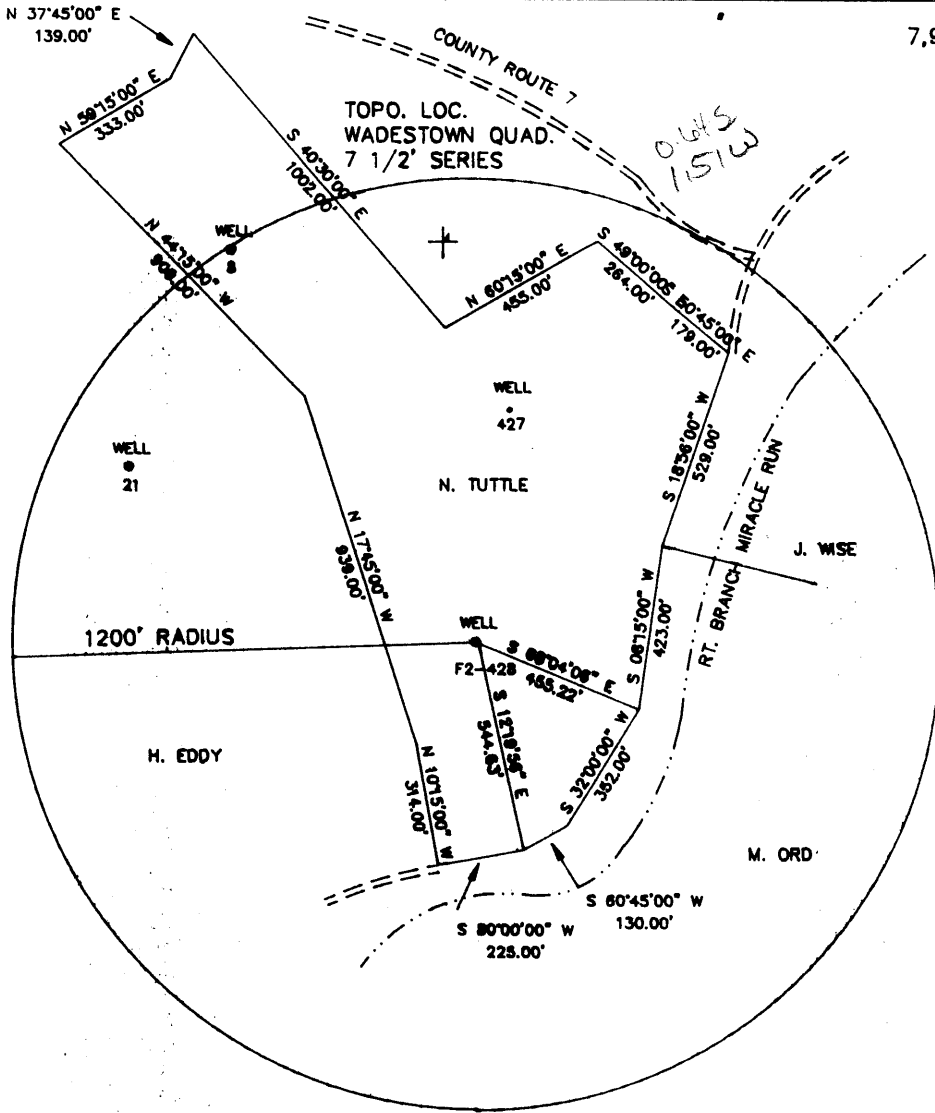

FILE NO. F2-1-189
 DRAWING NO. F2-2-246
 SCALE 1" = 500'
 MINIMUM DEGREE OF ACCURACY 1/2500'
 PROVEN SOURCE OF ELEVATION USGS B.M.

I THE UNDERSIGNED, HEREBY CERTIFY THAT THIS PLAT IS CORRECT TO THE BEST OF MY KNOWLEDGE AND BELIEF AND SHOWS ALL THE INFORMATION REQUIRED BY LAW AND THE REGULATIONS ISSUED AND PRESCRIBED BY THE DEPARTMENT OF MINES.
 (SIGNED) John F. Ewell, Jr.
 R.P.E. 11133 L.L.S.

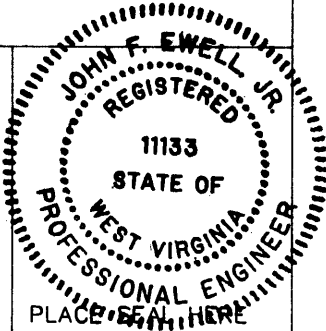

(+) DENOTES LOCATION OF WELL ON UNITED STATES TOPOGRAPHIC MAPS

DATE JULY 27, 1992
 OPERATOR'S WELL NO. F2-428
 API WELL NO.

FORM IV-6
(8-78)

STATE OF WEST VIRGINIA
 DEPARTMENT OF MINES
 OIL AND GAS DIVISION

47-061-1083-P
 STATE COUNTY PERMIT

WELL TYPE: OIL X GAS X LIQUID INJECTION WASTE DISPOSAL
 (IF "GAS", PRODUCTION STORAGE DEEP SHALLOW X)
 LOCATION: ELEVATION 1105 WATERSHED RIGHT BRANCH OF MIRACLE RUN
DISTRICT BATTLE COUNTY MONONGALIA
QUADRANGLE WADESTOWN
 SURFACE OWNER NAOMI TUTTLE ACREAGE 33.4
 OIL & GAS ROYALTY OWNER FORMERLY SOUTH PENN OIL CO. LEASE ACREAGE 47 7/8
 LEASE NO.
 PROPOSED WORK: DRILL CONVERT DRILL DEEPER REDRILL X FRACTURE OR
 STIMULATE PLUG OFF OLD FORMATION PERFORATE NEW
 FORMATION OTHER PHYSICAL CHANGE IN WELL (SPECIFY)
 PLUG AND ABANDON CLEAN OUT AND REPLUG X
 TARGET FORMATION GORDON SAND ESTIMATED DEPTH 3079
 WELL OPERATOR EASTERN ASSOC. COAL DESIGNATED AGENT TERRY O. HENDERSHOT
 ADDRESS ROUTE 1 BOX 144 ADDRESS ROUTE 1 BOX 144
FAIRVIEW WV. 26570 FAIRVIEW WV. 26570

OCT 3 1992

STATE OF WEST VIRGINIA
DIVISION OF ENVIRONMENTAL PROTECTION
SECTION OF OIL AND GAS

RECEIVED
Office of Oil & Gas
JUL 12 1993

AFFIDAVIT OF PLUGGING AND FILLING WELL

AFFIDAVIT SHOULD BE IN TRIPLICATE, one copy mailed to the Division, one copy to be retained by the Well Operator and the third copy (plus extra copies if required) should be mailed to each coal operator at their respective addresses.

Farm name: TUTTLE, NAOMI Operator Well No.: F2-428/THOMAS#3

LOCATION: Elevation: 1105.00 Quadrangle: WADESTOWN
District: BATTELLE County: MONONGALIA
Latitude: 3325 Feet South of 39 Deg. 42 Min. 30 Sec.
Longitude 7950 Feet West of 80 Deg. 15 Min. 0 Sec.

Well Type: OIL X GAS _____

Company: Eastern Associated Coal Corp. Coal Operator Eastern Associated Coal Corp.
Route 1 - Box 144 or Owner Route 1 - Box 144
Fairview, WV 26570 Fairview, WV 26570

Agent: Terry O. Hendershot Coal Operator _____
or Owner _____

Permit Issued: 10/02/92

AFFIDAVIT

STATE OF WEST VIRGINIA,
County of Monongalia ss:

Jeff Hostuttler and Jim Gump being first duly sworn according to law depose and say that they are experienced in the work of plugging and filling oil and gas wells and were employed by the above named well operator, and participated in the work of plugging and filling the above well, and Randal Mick Oil and Gas Inspector representing the Director, say that said work was commenced on the 5th day of October, 1992, and that the well was plugged and filled in the following manner:

TYPE	FROM	TO	PIPE REMOVED	LEFT
Cleaned out to depth of	1124'			
Run Loggs Gamma Ray, Neutron and 3 Arm Caliper.				
Fished out 797' of old 2" tubing.				
Run 201' 4" of 3" pipe and 922' 8" of 4 1/2" pipe.				
Gelled hole with 15 sks gell. Run 900 sks Portland and 300 sks Chem. Comp. Cement.				
Pumped latch down, plug to 922'. Tagged cement on outside 4 1/2" at 154' down.				
Run 200 sks Portland and got circulation. Bailed water out inside 4 1/2", checked plug -- OK.				
Pittsburgh Coal 811' to	820'.			

Description of monument: 4 1/2" x 2" swedge, metal plate with A.P.I. # and date plugged. 7/19/93
and that the work of plugging and filling said well was completed on the 30th day of November, 1992.

And further deponents saith not.

Sworn and subscribe before me this 1st day of December, 1992
My commission expires: 4-15-97

Jeff Hostuttler
Jim Gump
Randal Mick
Notary Public JUL 23 1993

Oil and Gas Inspector: _____