Lat.

39 deg, 37 min Long. 80 deg, 19 min

والمراجع والمتاز المراجع المرافي عاربي والمعاري

1)Attach a photo copy of the location of the well on a 7.5 minute Quadrangle with the corresponding Longitude and Latitude.


2)Designate the location of the well with the symbol(+)

wy Division of Environmental Protection 0.455 = 7.5

1.69W

3.335 3.9/W = 15'

f, the undersigned, Hereby certify that this plat is correct to the best of my A V Company, Inc. SIGNED albert Glast knowledge and belief. TITLE President DATE September 7 _, 19_93 OPERATORS WELL NO. 3143 API WELL NO. 061 - 1136-STATE OF WEST VIRGINIA DEPARTMENT OF ENERGY OIL AND GAS DIVISION WELL TYPE: OIL G LIQUID INJECTION WASTE DURAGE DEEP SHALLOW X WASTE DISPOSAL CV2 A STURACE ELEVATION WATER SHED DISTRICT Battelle COUNTY QUADRANGLE Wadestown LOCATION: ight Branch Miracle - Mannington (EC) 15' . Manning ton SURFACE OWNER ACREAGE 90 OIL & CAS ROYALTY OWNER LEASE ACREAGE See Attached LEASE NO. 7103 H. Delaney PRODUCING FORMATION Fourth Sand TOTAL DEPTH 3186 13 DESIGNATED AGENT Albert B. WELL OPERATOR A V Company ·08 ADDRESS Box 27. Burton ADDRESS Box 27. 26575

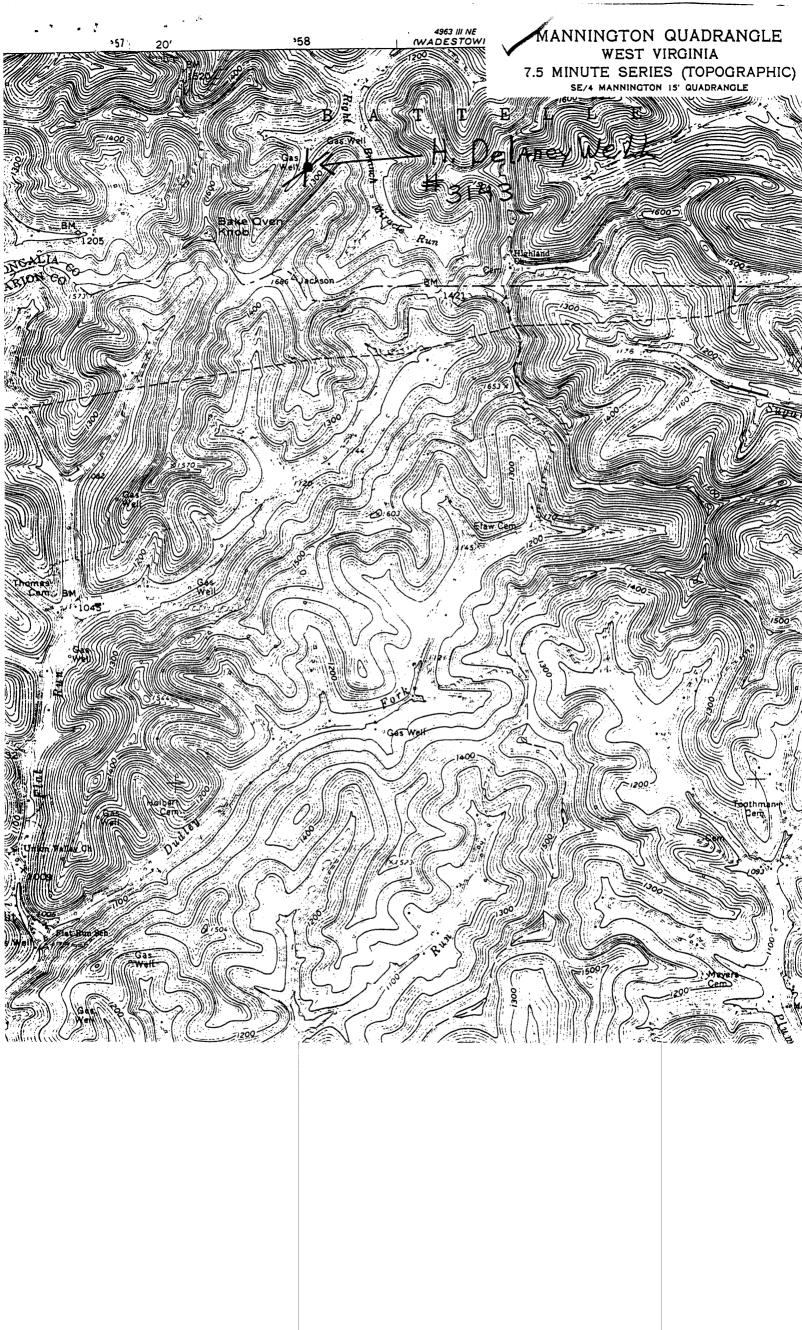

LATITUDE 390 37'30"

75

7'5 OGIS topo location


7.5' 10c 0.495 15' loc 3.375 (calc.) 3.91W 1.69 W

Company

County Monorganela

District Battelle

WELL LOCATION MAP File No. 061-255A 061-1136

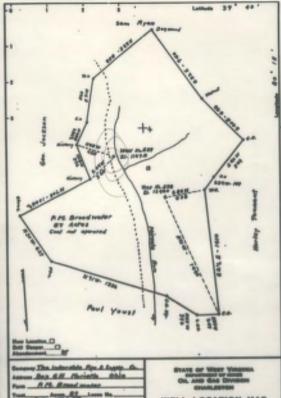

Anton Rey & H. Phromits Ohio
From A.Ch. Street mater
Treet. A from AT
Treet. Losen to.
Was trace! He did A.Ch. Solve be.
Double Ohio A.Ch. Sol

WELL LOCATION MAP

FILE NO. MANY. REFR. PS SI

Advant. To. 100 No. 122-05-05-05

\$ Diseases begins of well on United States
Transported Maps, nests 1 to 62,000, as

WELL RECORD

Eind of Paster The eurines of tract is evend in fee by Pa. Ha. I Mineral rights are eward by. Depth out Post top. Perf. better Drilling completed Peof. ton. Date shot. Dupth of shot. Open Flow /10ths Water in /100ks Mers, in. On Pt. Rock Pressure 188s., Set 24 hee. 930 PRET TO INCHES. Fresh water. Salt water. PERT____ DICHES. Spri or Top One at 1800. Total at 1800 Show of old at 2010 mally intlied to thee. Hete cilled up to \$8500 and load

STATE OF WEST VIRGINIA DIVISION OF ENVIRONMENTAL PROTECTION SECTION OF OIL AND GAS

WELL REGISTER ASSIGNMENT

This API Number 47-61-01136, issued to A. V. COMPANY is evidence of permission to operate the well that is referenced at the location described on the attached plat, subject to the provisions of Chapters 22 and 22B of the West Virginia Code of 1931, as amended, and all rules and regulations promulgated thereunder. The name and telephone number of the Oil and Gas Inspector for this well is RANDAL MICK - 304-986-3324.

Spills or emergency discharges must be reported to 1-800-654-3312.

Failure to abide by all statutory and regulatory provisions governing all duties and operations hereunder may result in suspension or revocation of your permits and in addition may result in civil and/or criminal penalties.

The enclosed WR-35 must be completed by you and returned to this office. In addition annual production reports must be submitted on this well and failure to do so may require you to plug the well.

Theodore M. Streit Chief

ву: 74 г.	····
-----------	------

...25

Title:	

Operator's Well No: 3143

Farm Name: DELANEY, H.

API Well Number: 47- 61-01136 N

Date Issued : 12/07/93

AFFIDAVIT OF PLUGGING AND FILLING WELL

2- Me Boooders ber Conserve on overse Back Conserve on overse Conserve on overse Conserve on overse Conserve Co	Mariotic Mary 20, Battelli Managa Well No3- M-3 AVIT and say the pigging and say th	BEG	ood in the v	d work
COLUMN TO STATE OF ST	May All, Battell Mennga Well No. Je Me 3 AVIT and say the ployed by 1 gging and anne. anne. anne.	WELL AND LOCA Sign Sign Sign Sign Sign Sign Sign Sign	ood in the v	Farm Farm Fork of signature d work plugged ms
Brien Grant Con A. Old. Comparettion - Control on A control or control - Control on A control or control - Control of Control of Control -	Battell limnaga Well No Pe Me 3 AVIT and ay the played by 5 gging and 1 anno ann	MELL AND LOCA BEG	cod in the w	Farm Farm Fork of signature d work plugged ms
Brien Grant Con A. Old. Comparettion - Control on A control or control - Control on A control or control - Control of Control of Control -	Well No. - Pe Me 3 AVIT and say the played by 5- geing and 1 - man -	150 treatment or to they are experient they are experient they are experient to they are experient to the area of the	ood in the w	Parm Parm rork of sky day da work shugged
Then Gasalian & Oll Corporation Lines on receiver seem Thenling, W. Th. Bearing STATE DEPECTOR SUPERVISION PLUGGING. APPIL STATE OF Mills LUBGINGA, County of Bahington S. W. STORM Deing first day severa according to her depose phagging and filling oil and gas veils and wors on well operator, and participant in the work of pla Was commonated on the Sh. day of Agent Man of She Shammann States Transmiss Seemann States Seemann States Seemann States Seemann States Seemann States See Topics States Seemann States See Topics States Seemann	Well No. - Pe Me 3 AVIT and say the played by 5- geing and 1 - man -	100 100	ood in the w	Parm Parm rork of sky day da work shugged
Sheeling. E. To. ASSESSED AND STREET	Well No. - Be Me B AVIT and say the bloyed by 1 gging and 1 man	breakenter's breakenter's they are experient brakenteks. 2 Bling the shows to be races own sale own	ood in the v	Form rork of sky day, d work plugged me
Sheeling. E. To. ASSESSED AND STREET	AVIT and only the played by 5 gging and 1 man 1	breakmater's. Bryan Green I they are experient In Enkonateles. Plaining the above we put the above we have a ready and the the put to the above and the above are a ready. At Break A Farmant	can A Supposed, that and	rork of sky da., d work plugged me
PEATE DISPECTOR SUPERVISION PLONGENG APPID STATE OF SEASON SURGESSIA. G. M. Season	AVIT and say the played by 1 gging and 1	deral Green I they are experient the Endownton 2. It is and that the FLOOR VERN one over collect a real collec	can A Supposed, that and	rork of sky da., d work plugged me
STATE OF STATE AUGUSTA. County of Statistical State of S	AVIT and say the played by 1 gging and 1	deral Green I they are experient the Endownton 2. It is and that the FLOOR VERN one over collect a real collec	can A Supposed, that and	rork of sky da., d work plugged me
STATE OF STATE AUGUSTA. County of Statistical State of S	and only the played by 5 ging and 1 mmn anna anna anna anna anna anna ann	t they are experien the Endersdecks 2: tiling the above we life 3, and that the raves were sea a sum y climat a flamat	can A Supposed, that and	d work plugged me
STATE OF SECTIONALA, County of Shahlaghan. G. V., Green. Deing first duly sween according to how depose plugging and filling oil and gas wells and wave on well operator, and participated in the work of plugging and filling oil and participated in the work of plugging and filling oil and participated in the work of plugging and filling oil and participated in the work of plugging and filling in the following measures: Security of the filling oil and gas and filling in the following measures: Security of the filling oil and filling in the filling in th	and only the played by 5 ging and 1 mmn anna anna anna anna anna anna ann	t they are experien the Endersdecks 2: tiling the above we life 3, and that the raves were sea a sum y climat a flamat	can A Supposed, that and	d work plugged me
Creaty of Statisfagues. St. W. Streem being first duly everes according to hear depose phagaing and filling oil rand gas wells and were on well operator, and participated in the work of plant was commented on the St. day of Apart. AMD ON DOOR SHORT STATISFACTOR SHORT STATISFACTOR FRANCO GASTERON Statisfactor Statisfactor Statisfactor Statisfactor Statisfactor Statisf	ond may the played by 5 gging and 1 mmss.	t they are experien the Endersdecks 2: tiling the above we life 3, and that the raves were sea a sum y climat a flamat	can A Supposed, that and	d work plugged me
Cs. No. directly being first duty course according to her depose phaging and diffing oil and gas wells and wave on phaging and diffing oil and gas wells and wave on well operator, and participated in the work of phase of the course of the c	ond may the played by 5 gging and 1 mmss.	t they are experien the Endersdecks 2: tiling the above we life 3, and that the raves were sea a sum y climat a flamat	can A Supposed, that and	d work plugged me
phaging and filling oil rad gas wells and were on well operator, and participated in the work of plan was commented on the	ond may the played by 5 gging and 1 mmss.	t they are experien the Endersdecks 2: tiling the above we life 3, and that the raves were sea a sum y climat a flamat	can A Supposed, that and	d work plugged me
phaging and filling oil rad gas wells and were on well operator, and participated in the work of plan was commented on the	played by Siging and S	the Indenticals 2 illing the above w 194 L, and that the races come one come actional Advances 2-timed Advances	can A Supposed, that and	d work plugged me
was commanded on the _80 _day of _4pstl _ and dilled in the following measure: ### Property of the following measure: #### Property Office of the following measure: ###################################		PLUCO VEED ONE O THE COMMENT STREET A COMMENT	040 040 000 000 000	nes aggred
was commanded on the _80 _day of _4pstl _ and dilled in the following measure: ### Property of the following measure: #### Property Office of the following measure: ###################################		PLUCO VEED ONE O THE COMMENT STREET A COMMENT	040 040 000 000 000	nes aggred
PALASS RETURNS FROMTON DESCRIPTION OF THE PALASS RESIDENCE STREET STATES AND		Called Affamat	040 000 000 1500	. 660 Mary 10
Treatment Street Print Age 1876 Age 187	9884 / 9884 / 9884 /	getted Manual	DF 1500	
Dominant Stife and Stife	9884 / 9884 / 9884 /	Street Affermat	DF 1500	
Sign To two fines of the State	1000			880
Nig Tajun Sant May State	1000			
20-Sunt & One Sun Sunnant Selds Sun	1000			
Stormanne Stridge and	360	Street Address	_	
Stormanne Stridge and	946		_	
dlay all	200	Street a/AUT	-	
	900			
0004, 00000	_	- CONTRACTOR	IN OF HOME	1007
on Philipped Sept Compt 64	800	Sees \$1 square	- Step on	top of
on Maladam Hast County 00	988	high, 100 squar	no.on.bods	an_de
		of plan extent	tes to sm	Albe Str
	-	plate inscribe	d pith pro	947 Eq.
and that the work of plugging and filling said	well was	completed on the		-my or
And Seiler descents with not.		0 11 4	,	,
A CONTRACTOR OF THE PARTY OF TH		DIN 19	nu	V.
A 10 3	-	Merch &	Liber	
from to out advertised before me this	day		-	. 104.3.