


LATITUDE 39°40'00"

1500

LONGITUDE 80°10'00"

9706

1855
029W

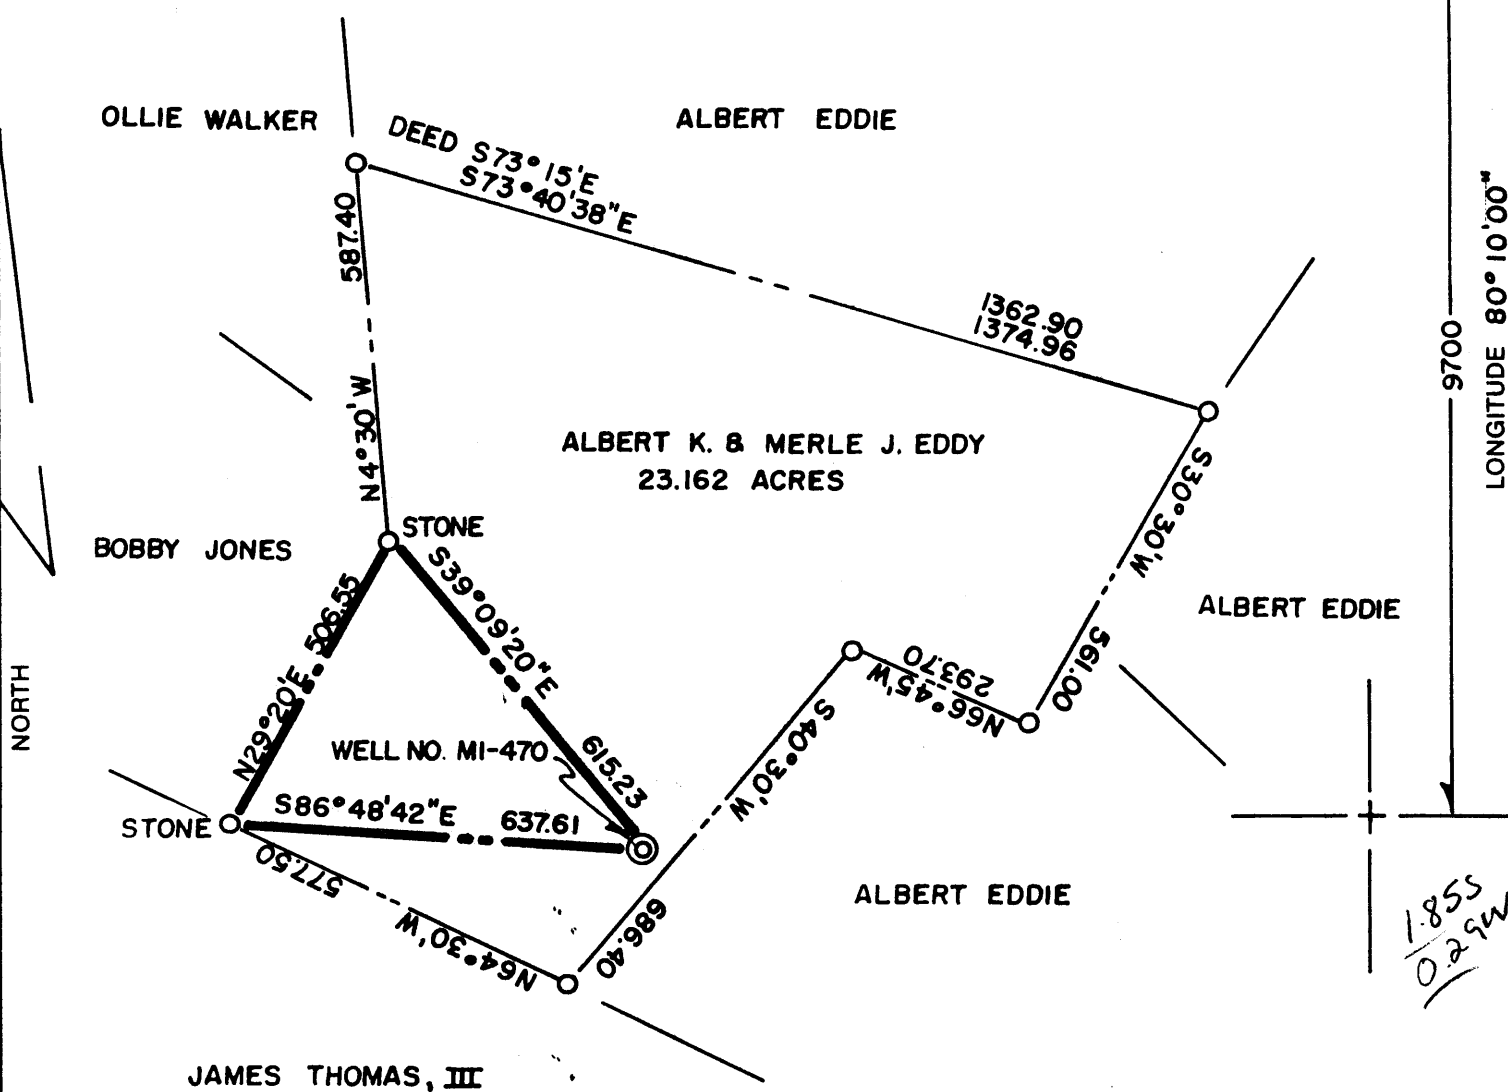

(+) DENOTES LOCATION OF WELL ON UNITED STATES TOPOGRAPHIC MAPS

FILE NO. _____
 DRAWING NO. _____
 SCALE 1" = 300'
 MINIMUM DEGREE OF ACCURACY 1 IN 5000
 PROVEN SOURCE OF ELEVATION COMPANY SURVEY
TIED INTO USGS NETWORK

I THE UNDERSIGNED, HEREBY CERTIFY THAT THIS PLAT IS CORRECT TO THE BEST OF MY KNOWLEDGE AND BELIEF AND SHOWS ALL THE INFORMATION REQUIRED BY LAW AND THE REGULATIONS ISSUED AND PRESCRIBED BY THE DEPARTMENT OF ENERGY
 (SIGNED) [Signature]
 R.P.E. _____ L.L.S. 862

PLACE SEAL HERE

STATE OF WEST VIRGINIA
 DEPARTMENT OF ENERGY
 OIL AND GAS DIVISION



DATE 2-23, 1994
 OPERATOR'S WELL NO. MI-470
 API WELL NO. 47-61-1158-P

WELL TYPE: OIL GAS LIQUID INJECTION WASTE DISPOSAL
 (IF "GAS,") PRODUCTION STORAGE DEEP SHALLOW ABANDONED

LOCATION: ELEVATION 1483.20 WATERSHED JAKES RUN
 DISTRICT CLAY COUNTY MORGANTOWN

QUADRANGLE BLACKSVILLE WV-PA +15' WC

SURFACE OWNER ALBERT K. & MERLE J. EDDY ACREAGE 23.16

OIL & GAS ROYALTY OWNER _____ LEASE ACREAGE _____

LEASE NO. _____

PROPOSED WORK: DRILL CONVERT DRILL DEEPER REDRILL FRACTURE OR STIMULATE PLUG OFF OLD FORMATION PERFORATE NEW FORMATION OTHER PHYSICAL CHANGE IN WELL (SPECIFY) _____

PLUG AND ABANDON CLEAN OUT AND REPLUG

TARGET FORMATION NONE ESTIMATED DEPTH _____

WELL OPERATOR CONSOLIDATION COAL COMPANY DESIGNATED AGENT ROGER E. DUCKWORTH

ADDRESS PO BOX 1314 MORGANTOWN WV 26505 ADDRESS PO BOX 1314 MORGANTOWN WV 26505

FORM WW-6
 HALLS INC. 068065

COUNTY NAME
 PERMIT

RECEIVED
WV Division of
Environmental Protection
JAN 18 1996

AFFIDAVIT OF PLUGGING AND FILLING WELL

AFFIDAVIT SHOULD BE MADE IN TRIPLICATE, one copy mailed to the Division of Oil & Gas, one copy to be retained by the Well Operator and the third copy (and extra copies if required) should be mailed to each coal operator at their respective addresses.

Consolidation Coal Co.
Coal Operator or Owner
P.O. Box 1314 Morgantown, W.VA. 26507
Address

Consolidation Coal Co.
Name of Well Operator
P.O. Box 1314 Morgantown, W.VA. 26507
Complete Address

Consolidation Coal Co.
Coal Operator or Owner
P.O. Box 1314 Morgantown, W.VA. 26507
Address

June 17 1994

Albert K. & Merle J. Eddy
Lease or Property Owner
RT. 2 Box 109 Fairview, W.VA. 26570
Address

WELL AND LOCATION

Clay District

Monongalia County

WELL NO. M1-470

STATE INSPECTOR SUPERVISING PLUGGING

Albert K. & Merle J. Eddy Farm

Kendal Mick (Signature)

AFFIDAVIT

STATE OF WEST VIRGINIA,
County of Monongalia ss:

Larry L. Yost and Dennis L. Yost

being first duly sworn according to law depose and say that they are experienced in the work of plugging and filling oil and gas wells and were employed by Consolidation Coal Co., well operator, and participated in the work of plugging and filling the above well, that said work was commenced on the 20th day of June, 19 94, and that the well was plugged and filled in the following manner:

Sand or Zone Record Formation	Filling Material	Plugs Used Size & Kind	Casing	
			CSG PULLED 285'	CSG LEFT IN
	Pulled 285 ft. of 8 1/4" casing. Made cut in 8 1/4" casing at 1200'. Cleaned wellbore to 1460'.	8 1/4"		
	Ran coal protection string as follows: 1050 ft. of 4 1/2" casing; 314 ft. of 2 3/8" tubing; Latch down plug at 1030'; Float valve at 1050'; Swedge at 1051'. Circulated cement to surface as follows: 750 sacks of Poz Mix; 300 sacks of expanding type cement; 1,000 gal. of mud flush. Let set, bailed dry, set monument.	TOP - 1102 ft. BOTTOM - ?		
Coal Seams		Description of Monument		
(Name) <u>Pittsburgh 917-920'</u>		6 ft. of 4 1/2" casing with plaque stating Consol		
(Name)		M1-470.		
(Name)		47-61-1158-P		

and that the work of plugging and filling said well was completed on the 3rd day of June, 19 94.

And further deponents saith not.


Sworn to and subscribed before me this 17th day of JUNE, 19 94.

Larry L. Yost
Dennis L. Yost
Cheral A. Skinner

Notary Public

My commission expires:

MARCH 12, 2002

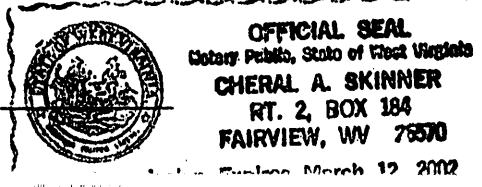

Permit No. 47-61-1158-P