


LATITUDE 39° 40' 00"

9,900

LONGITUDE 80° 17' 30"

10,390

1,985
1,88W

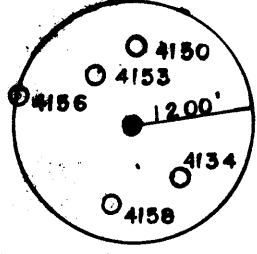


Calc 15' loc
1,985
4,10W

(+) DENOTES LOCATION OF WELL ON UNITED STATES TOPOGRAPHIC MAPS

FILE NO. _____
DRAWING NO. _____
SCALE 1" = 200'
MINIMUM DEGREE OF ACCURACY 1 IN 5000
PROVEN SOURCE OF ELEVATION COMPANY SURVEY
TIED INTO U.S.G.S. NETWORK

I THE UNDERSIGNED, HEREBY CERTIFY THAT THIS PLAT IS CORRECT TO THE BEST OF MY KNOWLEDGE AND BELIEF AND SHOWS ALL THE INFORMATION REQUIRED BY LAW AND THE REGULATIONS ISSUED AND PRESCRIBED BY THE DEPARTMENT OF ENERGY
(SIGNED) Paul D. Harbert
R.P.E. _____ L.L.S. 862

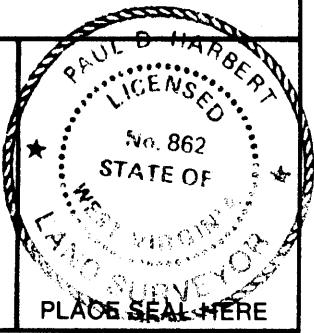

STATE OF WEST VIRGINIA
DEPARTMENT OF ENERGY
OIL AND GAS DIVISION



DATE MAY 18, 19 90
OPERATOR'S WELL NO. 4158
API WELL NO. _____

WELL TYPE: OIL ___ GAS ___ LIQUID INJECTION ___ WASTE DISPOSAL ___
(IF "GAS,") PRODUCTION ___ STORAGE ___ DEEP ___ SHALLOW X ABANDONED X
LOCATION: ELEVATION 1481.93 WATERSHED MIRACLE RUN

DISTRICT BATTELLE COUNTY MONONGALIA
QUADRANGLE WADESTOWN WV, PA Mannington EC
SURFACE OWNER LEONARD N. & FRED A. TAYLOR ACREAGE 21.00
OIL & GAS ROYALTY OWNER _____ LEASE ACREAGE _____

PROPOSED WORK: DRILL ___ CONVERT ___ DRILL DEEPER ___ REDRILL ___ FRACTURE OR STIMULATE ___ PLUG OFF OLD FORMATION ___ PERFORATE NEW FORMATION ___ OTHER PHYSICAL CHANGE IN WELL (SPECIFY) _____

PLUG AND ABANDON X CLEAN OUT AND REPLUG X
TARGET FORMATION NONE ESTIMATED DEPTH _____
WELL OPERATOR CONSOLIDATION COAL CO. DESIGNATED AGENT ROGER DUCKWORTH
ADDRESS PO BOX 1314 MORGANTOWN WV 26505 ADDRESS PO BOX 1314 MORGANTOWN WV 26505

JUN 11 1994

FORM WW-6 HALLS INC. 068065

COUNTY NAME PERMIT

JAN 18 1996

Permitting
Office of Oil & Gas

AFFIDAVIT OF PLUGGING AND FILLING WELL

AFFIDAVIT SHOULD BE MADE IN TRIPLICATE, one copy mailed to the Division, one copy to be retained by the Well Operator and the third copy (and extra copies if required) should be mailed to each coal operator at their respective addresses.

Consolidation Coal Company
Coal Operator or Owner
P. O. Box 1314, Morgantown, WV 26507-1314
Address

Coal Operator or Owner
Address
Leonard & Freda Taylor
Lease or Property Owner
221 Brookhaven Rd., Morgantown, WV 26505
Address

Consolidation Coal Company
Name of Well Operator
P.O. Box 1314, Morgantown, WV 26507-1314
Complete Address

July 06 19 94
WELL AND LOCATION
Battelle District
Monongalia County
WELL NO. 4154
Leonard & Freda Taylor Farm

STATE INSPECTOR SUPERVISING PLUGGING

Randal Micks

AFFIDAVIT

STATE OF WEST VIRGINIA,
County of Harrison

ss:

Kevin Wright and G. Andrew Lang

being first duly sworn according to law depose and say that they are experienced in the work of plugging and filling oil and gas wells and were employed by Consolidation Coal Company, well operator, and participated in the work of plugging and filling the above well, that said work was commenced on the 21st day of June, 19 94, and that the well was plugged and filled in the following manner:

Sand or Zone Record Formation	Filling Material	Plugs Used Size & Kind	Casing	
			CSC PULLED	CSC LEFT IN
Cleaned out hole with 9 7/8" bit from surface to 664'. Reduced hole to 7 7/8" and cleaned 7 7/8" hole from 664' to 1,745'. Cleaned 7 7/8" hole thru Pittsburgh Coal from 1264' to 1272'. Left 8" casing in hole from 1481' to 1745'. Left 10" casing in hole from 145' to 213'. Ran coal protection string as follows: 242.85' of 2" tubing followed by 1485.16" of 4 1/2" casing. Cemented hole from 1728.01' back to surface using 600 sacks of poz mix and 195 sacks of thixotropic cement. Latch down plug at 1417.02'. Float valve at 1485.16', swedge at 1486.16'. Cement did circulate. Used 1,000 gallons of mud flush. Displaced cement to 1417.02 with water. Let set and bailed dry.				
TOTAL DEPTH: 1,745 feet				
Coal Seams				
(Name) Pittsburgh 1,264 feet to 1,272 feet				
(Name)				
(Name)				
(Name)				
			Description of Monument 5 feet of 4 1/2" casing with plaque stating: Consol WV #4154 Permit #47-61-01160 P	

and that the work of plugging and filling said well was completed on the 28th day of June, 19 94.

And further depose and say that not.
NOTARY PUBLIC
STATE OF WEST VIRGINIA
Sworn and subscribed to by me this 6th day of July, 19 94
Charlotte Heater
Rt. 1, Box 606
Mt. Clara, WV 26408
My commission expires June 29, 1999

Kevin S. Lang
G. Andrew Lang
Charlotte Heater
Notary Public

My commission expires: June 29, 1999

47-61-01160 P