
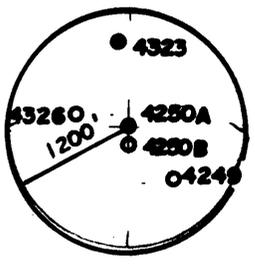


LATITUDE 39°40'00"
5000


LONGITUDE 80°20'00"
9400

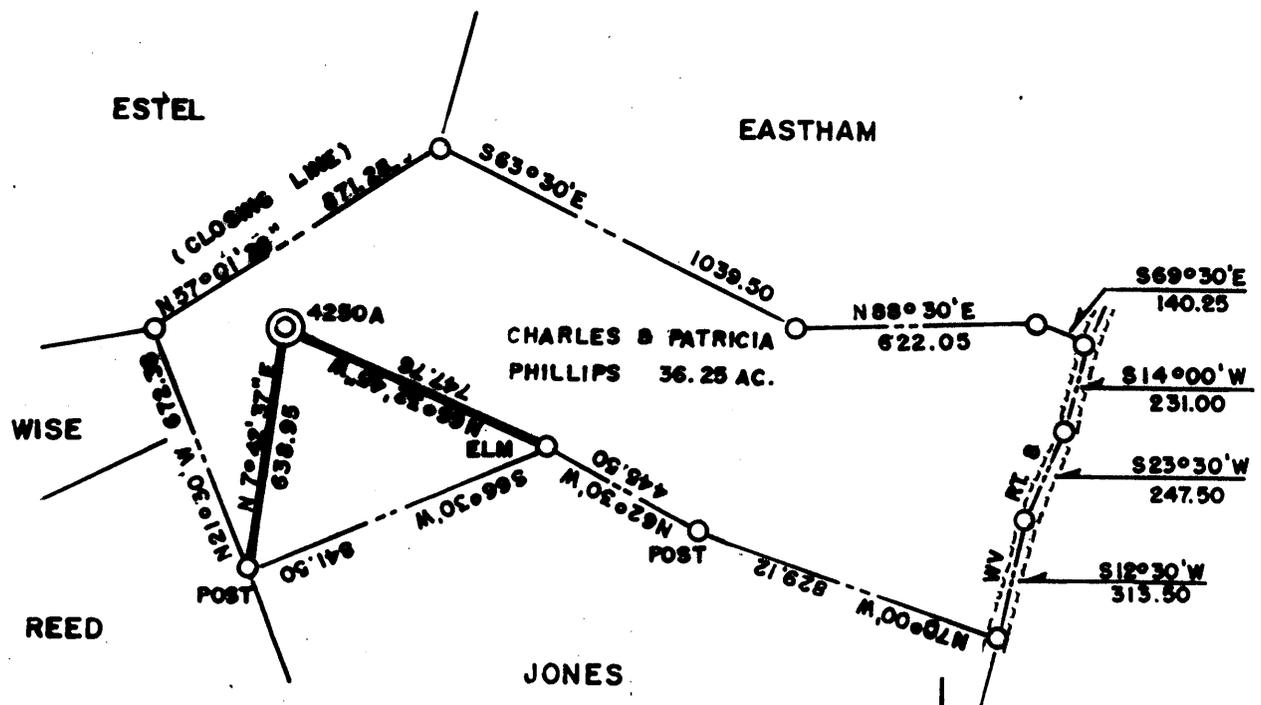

(+) DENOTES LOCATION OF WELL ON UNITED STATES TOPOGRAPHIC MAPS

FILE NO. _____
DRAWING NO. _____
SCALE 1" = 500'
MINIMUM DEGREE OF ACCURACY 1 IN 5000
PROVEN SOURCE OF ELEVATION COMPANY SURVEY TIED INTO U.S.G.S. NETWORK

I THE UNDERSIGNED, HEREBY CERTIFY THAT THIS PLAT IS CORRECT TO THE BEST OF MY KNOWLEDGE AND BELIEF AND SHOWS ALL THE INFORMATION REQUIRED BY LAW AND THE REGULATIONS ISSUED AND PRESCRIBED BY THE DEPARTMENT OF ENERGY
(SIGNED) Paul D. Harbert
R.P.E. _____ L.L.S. 862

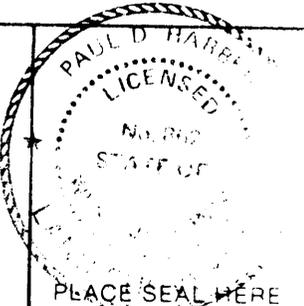

STATE OF WEST VIRGINIA
DEPARTMENT OF ENERGY
OIL AND GAS DIVISION



DATE 12-20, 1994
OPERATOR'S WELL NO. 4250 A
API WELL NO. _____

WELL TYPE: OIL ___ GAS ___ LIQUID INJECTION ___ WASTE DISPOSAL ___
(IF "GAS,") PRODUCTION ___ STORAGE ___ DEEP ___ SHALLOW X ABANDONED X
LOCATION: ELEVATION 1492.79 WATERSHED ___ RANGE ___
DISTRICT BATTELLE COUNTY MONONGALIA

QUADRANGLE WADESTOWN, WV-PA
SURFACE OWNER CHARLES D. & PATRICIA C. PHILLIPS ACREAGE 36.25 CALC.
OIL & GAS ROYALTY OWNER _____ LEASE ACREAGE _____
LEASE NO. _____

PROPOSED WORK: DRILL ___ CONVERT ___ DRILL DEEPER ___ REDRILL ___ FRACTURE OR STIMULATE ___ PLUG OFF OLD FORMATION ___ PERFORATE NEW FORMATION ___ OTHER PHYSICAL CHANGE IN WELL (SPECIFY) _____

PLUG AND ABANDON ___ CLEAN OUT AND REPLUG ___
TARGET FORMATION NONE ESTIMATED DEPTH _____
WELL OPERATOR CONSOLIDATION COAL COMPANY DESIGNATED AGENT ROGER E. DUCKWORTH
ADDRESS PO BOX 1314 MORGANTOWN WV 26505 ADDRESS PO BOX 1314 MORGANTOWN WV 26505

FORM WV-6

OWNER'S NAME
E.E.M.H.

AFFIDAVIT OF PLUGGING AND FILLING WELL

AFFIDAVIT SHOULD BE MADE IN TRIPLICATE, one copy mailed to the Division, one copy to be retained by the Well Operator and the third copy (and extra copies if required) should be mailed to each coal operator at their respective addresses.

Consolidation Coal Company
Coal Operator or Owner
P. O. Box 1314, Morgantown, WV 26507-1314
Address

Coal Operator or Owner
Address

Charles D. & Patricia C. Phillips
Lease or Property Owner
Route 1, Box 16, Wadestown, WV 26589
Address

Consolidation Coal Company
Name of Well Operator
P.O. Box 1314, Morgantown, Wv 26507-1314
Complete Address

May 31, 19 95

WELL AND LOCATION
Battelle District
Monongalia County

WELL NO. 4250-A

Charles & Patricia Phillips Farm

STATE INSPECTOR SUPERVISING PLUGGING

Randal Micker

AFFIDAVIT

STATE OF WEST VIRGINIA,
County of Harrison

ss:

G. Andrew Lang and Kevin S. Wright

being first duly sworn according to law depose and say that they are experienced in the work of plugging and filling oil and gas wells and were employed by Consolidation Coal Co., well operator, and participated in the work of plugging and filling the above well, that said work was commenced on the 10th day of May, 19 95, and that the well was plugged and filled in the following manner:

Sand or Zone Record Formation	Filling Material	Plugs Used Size & Kind	Casing	
			CSG PULLED	CSG LEFT IN
Cleaned wellbore with 9 7/8" bit from surface to 1219'.				
Reduced hole to 7 7/8" and cleaned 7 7/8" hole from 1219' to 1468'.				
Reduced hole to 6 1/4" and cleaned 6 1/4" hole from 1468' to 1813'.				
Cleaned out cement from 620' to 826'.	Cleaned 7 7/8" hole thru Pittsburg coal from 1337' to 1345'.			
Pulled 7" casing from 1219' to 1468'.	Left 7" casing in hole from 1468' to unknown.			
Ran coal protection string as follows: 255.88' of 2 3/8" tubing followed by 1527.69' of 4 1/2" casing.	Latch down plug at 1495.57'.			
Float valve at 1527.69'. Swedge at 1,528.69'.	Circulated cement to surface using 900 sacks of poz mix & cement.			
Used 1,000 gallons of mud flush.	Displaced cement to 1,495.57' with water, let set and bailed dry.			
Cemented hole from 1783.57' back to surface.				
TOTAL DEPTH: 1,813 feet				
Coal Seams		Description of Monument		
(Name) Pittsburgh	1337 feet to 1345 feet	5 feet of 4 1/2" casing with plaque stating: Consolidation		
(Name)		Coal Co. WELL 4250-A		
(Name)		Permit #47-061-1190-P		
(Name)				

and that the work of plugging and filling said well was completed on the 23rd day of May, 19 95.

And further deponents saith not.



OFFICIAL SEAL
NOTARY PUBLIC
STATE OF WEST VIRGINIA
Charlottesville
Rt. 1, Box 606
Mt. Clare, WV 26408
My commission expires June 29, 1999

Sworn to and subscribed before me this 31st day of May, 19 95.

G. Andrew Lang
Kevin S. Wright
Charlotte Deater
Notary Public

My commission expires: June 29, 1999

Permit No. 47-061-1190-P