


39°40'

LATITUDE

650

8620 LONGITUDE

80°20'

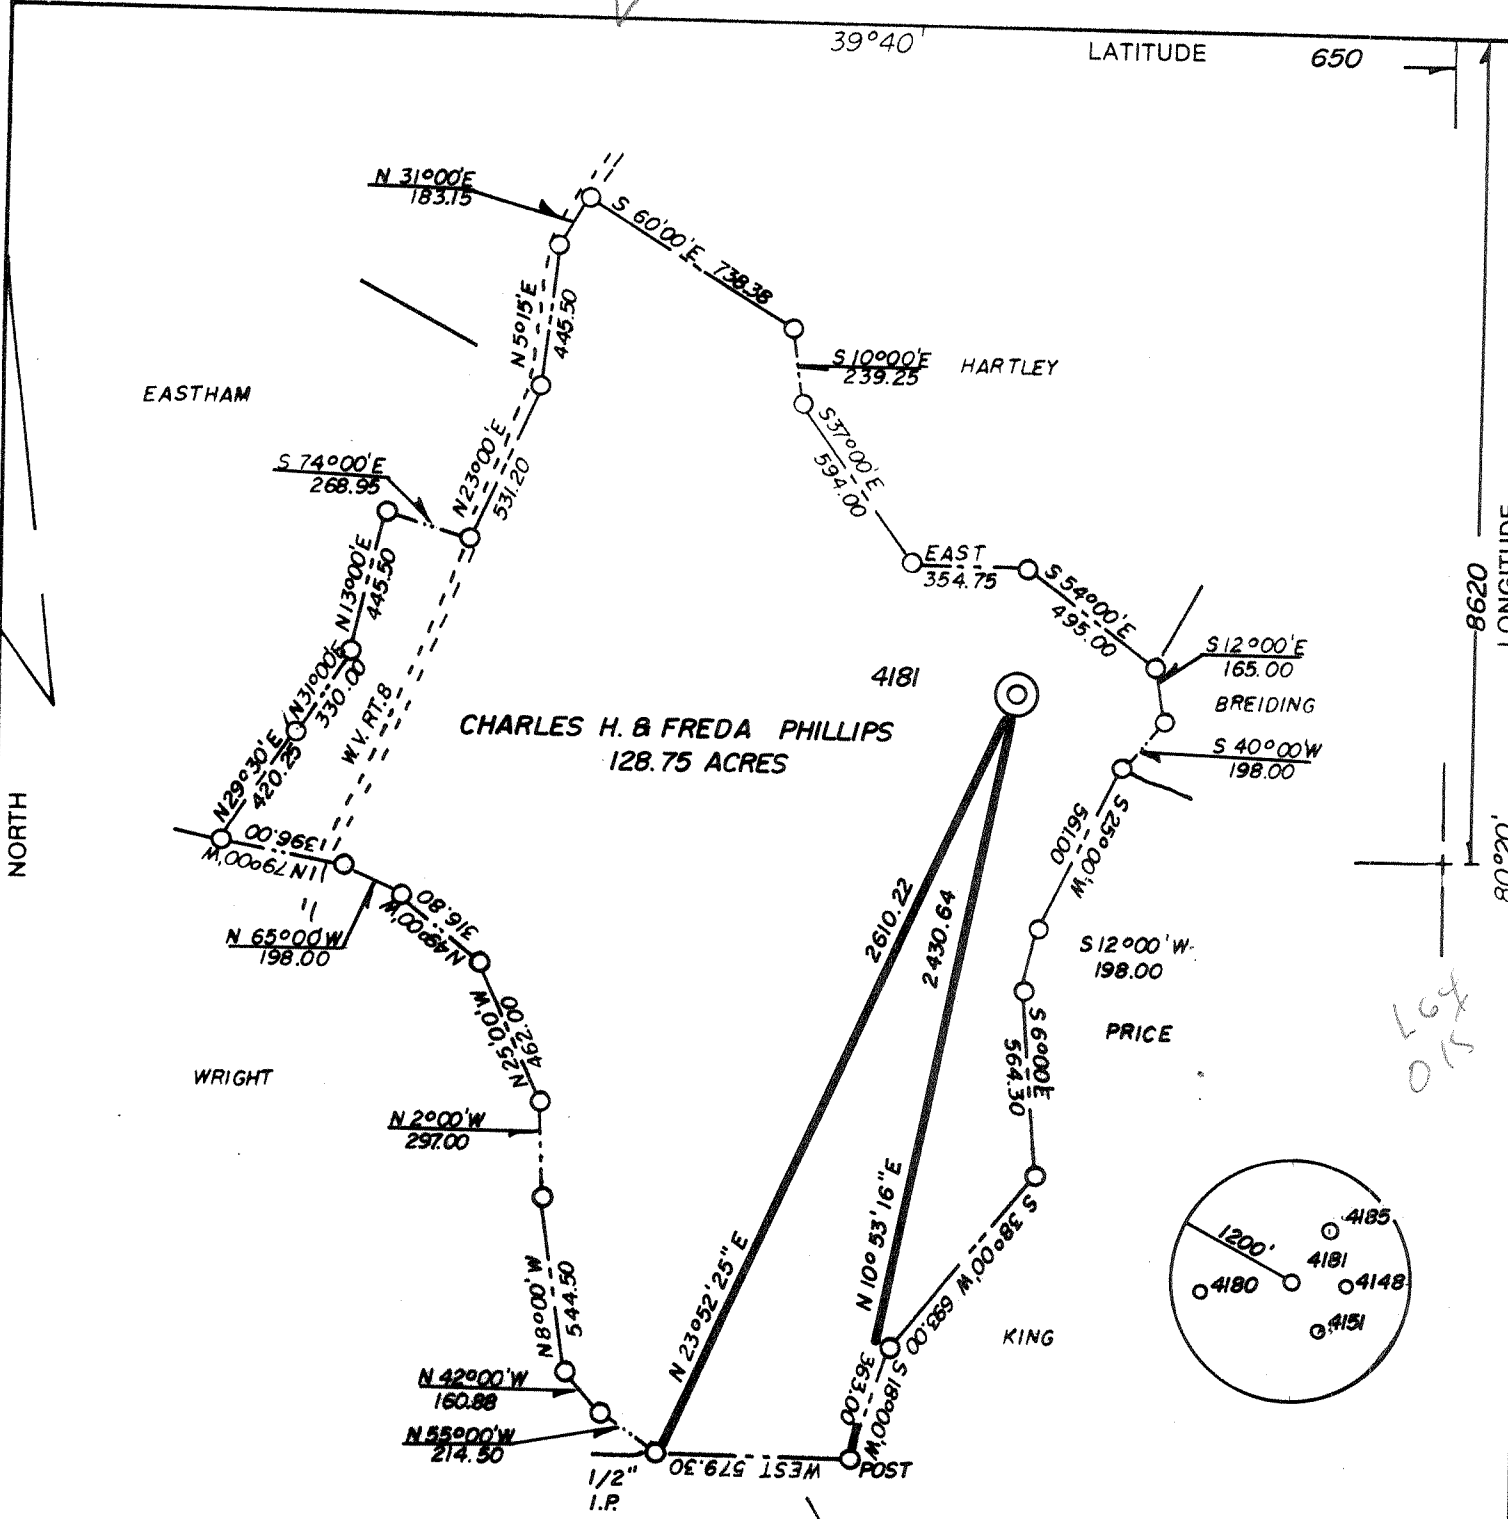

(+) DENOTES LOCATION OF WELL ON UNITED STATES TOPOGRAPHIC MAPS

FILE NO. \_\_\_\_\_  
 DRAWING NO. \_\_\_\_\_  
 SCALE 1"=600'  
 MINIMUM DEGREE OF ACCURACY 1 IN 5000  
 PROVEN SOURCE OF ELEVATION COMPANY SURVEY TIED INTO U.S.G.S. NETWORK

I THE UNDERSIGNED, HEREBY CERTIFY THAT THIS PLAT IS CORRECT TO THE BEST OF MY KNOWLEDGE AND BELIEF AND SHOWS ALL THE INFORMATION REQUIRED BY LAW AND THE REGULATIONS ISSUED AND PRESCRIBED BY THE DEPARTMENT OF ENERGY.

(SIGNED) Paul D. Harbut

R.P.E. \_\_\_\_\_ L.L.S. 862

PLACE SEAL HERE

**STATE OF WEST VIRGINIA**  
 DEPARTMENT OF ENERGY  
 OIL AND GAS DIVISION



DATE 2-27, 1992  
 OPERATOR'S WELL NO. 4181  
 API WELL NO. \_\_\_\_\_

WELL TYPE: OIL \_\_\_ GAS \_\_\_ LIQUID INJECTION \_\_\_ WASTE DISPOSAL \_\_\_  
 (IF "GAS,") PRODUCTION \_\_\_ STORAGE \_\_\_ DEEP \_\_\_ SHALLOW X ABANDONED X  
 LOCATION: ELEVATION 1460.21 WATERSHED RANGE RUN  
 DISTRICT BATTELLE COUNTY MONONGALIA

QUADRANGLE WADESTOWN

SURFACE OWNER CHARLES H. & FRED A. L. PHILLIPS ACREAGE 128.75  
 OIL & GAS ROYALTY OWNER \_\_\_\_\_ LEASE ACREAGE \_\_\_\_\_

PROPOSED WORK: DRILL \_\_\_ CONVERT \_\_\_ DRILL DEEPER \_\_\_ REDRILL \_\_\_ FRACTURE OR STIMULATE \_\_\_ PLUG OFF OLD FORMATION \_\_\_ PERFORATE NEW FORMATION \_\_\_ OTHER PHYSICAL CHANGE IN WELL (SPECIFY) \_\_\_\_\_

PLUG AND ABANDON X CLEAN OUT AND REPLUG \_\_\_\_\_  
 TARGET FORMATION NONE ESTIMATED DEPTH \_\_\_\_\_

WELL OPERATOR CONSOLIDATION COAL CO. DESIGNATED AGENT ROGER E. DUCKWORTH  
 ADDRESS P.O. BOX 1314 MORGANTOWN WV. 26505 ADDRESS P.O. BOX 1314 MORGANTOWN WV. 26505

AUG 15 1995

FORM WW-6

COUNTY NAME PERMIT

JAN 18 1996

AFFIDAVIT OF PLUGGING AND FILLING WELL

Permitting  
Office of Oil & Gas

AFFIDAVIT SHOULD BE MADE IN TRIPLICATE, one copy mailed to the Division, one copy to be retained by the Well Operator and the third copy (and extra copies if required) should be mailed to each coal operator at their respective addresses.

Consolidation Coal Company  
Coal Operator or Owner  
P.O. Box 1314, Morgantown, WV 26507-1314  
Address

Coal Operator or Owner  
Address  
Charles Phillips  
Lease or Property Owner  
Route 1, Box 8A, Wadestown, WV  
Address

Consolidation Coal Company  
Name of Well Operator  
P.O. Box 1314, Morgantown, WV 26507-1314  
Complete Address  
October 24, 19 95  
WELL AND LOCATION  
Battelle District  
Monongahia County  
WELL NO. 4181

STATE INSPECTOR SUPERVISING PLUGGING Charles Phillips Farm

AFFIDAVIT


STATE OF WEST VIRGINIA,  
County of Harrison ss:

G. Andrew Lang and Kevin S. Wright

being first duly sworn according to law depose and say that they are experienced in the work of plugging and filling oil and gas wells and were employed by Consolidation Coal Company, well operator, and participated in the work of plugging and filling the above well, that said work was commenced on the 28th day of July, 19 95, and that the well was plugged and filled in the following manner:

Sand or Zone Record Formation	Filling Material	Plugs Used Size & Kind	Casing	
			CSG PULLED	CSG LEFT IN
Cleaned 15" hole from surface to 213'. Cleaned 7 7/8" hole from 213' to 742'. Cleaned 7 7/8" hole from 742' to 1803'. Extreme difficulty in removing 10" casing. Ten inch casing (10") cut at 270', 252' and 230'. Pulled 10" casing up the hole 3'. Cut 8" casing at 1700', 1515' and 790'. Could not get 8' spear thru 10" casing. Put off 10 shots at 1500', 1510' and 10 shots at 1400', 1410', ten shots at 1350', 1300'. thirty shots at 1289' - 1299' thru Pittsburgh coal (1290' - 1298'). Ten shots at 1189' - 1199'. Cemented hole solid from 1803' back to surface using 810 sacks of poz mix and 125 sacks of thixotropic cement as follows: Sent cement plug from 1803' to 1498' with poz mix. Sent cement plug from 1498' to 1098' with thixotropic cement. Sent cement plug from 1098' to surface with poz mix. Used 1000 gallons of mud flush. Cement did circulate.				
TOTAL SOLID CEMENT PLUG: 1803 feet Coal seams				
(Name) Pittsburgh	1290 feet to 1298 feet	5 feet of 4 1/2" casing with plaque stating:		
(Name)		Consol WV Well 4181		
(Name)		Permit #47-61-01203		

and that the work of plugging and filling said well was completed on the 13th day of September, 19 95.

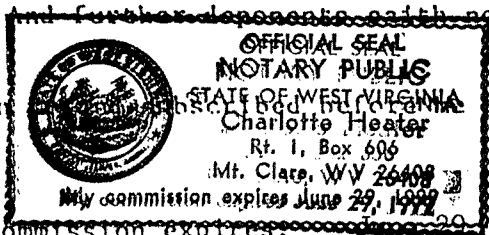

Sworn

this

24th

day of

October

19 95

Notary Public

My commission expires 1999

47-61-01203