


39°40'

LATITUDE 2,250

Will not store in past

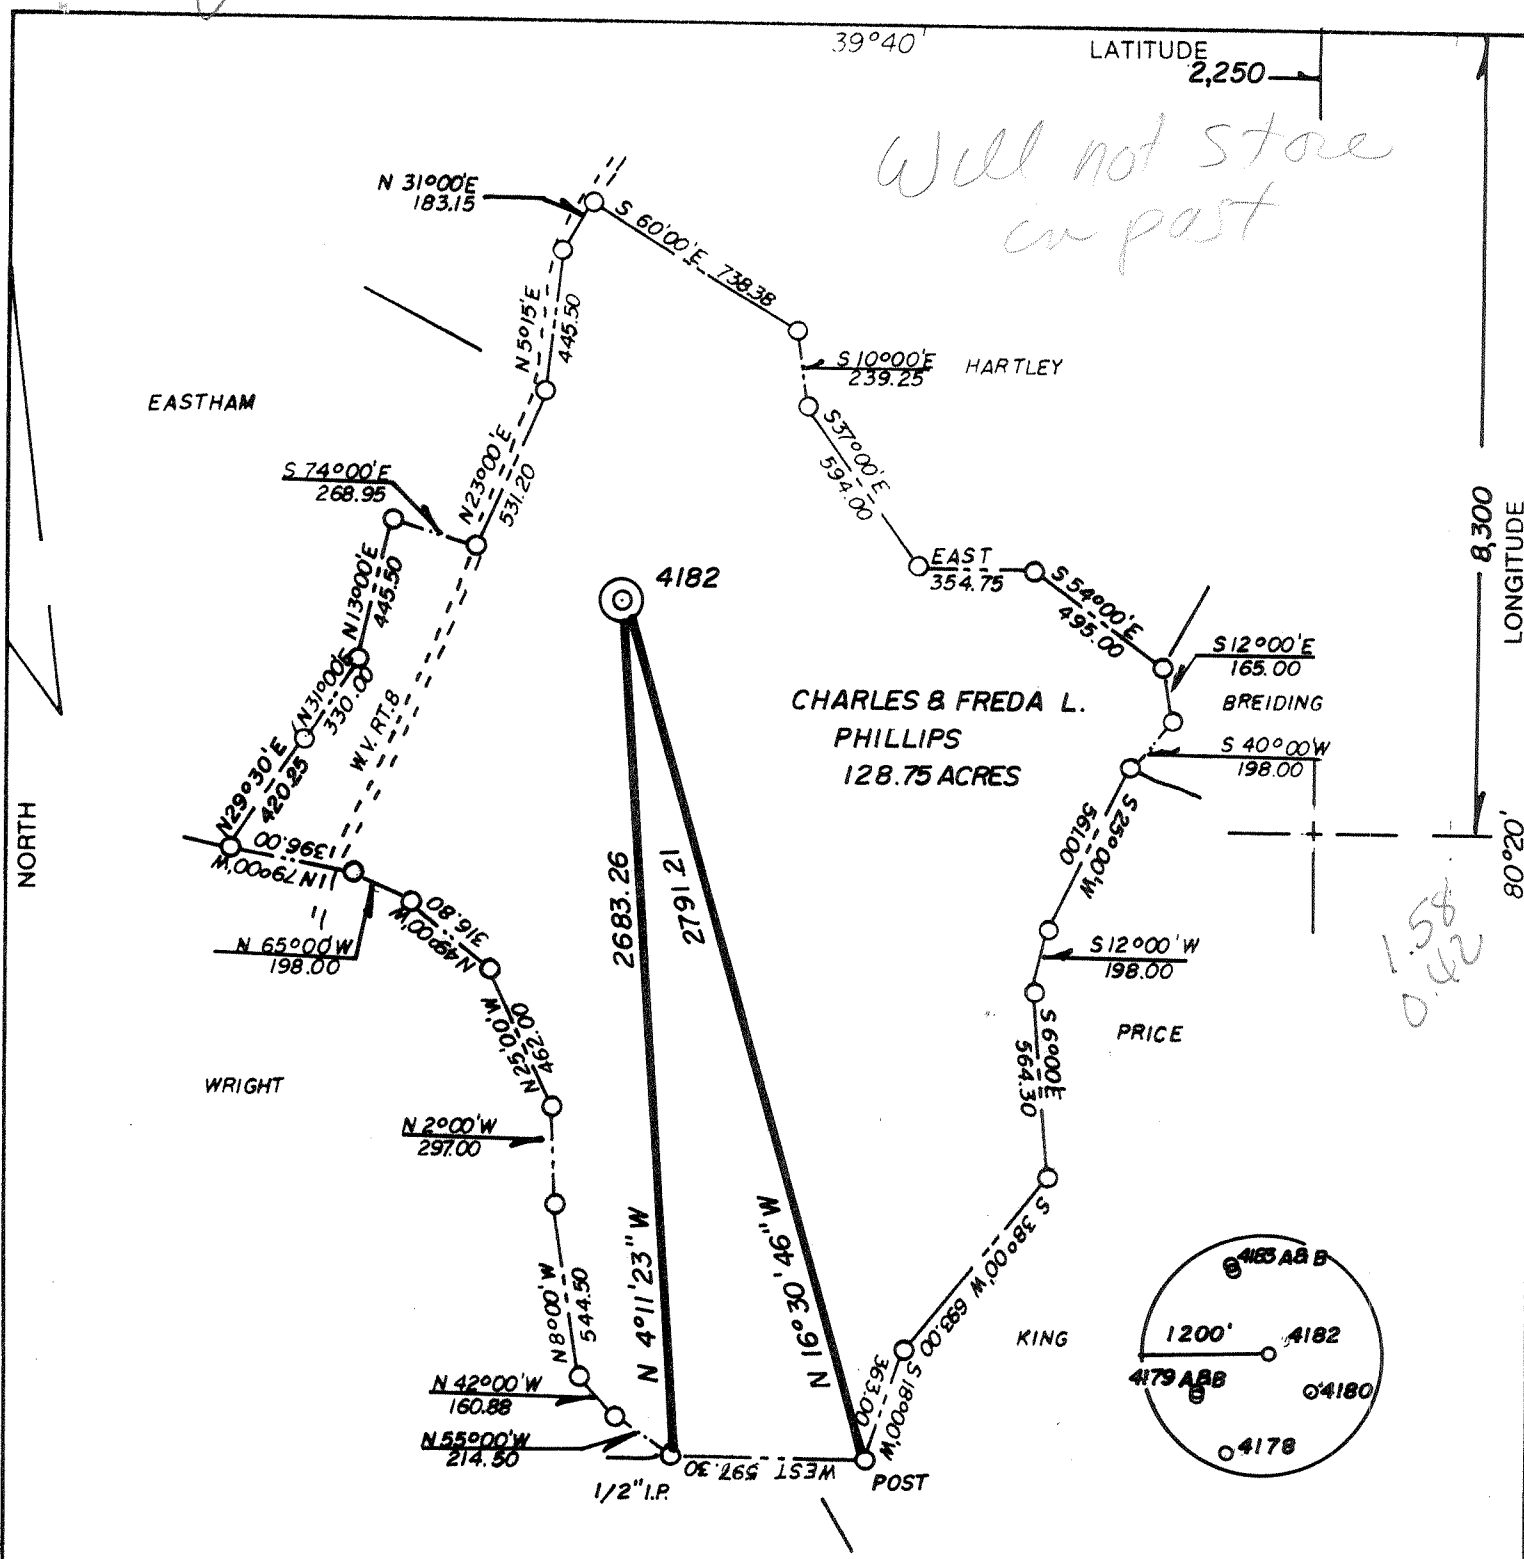

(+) DENOTES LOCATION OF WELL ON UNITED STATES TOPOGRAPHIC MAPS

FILE NO. _____
 DRAWING NO. _____
 SCALE 1" = 600'
 MINIMUM DEGREE OF ACCURACY 1 IN 5000
 PROVEN SOURCE OF ELEVATION COMPANY SURVEY TIED INTO U.S.G.S. NETWORK

I THE UNDERSIGNED, HEREBY CERTIFY THAT THIS PLAT IS CORRECT TO THE BEST OF MY KNOWLEDGE AND BELIEF AND SHOWS ALL THE INFORMATION REQUIRED BY LAW AND THE REGULATIONS ISSUED AND PRESCRIBED BY THE DEPARTMENT OF ENERGY.
 (SIGNED) Paul D. Harlet
 R.P.E. _____ L.L.S. 862

PLACE SEAL HERE

STATE OF WEST VIRGINIA
DEPARTMENT OF ENERGY
OIL AND GAS DIVISION



DATE 3-27, 19 92
 OPERATOR'S WELL NO. 4182
 API WELL NO. 47-61-01204-8

WELL TYPE: OIL ___ GAS ___ LIQUID INJECTION ___ WASTE DISPOSAL ___ STATE COUNTY PERMIT
 (IF "GAS,") PRODUCTION ___ STORAGE ___ DEEP ___ SHALLOW X ABANDONED X *plugged 8-16-85 via DEP*

LOCATION: ELEVATION 1272.52 WATERSHED RANGE RUN
 DISTRICT BATTELLE COUNTY MONONGALIA
 QUADRANGLE WADESTOWN

SURFACE OWNER CHARLES H. & FREDA L. PHILLIPS ACREAGE 128.75
 OIL & GAS ROYALTY OWNER _____ LEASE ACREAGE _____
 LEASE NO. _____

PROPOSED WORK: DRILL ___ CONVERT ___ DRILL DEEPER ___ REDRILL ___ FRACTURE OR STIMULATE ___ PLUG OFF OLD FORMATION ___ PERFORATE NEW FORMATION ___ OTHER PHYSICAL CHANGE IN WELL (SPECIFY) _____

PLUG AND ABANDON ___ CLEAN OUT AND REPLUG ___
 TARGET FORMATION NONE ESTIMATED DEPTH _____

WELL OPERATOR CONSOLIDATION COAL CO. DESIGNATED AGENT ROGER E. DUCKWORTH
 ADDRESS P.O. BOX 1314 MORGANTOWN WV 26505 ADDRESS P.O. BOX 1314 MORGANTOWN W.V. 26505

FORM WW-6

COUNTY NAME PERMIT

JAN 18 1996

Permitting
Office of Oil & Gas

AFFIDAVIT OF PLUGGING AND FILLING WELL

AFFIDAVIT SHOULD BE MADE IN TRIPLICATE, one copy mailed to the Division, one copy to be retained by the Well Operator and the third copy (and extra copies if required) should be mailed to each coal operator at their respective addresses.

Consolidation Coal Company
Coal Operator or Owner
P.O. Box 1314, Morgantown, WV 26507-1314
Address

Consolidation Coal Company
Name of Well Operator
P.O. Box 1314, Morgantown, WV 26507-1314
Complete Address

Coal Operator or Owner
Address

October 24, 19 95
WELL AND LOCATION
Battelle District

Charles Phillips
Lease or Property Owner
Rt. 1, Box 8A, Wadestown, WV
Address

Monongalia County
WELL NO. 4182

Charles Phillips Farm

STATE INSPECTOR SUPERVISING PLUGGING

Randal Muck
AFFIDAVIT

STATE OF WEST VIRGINIA,
County of Harrison

ss:

G. Andrew Lang and Kevin S. Wright

being first duly sworn according to law depose and say that they are experienced in the work of plugging and filling oil and gas wells and were employed by Consolidation Coal Company, well operator, and participated in the work of plugging and filling the above well, that said work was commenced on the 3rd day of August, 19 95, and that the well was plugged and filled in the following manner:

Sand or Zone Record Formation	Filling Material	Plugs Used Size & Kind	Casing	
			CSG PULLED	CSG LEFT IN
Cleaned hole with 9 7/8" bit from surface to 1270'. Reduced hole to 6 1/2" and cleaned 6 1/2" hole from 1270' to 1594'. Pulled 7" casing from 1024' to 1380'. Left 7" casing in hole from 1380' to unknown. Cleaned 9 7/8" hole thru Pittsburgh coal from 1112' to 1118'. Ran coal protection string as follows: 284.03' of 2 3/8" tubing followed by 1295.49' of 4 1/2" casing. Latch down plug at 1274.48'. Float valve at 1295.49'. Swedge at 1296.49'. Circulated cement from 1579.52' back to surface using 460 sacks of poz mix and 210 sacks of thixotropic cement. Used 1,000 gallons of mud flush. Displaced cement to 1274.48' with water let set and bailed dry.				
TOTAL DEPTH: 1594 feet				
Coal Seams			Description of Monument	
(Name) Pittsburgh	1112' to 1118'		5 feet of 4 1/2" casing with plaque stating: Consol WV Well #4182 Permit #47-061-1204 P	

and that the work of plugging and filling said well was completed on the 16th day of August, 19 95.

And further deponents saith not.

Sworn to before me this 24th day of October, 19 95
My commission expires June 29, 1999



OFFICIAL SEAL
NOTARY PUBLIC
STATE OF WEST VIRGINIA
Charlotte Heater
Rt. 1, Box 606
Mt. Clare, WV 26408

Kevin S. Wright
G. Andrew Lang
Charlotte Heater
Notary Public