



West Virginia Department of Environmental Protection  
Office of Oil and Gas  
**WELL LOCATION FORM: GPS**

API: 4706101209 WELL NO.: 005132

FARM NAME: Statler Helen, John

RESPONSIBLE PARTY NAME: CNX

COUNTY: Monongalia DISTRICT: Battelle

QUADRANGLE: Wadestown

SURFACE OWNER: CNX Land LLC

ROYALTY OWNER: CNX Land LLC

UTM GPS NORTHING: 4394064.20

UTM GPS EASTING: 559612.76 GPS ELEVATION: 1199.75

The Responsible Party named above has chosen to submit GPS coordinates in lieu of preparing a new well location plat for a plugging permit or assigned API number on the above well. The Office of Oil and Gas will not accept GPS coordinates that do not meet the following requirements:

1. Datum: NAD 1983, Zone: 17 North, Coordinate Units: meters, Altitude: height above mean sea level (MSL) – meters.
2. Accuracy to Datum – 3.05 meters
3. Data Collection Method:

Survey grade GPS  : Post Processed Differential \_\_\_\_\_

Real-Time Differential

Mapping Grade GPS \_\_\_\_\_ : Post Processed Differential \_\_\_\_\_

Real-Time Differential \_\_\_\_\_

4. Letter size copy of the topography map showing the well location.

I the undersigned, hereby certify this data is correct to the best of my knowledge and belief and shows all the information required by law and the regulations issued and prescribed by the Office of Oil and Gas.


[Signature]  
Signature

Project Manager  
Title

12-3-20  
Date

03/12/2021

RECEIVED  
Office of Oil and Gas  
DEC 10 2020  
WV Department of  
Environmental Protection

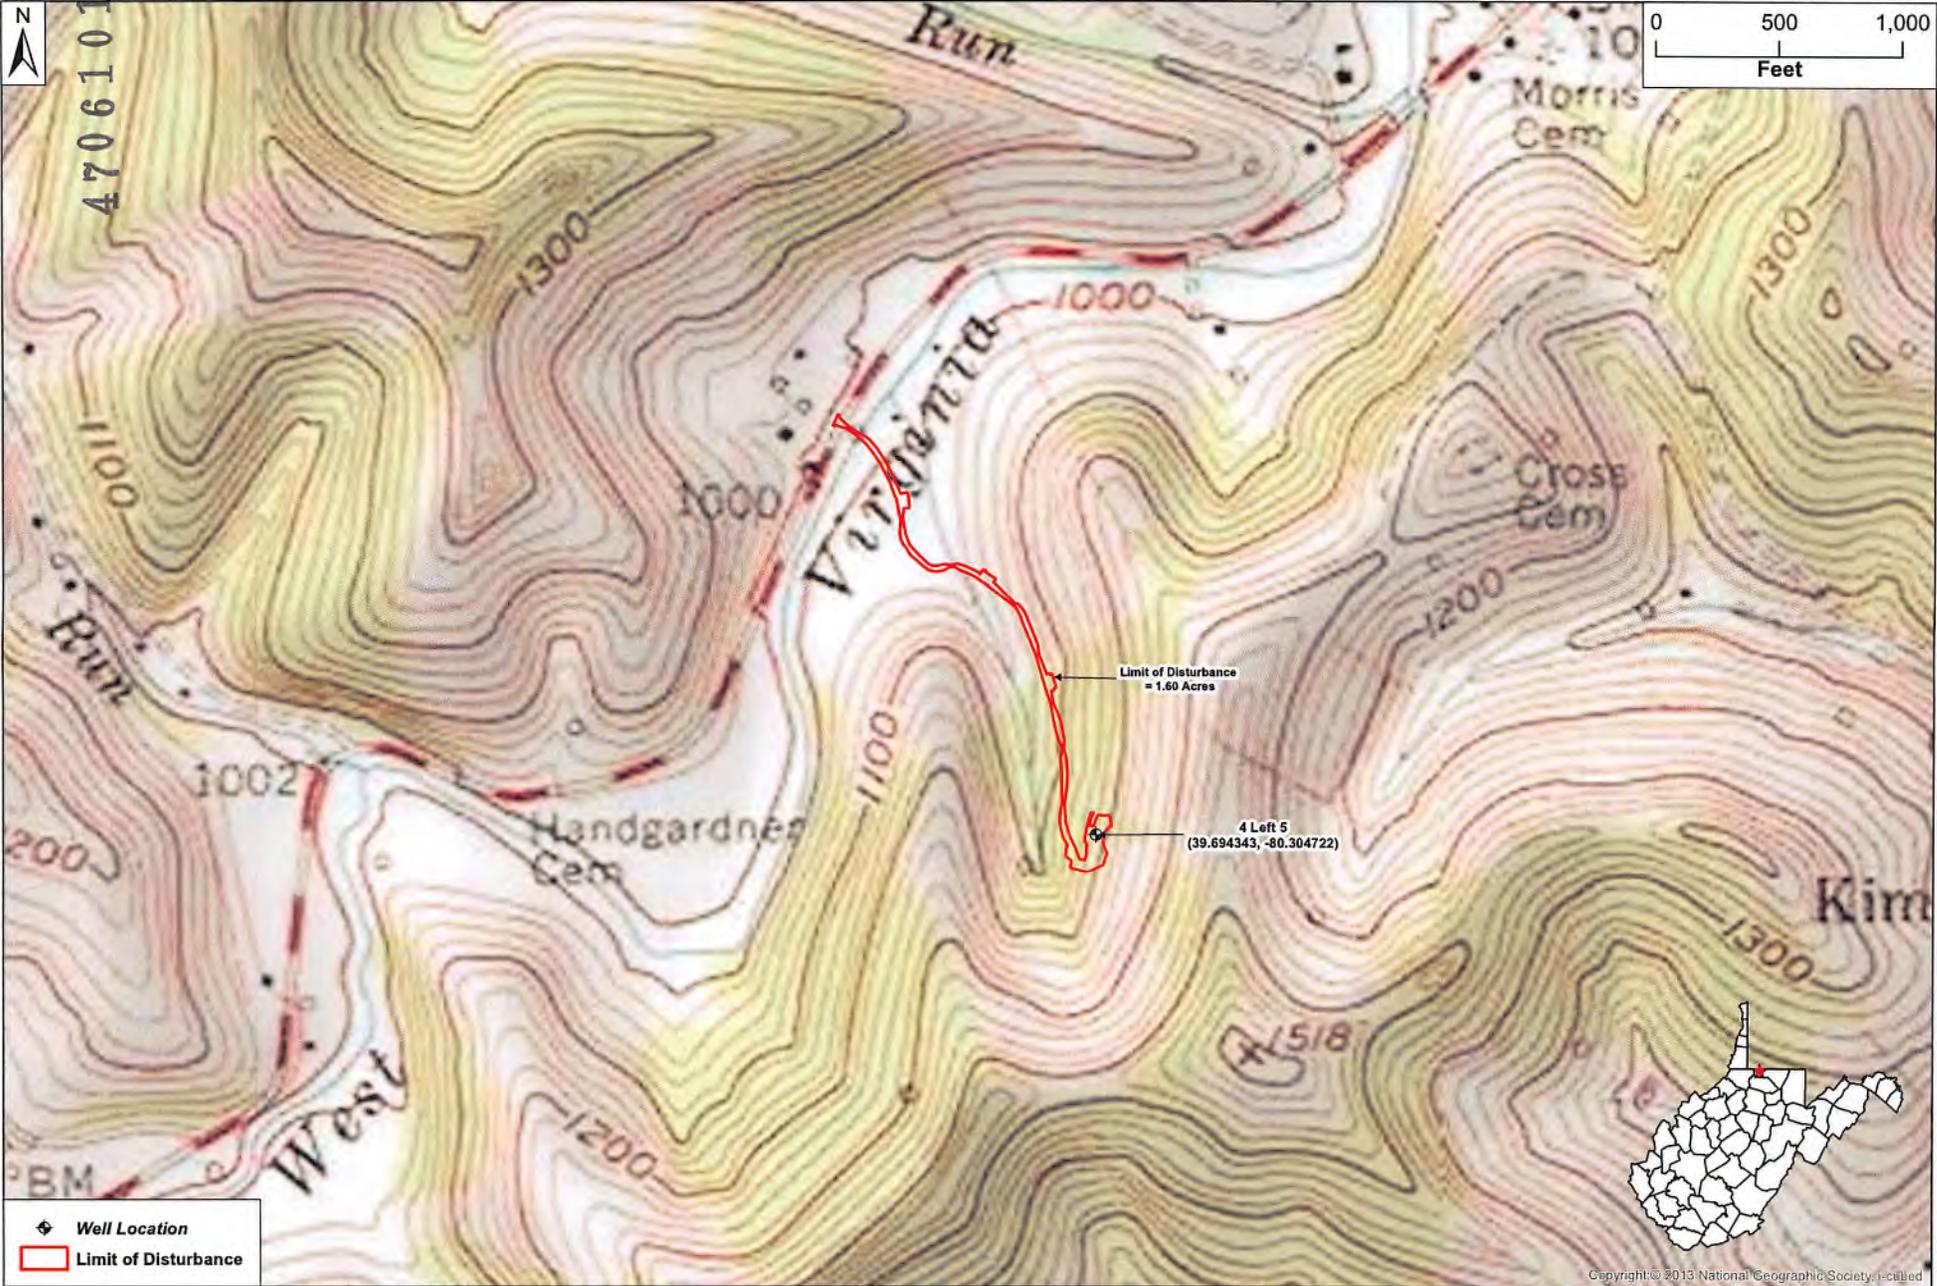

4706101209P



**4 Left 5 (005132) Well Head**  
 Site Location Topographic Map  
 Monongalia County, West Virginia



Date: 11/19/21  
 By: J. Stascak

Copyright © 2013 National Geographic Society. All rights reserved.