


(+) DENOTES LOCATION OF WELL ON UNITED STATES TOPOGRAPHIC MAPS

FILE NO. \_\_\_\_\_  
 DRAWING NO. \_\_\_\_\_  
 SCALE 1" = 500'  
 MINIMUM DEGREE OF ACCURACY 1 IN 5000  
 PROVEN SOURCE OF ELEVATION COMPANY SURVEY TIED INTO U.S.G.S. NETWORK

I THE UNDERSIGNED, HEREBY CERTIFY THAT THIS PLAT IS CORRECT TO THE BEST OF MY KNOWLEDGE AND BELIEF AND SHOWS ALL THE INFORMATION REQUIRED BY LAW AND THE REGULATIONS ISSUED AND PRESCRIBED BY THE DEPARTMENT OF ENERGY  
 (SIGNED) Paul D. Hubert  
 R.P.E. \_\_\_\_\_ L.L.S. 862

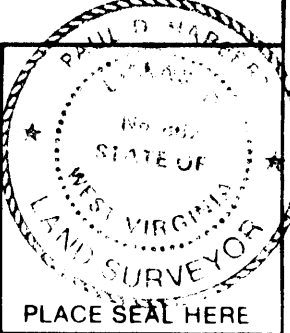

**STATE OF WEST VIRGINIA**  
 DEPARTMENT OF ENERGY  
 OIL AND GAS DIVISION

DATE 1-11 1995  
 OPERATOR'S WELL NO. 4323  
 API WELL NO. 47-61-01222-P

WELL TYPE: OIL  GAS  LIQUID INJECTION  WASTE DISPOSAL   
 (IF "GAS,") PRODUCTION  STORAGE  DEEP  SHALLOW  **ABANDONED**

LOCATION: ELEVATION 1376.34 WATERSHED SOUTH FORK  
 DISTRICT BATTELLE COUNTY MONONGALIA  
 QUADRANGLE WADESTOWN, WV - PA

SURFACE OWNER ROBERT W. ESTEL ACREAGE 60.14 CALC.  
 OIL & GAS ROYALTY OWNER \_\_\_\_\_ LEASE ACREAGE \_\_\_\_\_  
 LEASE NO. \_\_\_\_\_

PROPOSED WORK: DRILL  CONVERT  DRILL DEEPER  REDRILL  FRACTURE OR STIMULATE  PLUG OFF OLD FORMATION  PERFORATE NEW FORMATION  OTHER PHYSICAL CHANGE IN WELL (SPECIFY) \_\_\_\_\_

PLUG AND ABANDON  CLEAN OUT AND REPLUG

TARGET FORMATION NONE ESTIMATED DEPTH \_\_\_\_\_

WELL OPERATOR CONSOLIDATION COAL COMPANY DESIGNATED AGENT ROGER E. DUCKWORTH  
 ADDRESS P.O. BOX 1314 MORGANTOWN, WV 26505 ADDRESS P.O. BOX 1314 MORGANTOWN, WV 26505

FORM WW-6

COUNTY NAME PERMIT

AFFIDAVIT OF PLUGGING AND FILLING WELL

WV Division of  
Environmental Protection

AFFIDAVIT SHOULD BE MADE IN TRIPLICATE, one copy mailed to the Division, one copy to be retained by the Well Operator and the third copy (and extra copies if required) should be mailed to each coal operator at their respective addresses.

Consolidation Coal Company  
Coal Operator or Owner  
P.O. Box 1314, Morgantown, WV 26507-1314  
Address

Consolidation Coal Co.  
Name of Well Operator  
P.O. Box 1314, Morgantown, WV 26507-1314  
Complete Address

Coal Operator or Owner  
Address

April 08, 19 96  
WELL AND LOCATION

Robert W. Estel  
Lease or Property Owner  
Burton, WV 26562  
Address

Battelle District  
Monongalia County  
WELL NO. 4323

STATE INSPECTOR SUPERVISING PLUGGING Robert W. Estel Farm  
*Randal Muck*

AFFIDAVIT

STATE OF WEST VIRGINIA,  
County of Harrison  
G. Andrew Lang

ss:


and Kevin W. Wright

being first duly sworn according to law depose and say that they are experienced in the work of plugging and filling oil and gas wells and were employed by Consolidation Coal Co., well operator, and participated in the work of plugging and filling the above well, that said work was commenced on the 18th day of March, 19 96, and that the well was plugged and filled in the following manner:

Sand or Zone Record Formation	Filling Material	Plugs Used Size & Kind	Casing	
			CSG PULLED	CSG LEFT IN
Pulled 7" casing from surface to 1464'. Seven in casing was seperated from 1,114' to 1,215'. Left 7" casing in hole from 1464' to unknown. Cleaned hole with 9 7/8" bit from surface to 1,338'. Reduced hole to 6 1/4" and cleaned 6 1/4" hole from 1338' to 1720'. Cleaned 7 7/8" hole thru Pittsburgh Coal. from 1225' to 1233'. Ran coal protection string as follows: 284.90' of 2 3/8" tubing followed by 1417.42' of 4 1/2" casing. Cemented hole from 1703.32' back to surface with 800 sacks of poz mix and 145 sacks of thixotropic cement. Latch down plug at 1383.72'. Float valve at 1417.42'. Swedge at 1418.42'. Cement did circulate. Used 1,000 gallons of mud flush. Displaced cement to 1383.72' with water let set and bailed dry. Cement did circulate.	7" csg	394.42'		
TOTAL DEPTH: 1,720 feet				
Coal Seams			Description of Monument	
(Name) Pittsburgh	1225' to 1233'		5' of 4 1/2" casing with plaque stating: Consolidation Coal Co. Well 4323	
(Name)			Permit #47-061-1222-P	

and that the work of plugging and filling said well was completed on the 28th day of March, 19 96.

And further deponents saith not.

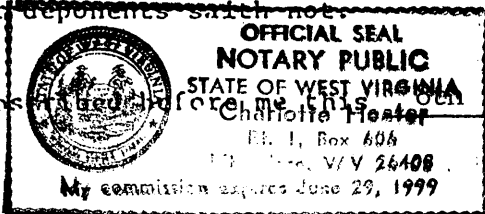

Sworn to and subscribed before me this 08th day of April, 19 96.

*G. Andrew Lang*  
*Kevin Wright*  
*Charlotte Heister*  
Notary Public  
OCT 08 1997

My commission expires: