

(+) DENOTES LOCATION OF WELL ON UNITED STATES TOPOGRAPHIC MAPS

FILE NO. \_\_\_\_\_  
 DRAWING NO. \_\_\_\_\_  
 SCALE 1" = 300'  
 MINIMUM DEGREE OF ACCURACY 1 IN 5000  
 PROVEN SOURCE OF ELEVATION COMPANY SURVEY  
TIED INTO U.S.G.S. NETWORK

I THE UNDERSIGNED, HEREBY CERTIFY THAT THIS PLAT IS CORRECT TO THE BEST OF MY KNOWLEDGE AND BELIEF AND SHOWS ALL THE INFORMATION REQUIRED BY LAW AND THE REGULATIONS ISSUED AND PRESCRIBED BY THE DEPARTMENT OF ENERGY.  
 (SIGNED) Paul D. Harbert  
 R.P.E. \_\_\_\_\_ L.L.S. 862

PLACE SEAL HERE

**STATE OF WEST VIRGINIA**  
 DEPARTMENT OF ENERGY  
 OIL AND GAS DIVISION

DATE 10-12 19 94  
 OPERATOR'S WELL NO. 4252 B  
 API WELL NO. 47-61-01228-P

WELL TYPE: OIL \_\_\_ GAS \_\_\_ LIQUID INJECTION \_\_\_ WASTE DISPOSAL \_\_\_  
 (IF "GAS,") PRODUCTION \_\_\_ STORAGE \_\_\_ DEEP \_\_\_ SHALLOW X ABANDONED X

LOCATION: ELEVATION 1382.16 WATERSHED RANGE RUN  
 DISTRICT BATTELLE COUNTY MONONGALIA  
 QUADRANGLE WADESTOWN WV-PA

SURFACE OWNER JOHN W. & SHIRLEY JONES ACREAGE 30.00  
 OIL & GAS ROYALTY OWNER \_\_\_\_\_ LEASE ACREAGE \_\_\_\_\_  
 LEASE NO. \_\_\_\_\_

PROPOSED WORK: DRILL \_\_\_ CONVERT \_\_\_ DRILL DEEPER \_\_\_ REDRILL \_\_\_ FRACTURE OR  
 STIMULATE \_\_\_ PLUG OFF OLD FORMATION \_\_\_ PERFORATE NEW  
 FORMATION \_\_\_ OTHER PHYSICAL CHANGE IN WELL (SPECIFY) \_\_\_\_\_

PLUG AND ABANDON \_\_\_ CLEAN OUT AND REPLUG \_\_\_  
 TARGET FORMATION NONE ESTIMATED DEPTH \_\_\_\_\_  
 WELL OPERATOR CONSOLIDATION COAL COMPANY DESIGNATED AGENT ROGER E. DUCKWORTH  
 ADDRESS P.O. BOX 1314 MORGANTOWN, WY 26505 ADDRESS P.O. BOX 1314 MORGANTOWN, WY 26505

FORM W.V.-6

COUNTY NAME PERMIT

AFFIDAVIT OF PLUGGING AND FILLING WELL

AFFIDAVIT SHOULD BE MADE IN TRIPLICATE, one copy mailed to the Division, one copy to be retained by the Well Operator and the third copy (and extra copies if required) should be mailed to each coal operator at their respective addresses.

CONSOLIDATION COAL COMPANY  
Coal Operator or Owner  
P.O. BOX 1314, MORGANTOWN, WV 26507-1314  
Address  
Coal Operator or Owner  
Address  
JOHN & SHIRLEY JONES  
Lease or Property Owner  
Address

CONSOLIDATION COAL COMPANY  
Name of Well Operator  
P.O. BOX 1314, MORGANTOWN, WV 26507-1314  
Complete Address  
OCTOBER 11 1996  
WELL AND LOCATION  
BATTELLE District  
MONONGALIA County  
WELL NO. 4252-B

JOHN & SHIRLEY JONES Farm

STATE INSPECTOR SUPERVISING PLUGGING Ronald Meigs

AFFIDAVIT

STATE OF WEST VIRGINIA,

County of HARRISON

ss:

G. ANDREW LANG

and KEVIN WRIGHT


Kevin Wright

being first duly sworn according to law depose and say that they are experienced in the work of plugging and filling oil and gas wells and were employed by CONSOLIDATION COAL COMPANY, well operator, and participated in the work of plugging and filling the above well, that said work was commenced on the 24TH day of SEPTEMBER, 1996, and that the well was plugged and filled in the following manner:

Sand or Zone Record Formation	Filling Material	Plugs Used Size & Kind	Casing	
			CSG PULLED	CSG LEFT IN
Cleaned 9 7/8" hole to 1,369'. 1,616'. Left 8" casing in hole	Reduced hole to 7 7/8". 1,376 - 1,537'. Ran coal protection string as	Cleaned 7 7/8" to		
follows; 185.45" of 2 3/8" tubing	tubing followed by 1,406.63 of 4 1/2" casing.			
Cemented hole from 1,616' back	to surface using 690 sacks of	poz mix and		
150 sacks of thixotropic cement.	Use 1,000 gallons of mud.	Flush. Latch		
down plug at 1,375.63'. Float	valve at 1,406.43'. Cement did circulate.			
Displaced cement to 1,375.63' with water; let set and bailed	dry.			
TOTAL DEPTH: 1,616'.				
Coal Seams		Description of Monument		
(Name) PITTSBURGH	1,220' TO 1,227'	5' OF 4 1/2" CASING WITH		
(Name)		PLAQUE STATING CONSOLIDATION		
(Name)		COAL C. WELL #4252-B		
(Name)		PERMIT # 47-61-01228-P		

and that the work of plugging and filling said well was completed on the 8TH day of OCTOBER, 1996.

And further deponents saith not.

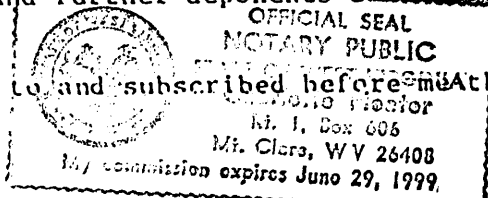

Sworn to and subscribed before me this 11TH day of OCTOBER, 1996.

G. Andrew Lang  
Kevin Wright  
Charlotte Weaver  
Notary Public

My commission expires:

47-61-01228-P