


39° 40' 00"

LATITUDE

6770'

*James
C. Hill*

LONGITUDE
8100'
80' 20' 00"

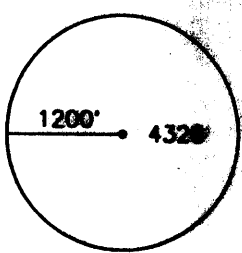

NORTH

W.V. Rt. 9

Paul S. Delaney et. al.

11.80 ACRES

Frances S. Hillberry

Judith Anderson

S 48°30' W
1435.94'

Walter & Mary Watson

WELL 4328

FENCE POST

FENCE POST CORNER

S 68°42'00" W
392.12'

William T. Estel


N 22°57'09" E
313.95'

S 48°30' W
651.25'

I THE UNDERSIGNED, HEREBY CERTIFY THAT THIS PLAT IS CORRECT TO THE BEST OF MY KNOWLEDGE AND BELIEF AND SHOWS ALL THE INFORMATION REQUIRED BY LAW AND THE REGULATIONS ISSUED AND PRESCRIBED BY THE DEPARTMENT OF ENERGY.

P.S. 806

Robert A. Andriotto

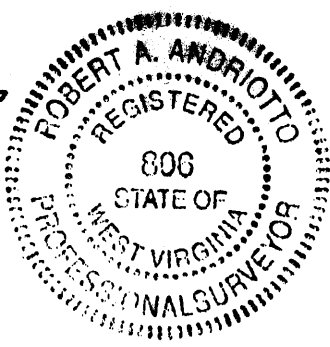

(+) DENOTES LOCATION OF WELL ON UNITED STATES TOPOGRAPHIC MAPS.

DATE May 28 19 96

OPERATORS WELL NO. 4328

API WELL NO. 47 - 061 - 01243-P

STATE COUNTY PERMIT

MINIMUM DEGREE OF ACCURACY 1 / 200 FILE NO. _____ SCALE 1" = 300' PROVEN SOURCE OF ELEVATION COMPANY NETWORK TIED INTO U.S.G.S.

STATE OF WEST VIRGINIA DEPARTMENT OF ENERGY OIL AND GAS DIVISION



WELL TYPE : OIL _____ GAS _____ LIQUID INJECTION _____ WASTE DISPOSAL _____ "GAS" PRODUCTION _____ STORAGE _____ DEEP _____ SHALLOW _____

LOCATION : ELEVATION 1104.2 WATERSHED South Fork of the W.V. Fork of Duckard Creek

DISTRICT Bottle COUNTY Monongalia QUADRANGLE WADESTOWN 7.5

SURFACE OWNER Paul S. Delaney et. al. ACREAGE 11.8

ROYALTY OWNER _____ LEASE ACREAGE _____ LEASE NO. _____

PROPOSED WORK : DRILL _____ CONVERT _____ DRILL DEEPER _____ REDRILL _____ FRACTURE OR STIMULATE _____ PLUG OFF OLD _____

FORMATION _____ PERFORATE NEW FORMATION _____ PLUG AND ABANDON X CLEAN OUT AND REPLUG _____ OTHER _____

PHYSICAL CHANGE IN WELL (SPECIFY) _____ TARGET FORMATION _____ ESTIMATED DEPTH _____

WELL OPERATOR CONSOLIDATION COAL CO. DESIGNATED AGENT ROGER E. DUCKWORTH ADDRESS P.O. BOX 100 OSAGE, WV 26543 ADDRESS P.O. BOX 100 OSAGE, WV 26543

COUNTY NAME PERMIT

STATE OF WEST VIRGINIA
DEPARTMENT OF ENERGY
OIL AND GAS WELLS DIVISION

AFFIDAVIT OF PLUGGING AND FILLING WELL

AFFIDAVIT SHOULD BE MADE IN TRIPPLICATE, one copy mailed to the Division, one copy to be retained by the Well Operator and the third copy (and extra copies if required) should be mailed to each coal operator at their respective addresses.

CONSOLIDATION COAL COMPANY
Coal Operator or Owner
P.O. BOX 100 OSAGE, WV, 26453
Address
Coal Operator or Owner
Address
PAUL S. DELANEY
Lease or Property Owner
Address

CONSOLIDATION COAL COMPANY
Name of Well Operator
P.O. BOX 100, OSAGE, WV, 26453
Complete Address
OCTOBER 16 1996
WELL AND LOCATION
BATTELLE District
MONONGALIA County
WELL NO. 4328

PAUL S. DELANEY Farm
STATE INSPECTOR SUPERVISING PLUGGING [Signature]
AFFIDAVIT

STATE OF WEST VIRGINIA,
County of HARRISON

ss:

G. ANDREW LANG and Stephan Moats

being first duly sworn according to law depose and say that they are experienced in the work of plugging and filling oil and gas wells and were employed by CONSOLIDATION COAL COMPANY, well operator, and participated in the work of plugging and filling the above well, that said work was commenced on the 29TH day of JULY, 1996, and that the well was plugged and filled in the following manner:

Sand or Zone Record Formation	Filling Material	Plugs Used Size & Kind	Casing	
			CSG PULLED	CSG LEFT IN
Clean 9 7/8" hole from surface to 1,056'. Reduce hole to 7 7/8". Clean 7 7/8" hole from 1,056' to 1,398.'	Clean 9 7/8" thru Pittsburgh Coal 942'-950'.	7 7/8". Clean 7 7/8"		
Ran coal protection string as follows: 1,129.98' of 4 1/2" by 245.91' of 2" tubing. Total back to surface using 450 sacks of poz mix and 200 sacks of thixotropic cement. Used 1,000 gallons of mud flush. Latch down plug at 1,098.11'. Float valve at 1,129.98'. Swedge at 1,130.98'. Cement did circulate. Displaced cement to 1,098.11' with water; let set and bailed dry.	Total casing ran in hole 1,375.89'. Cement hole	casing followed		
TOTAL DEPTH: 1,398.17'				
Coal Seams			Description of Monument	
(Name) PITTSBURGH	942' TO 950'		5' OF 4 1/2" casing with plaque stating Consolidation Coal Co. Well #4328 Permit # 47-61-1243-P	

and that the work of plugging and filling said well was completed on the 13TH day of AUGUST, 1996

And further deponents saith not.
NOTARY PUBLIC
STATE OF WEST VIRGINIA
Sworn to and subscribed before me this 16th day of October, 1996.
L.H. 1, Box 603
Mt. Clare, WV 26408
My commission expires June 29, 1999

[Signature]
[Signature]
[Signature]
Notary Public
NOV 07 1997