

V 9150


LATITUDE 39° 40' 00"

9,150'

LONGITUDE 80° 17' 30"

1.02
1.73


5400

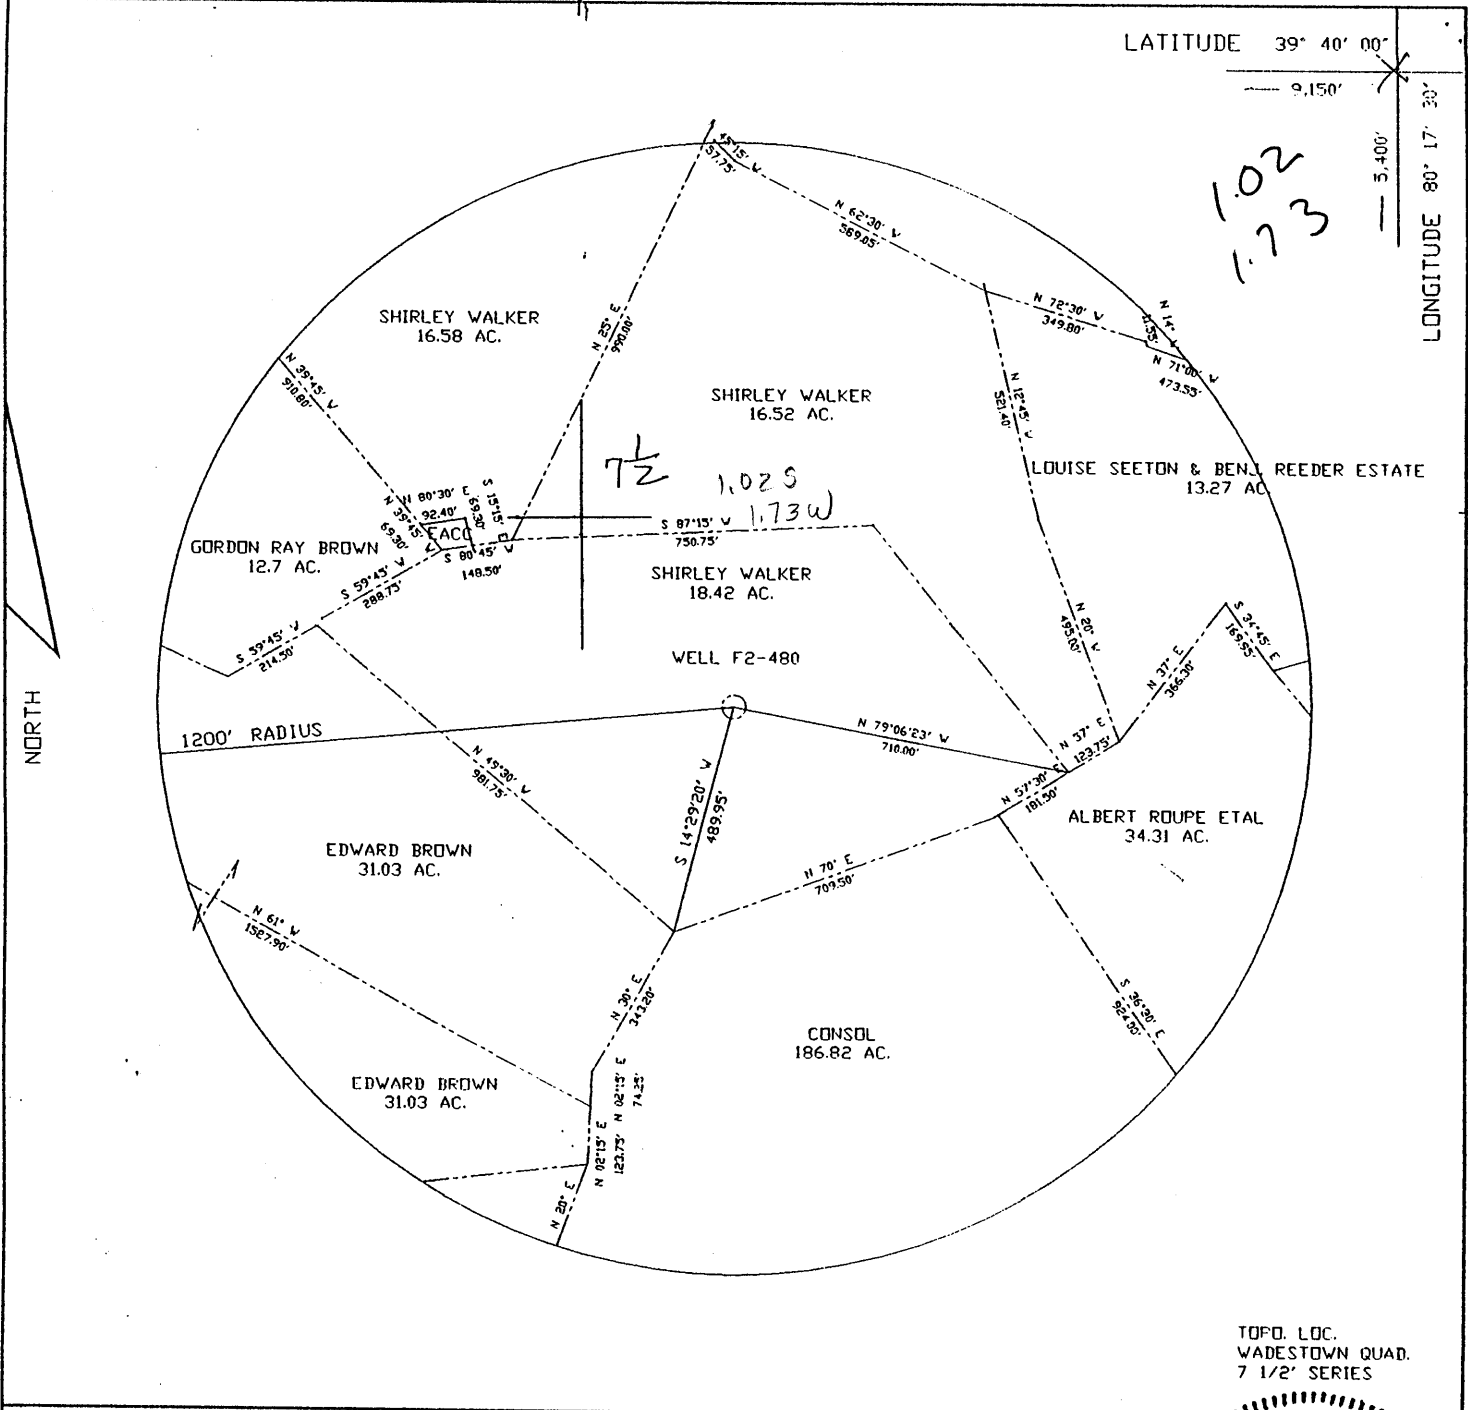

TOPO. LOC. WADESTOWN QUAD. 7 1/2' SERIES

FILE NO. F2-1-244
 DRAWING NO. F2-2-310
 SCALE 1"=400'
 MINIMUM DEGREE OF ACCURACY 1/2500'
 PROVEN SOURCE OF ELEVATION USGS B.M.

I THE UNDERSIGNED, HEREBY CERTIFY THAT THIS PLAT IS CORRECT TO THE BEST OF MY KNOWLEDGE AND BELIEF AND SHOWS ALL THE INFORMATION REQUIRED BY LAW AND THE REGULATIONS ISSUED AND PRESCRIBED BY THE DEPARTMENT OF MINES.
 (SIGNED) John F. Ewell Jr.
 R.P.E. 11133 L.L.S.

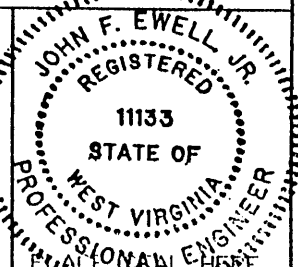

(+) DENOTES LOCATION OF WELL ON UNITED STATES TOPOGRAPHIC MAPS
 FORM IV-6
 (8-78)

STATE OF WEST VIRGINIA
 DEPARTMENT OF MINES
 OIL AND GAS DIVISION

DATE July 27, 2001
 OPERATOR'S WELL NO. F2-480
 APT WELL NO.
 STATE 47 COUNTY 061 PERMIT 1417P
 was: 061 70916

WELL TYPE: OIL X GAS LIQUID INJECTION WASTE DISPOSAL
 (IF "GAS", PRODUCTION STORAGE DEEP SHALLOW X)
 LOCATION: ELEVATION 1357 WATERSHED RIGHT BRANCH MIRACLE RUN
 DISTRICT BATTELLE COUNTY MONONGALIA
 QUADRANGLE WADESTOWN
 SURFACE OWNER SHIRLEY WALKER ACREAGE 34.306
 OIL & GAS ROYALTY OWNER CONSOLIDATED GAS 2E-18972 LEASE ACREAGE
 LEASE NO.
 PROPOSED WORK: DRILL CONVERT DRILL DEEPER REDRILL X FRACTURE OR STIMULATE PLUG OFF OLD FORMATION PERFORATE NEW FORMATION OTHER PHYSICAL CHANGE IN WELL (SPECIFY)
 PLUG AND ABANDON CLEAN OUT AND REPLUG X
 TARGET FORMATION GORDON SAND ESTIMATED DEPTH 3,360
 WELL OPERATOR EASTERN ASSOC. COAL DESIGNATED AGENT EDWARD Y. HOY
 ADDRESS 1044 MIRACLE RUN ROAD ADDRESS 1044 MIRACLE RUN ROAD
FAIRVIEW WV. 26570 FAIRVIEW WV. 26570

SEP 14 2001

MONO 1417 P

STATE OF WEST VIRGINIA
DEPARTMENT OF ENVIRONMENTAL PROTECTION
OFFICE OF OIL AND GAS

AFFIDAVIT OF PLUGGING AND FILLING WELL

AFFIDAVIT SHOULD BE IN TRIPLICATE, one copy mailed to the Department, one copy to be retained by the Well Operator and the third copy (and extra copies if required) should be mailed to each coal operator at their respective addresses.

Farm name: Shirley Walker Operator Well No.: F2-480

LOCATION: Elevation: 1,357 Quadrangle: Wadestown
District: Battelle County: Monongalia
Latitude: 5,400 Feet South of 39 Deg. 40 Min. 00 Sec.
Longitude: 9,150 Feet West of 80 Deg. 17 Min. 30 Sec.

Well Type: OIL X GAS _____

Company: Eastern Associated Coal Corp Coal Operator: Eastern Associated Coal Corp
1044 Miracle Run Road or Owner 1044 Miracle Run Road
Fairview, WV 26570 Fairview, WV 26570


Agent: Mark A. Gouzd

Coal Operator: _____
or Owner _____

Permit Issued Date: September 13, 2001

AFFIDAVIT

STATE OF WEST VIRGINIA,
County of Monongalia ss:

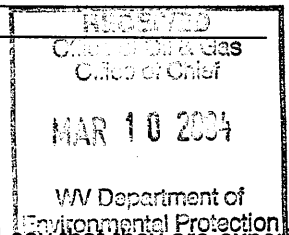

Jeff Hostutler and Jeff Tennant being first duly sworn according to law depose and say that they are experienced in the work of plugging and filling oil and gas wells and were employed by the above named well operator, and participated in the work of plugging and filling the above well, and Randall Mick Oil and Gas Inspector representing the Director, say that said work was commenced on the 24th day of September, 2001, and that the well was plugged and filled in the following manner:

TYPE	FROM	TO	PIPE REMOVED	LEFT
Cleaned out with 8" bit to 1632 feet.				
Logged well bore with Timco Inc.- ran Gamma Ray, Neutron, and CCL.				
Created bottom plug with 100 bags of cement				
Ran 1,254 feet of 4 1/2" pipe and pumped 180 bags of Portland cement and 100 bags of E1K expanding cement.				
Latch down plug @ 1,180 feet. Ran 271 feet of 1 1/2" tubing outside of 4 1/2" pipe and pumped 410 bags of cement to surface.				
Drilled out latch down plug and cement to 1,234 feet				
Bailed hole dry and ran directional survey with Javins.				
Pittsburgh Coal: 1154' - 1161'				

Description of monument: 4 1/2" Pipe with metal plate, API#, Date plugged and that the work of plugging and filling said well was completed on the 15th day of November 2001.


And further deponents saith not.

Jeffery A. Hostutler
Jeffery L. Tennant

Sworn and subscribe before me this 19 day of November 2001
My commission expires September 28th 2004

Mark Allen Gouzd
Notary Public

Oil and Gas Inspector: Randall Mick

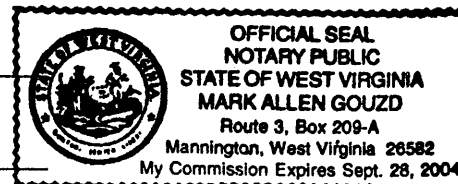

MOND 1417