

4706101439P

WW-7
8-30-06



West Virginia Department of Environmental Protection
Office of Oil and Gas

WELL LOCATION FORM: GPS

API: 47-61-01439 WELL NO.: 4501
FARM NAME: Freda L. Phillips
RESPONSIBLE PARTY NAME: Monument Oil & Gas LLC
COUNTY: Monongalia DISTRICT: Battelle
QUADRANGLE: Wadestown
SURFACE OWNER: John Jones
ROYALTY OWNER: John Jones
UTM GPS NORTHING: 4388589
UTM GPS EASTING: 555864 GPS ELEVATION: 1450

The Responsible Party named above has chosen to submit GPS coordinates in lieu of preparing a new well location plat for a plugging permit or assigned API number on the above well. The Office of Oil and Gas will not accept GPS coordinates that do not meet the following requirements:

1. Datum: NAD 1983, Zone: 17 North, Coordinate Units: meters, Altitude: height above mean sea level (MSL) – meters.
2. Accuracy to Datum – 3.05 meters
3. Data Collection Method:

Survey grade GPS ____ : Post Processed Differential ____
Real-Time Differential ____

Mapping Grade GPS ____ : Post Processed Differential ____
Real-Time Differential ____

RECEIVED
Office of Oil and Gas

APR 18 2022

WV Department of
Environmental Protection


4. Letter size copy of the topography map showing the well location.

I the undersigned, hereby certify this data is correct to the best of my knowledge and belief and shows all the information required by law and the regulations issued and prescribed by the Office of Oil and Gas.

Lyvy D. Jones Land Manager 02/15/2022
Signature Title Date

05/27/2022

CNX 4501

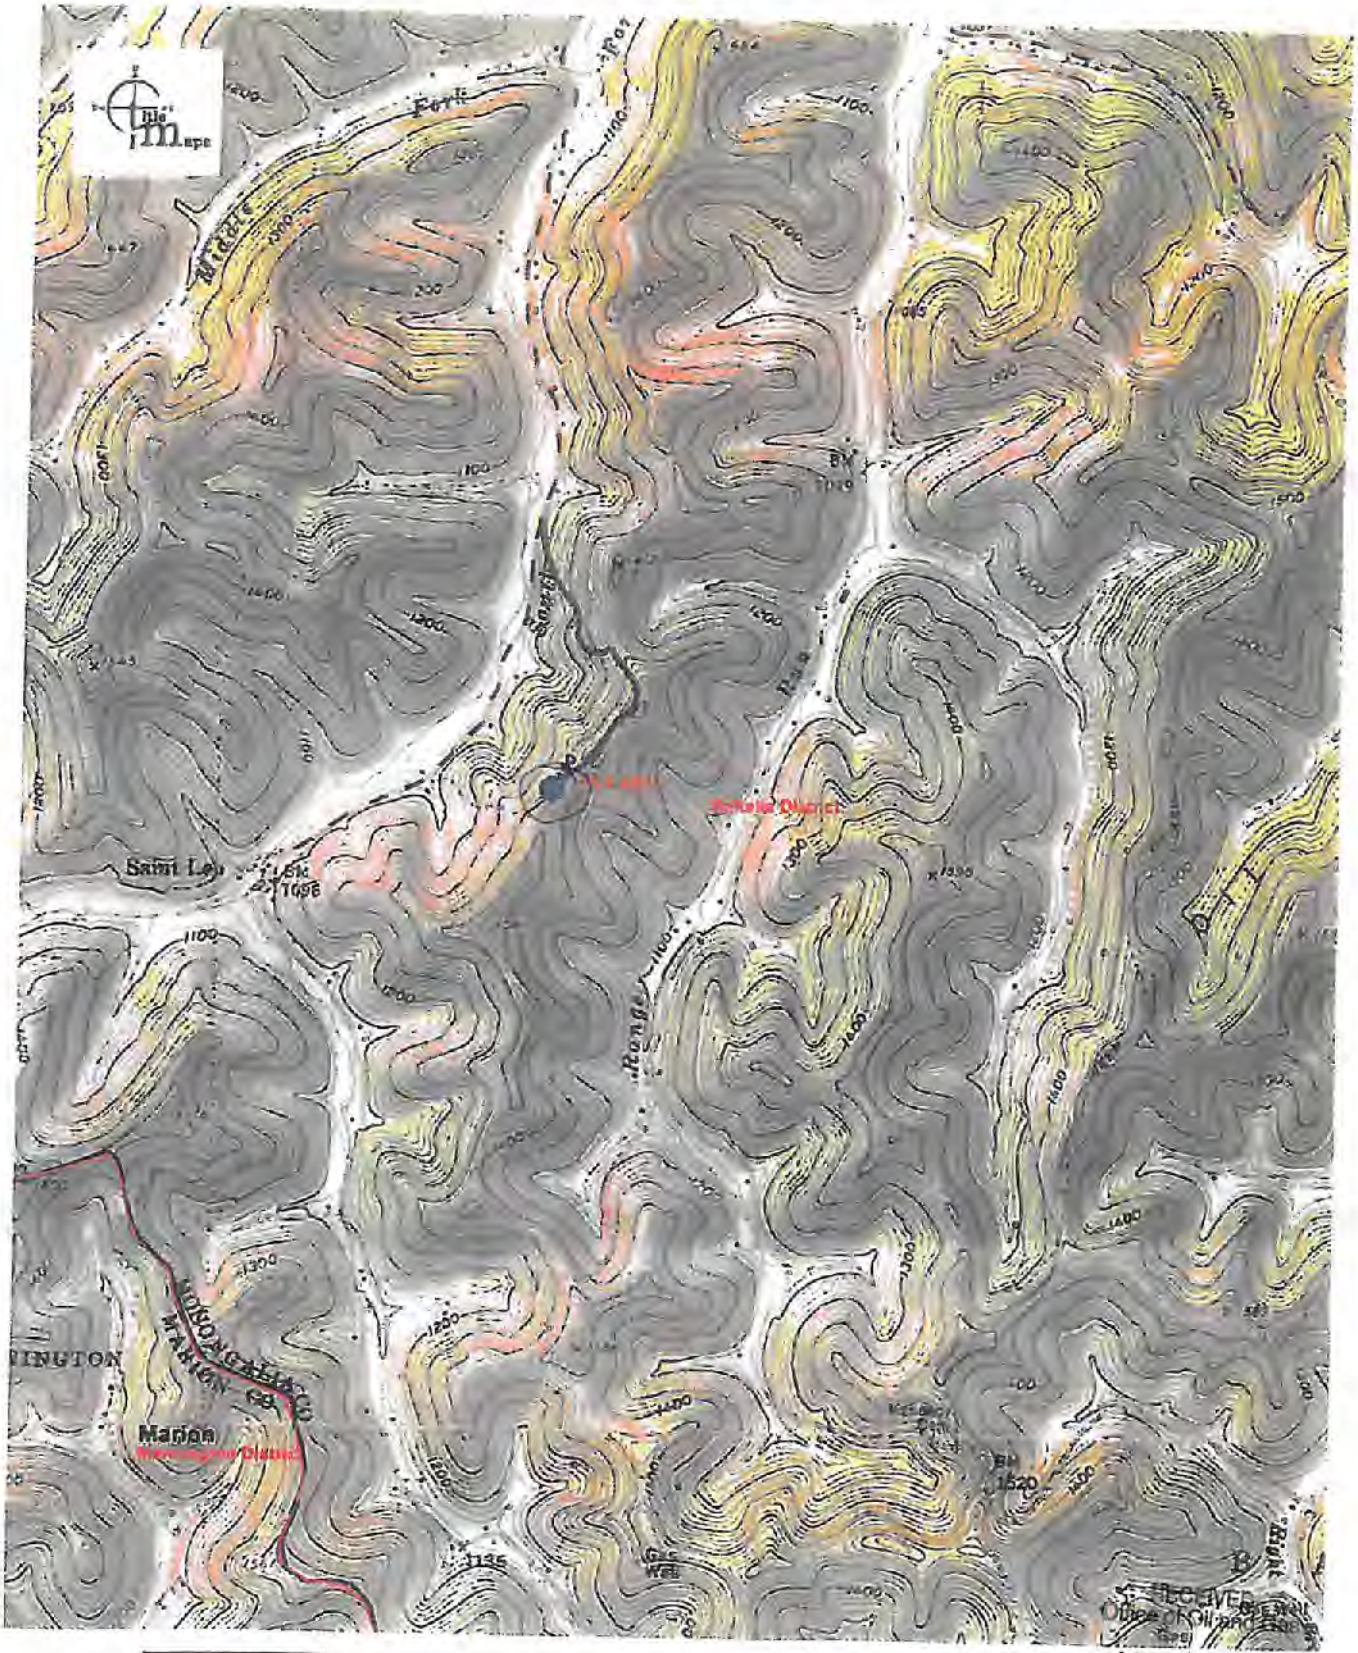

2000ft

APR 18 2022

Approximate Scale 1:24,000

04/13/2022 - 10:30:28 AM

Disclaimer: The map information shown is provided for informational purposes only and is not intended to be used for any legal or regulatory purposes. The map information does not represent a land survey or legal depiction of the property or information shown. Title Maps LLC does not warrant the accuracy or completeness of the map information shown.

05/27/2022