

6101451CP

WW-7
8-30-06



West Virginia Department of Environmental Protection
Office of Oil and Gas
WELL LOCATION FORM: GPS

API: 47-061-01451 WELL NO.: L109

FARM NAME: Phillips

RESPONSIBLE PARTY NAME: Erika Whetstone

COUNTY: Monongalia DISTRICT: Battelle

QUADRANGLE: Wadestown

SURFACE OWNER: REBECCA GAIL FOLEY

ROYALTY OWNER: _____

UTM GPS NORTHING: 4,388,193.119 METERS

UTM GPS EASTING: 555,688.787 METERS GPS ELEVATION: 459.447 METERS (1507')

The Responsible Party named above has chosen to submit GPS coordinates in lieu of preparing a new well location plat for a plugging permit or assigned API number on the above well. The Office of Oil and Gas will not accept GPS coordinates that do not meet the following requirements:

1. Datum: NAD 1983, Zone: 17 North, Coordinate Units: meters, Altitude: height above mean sea level (MSL) – meters.
2. Accuracy to Datum – 3.05 meters
3. Data Collection Method:

Survey grade GPS : Post Processed Differential

Real-Time Differential

Mapping Grade GPS : Post Processed Differential

Real-Time Differential

4. **Letter size copy of the topography map showing the well location.**

I the undersigned, hereby certify this data is correct to the best of my knowledge and belief and shows all the information required by law and the regulations issued and prescribed by the Office of Oil and Gas.


Erika J. Whetstone
Signature

Permitting Supervisor
Title

6/9/17
Date

RECEIVED
Office of Oil and Gas
JUL 13 2017
WV Department of
Environmental Protection

08/11/2017

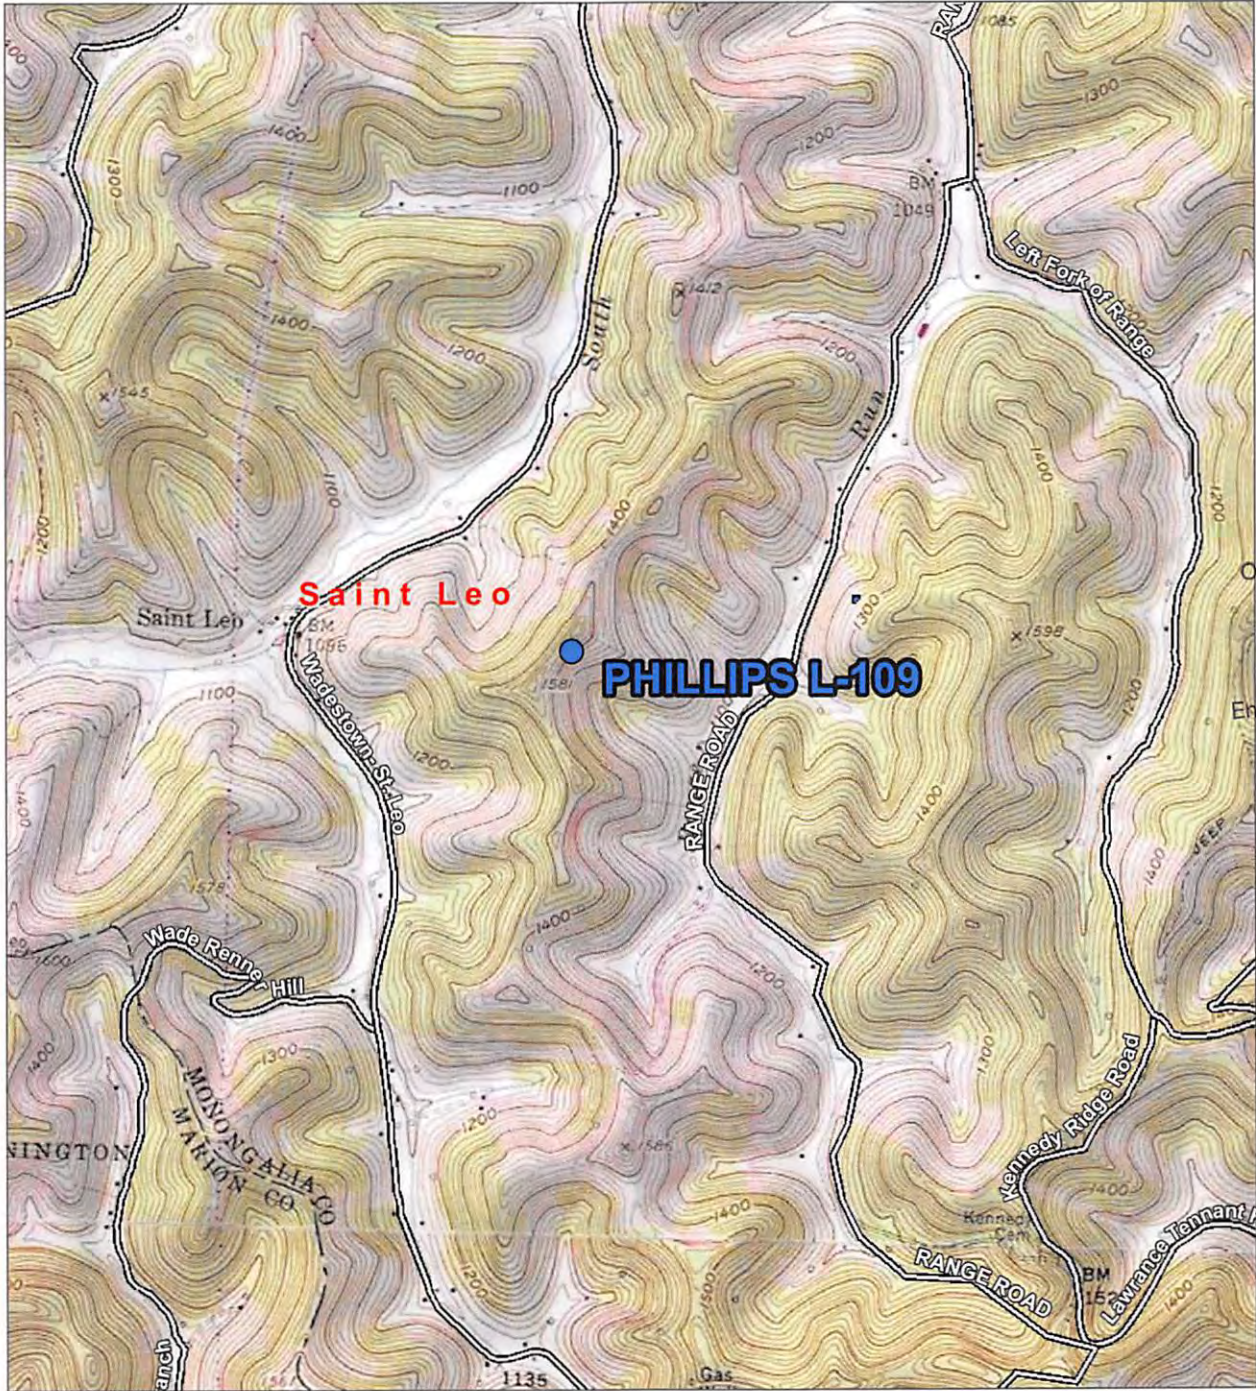

RECEIVED
Office of Oil and Gas
JUL 13 2017
WV Department of
Environmental Protection

LOCATION MAP
WADESTOWN, WV 7.5M USGS QUADRANGLE
SCALE: 1"=2000'



Blue Mountain Inc.
Engineers and Land Surveyors
Woman Owned Small Business
11023 Mason Dixon Hwy.
Burton, WV 26562-9656
(304) 662-6486

LOCATION MAP
GAS WELL PLUGGING
PHILLIPS-L-109 GAS WELL
BATTELLE DISTRICT
MONONGALIA COUNTY, WV
CNX GAS COMPANY, LLC.
200 HALLAM ROAD
WASHINGTON, PA 15301

DRAWN BY: LLF
CHECKED BY: WPF
DATE: 05/23/2017
SCALE: 1"=2000'
WATERSHED: WEST VIRGINIA FORK
PAGE 4 OF 4

08/11/2017