

963.5'

LATITUDE 39 40' 00"

(+) DENOTES LOCATION OF WELL ON U.S.G.S. TOPOGRAPHIC MAP

TIE LINES

- A - S 19 22 48 E 522.18'
- B - N 34 45 29 W 1045.91'
- C - N 17 06 42 E 1051.62'
- D - N 12 18 29 W 293.95'
- E - N 50 07 50 E 143.34'
- F - N 81 04 50 W 1149.70'
- G - S 62 48 57 W 947.73'
- H - N 25 35 32 W 677.72'
- J - N 82 24 40 W 891.89'
- K - S 49 40 14 W 956.97'

N

LONGITUDE 80 20' 00"

9724.4'

JAMES HARTLEY
82.72 AC.
--
18-31

3/4" IR(S)
(CO CALLED)

WV. CO. RT. 8
(RANGE ROAD)

4179
47-61-1224-P

4L-CCR

4180
FREDA L. PHILLIPS
128.75 AC.
1126/135
23-1.1

4181
E. NOLAN
101.6 AC.
--
23-5

JOHN JONES
36.65 AC.
--
23-22

TWIN 20"
ELM-TREES (F)

FREDA L. PHILLIPS
128.75 AC.
1126/135
23-1.1

L-111

RONNIE PRICE
40 AC.
--
23-2

TWIN 18" ASH TREES
(WO CALLED)


NOTE :

- 1) CONSOLIDATION COAL COMPANY OWNS THE MINERAL ON THIS TRACT.
- 2) THIS WELL IS AN EXISTING VENTILATION BORE-HOLE BEING CONVERTED TO A CBM GOB WELL.

FILE NO. 02-HH-04
DRAWN BY : R.A. KITZMILLER
SCALE : 1 : 500'
MIN. DEGREE OF ACCURACY 1 / 200'
PROVEN SOURCE OF ELEVATION : _____
SPOT ELEVATION

I THE UNDERSIGNED, HEREBY CERTIFY THAT THIS PLAT IS CORRECT TO THE BEST OF MY KNOWLEDGE AND BELIEF AND SHOWS ALL THE INFORMATION REQUIRED BY LAW AND THE REGULATIONS ISSUED AND PRESCRIBED BY THE DIVISION OF ENVIRONMENTAL PROTECTION.

(SIGNED) Robert A. Kitzmiller
Professional Surveyor No. 635

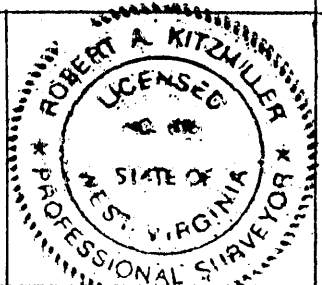

WV. DEPT. OF ENVIRONMENTAL PROTECTION
OFFICE OF OIL AND GAS DIVISION
1356 HANSFORD STREET
CHARLESTON, WV. 25301



DATE FEBRUARY 11, 20 02
OPERATOR'S WELL NO. L-111
API WELL NO. 47-061-01452C
STATE COUNTY PERMIT NO.

WELL TYPE: OIL GAS CBM LIQUID INJECTION WASTE DISPOSAL
IF "GAS", PRODUCTION STORAGE DEEP SHALLOW
LOCATION: ELEVATION 1452' WATERSHED RANGE RUN OF WEST VIRGINIA FORK OF DUNKARD CREEK
DISTRICT BATTELLE COUNTY MONONGALIA
QUADRANGLE WADESTOWN NEAREST TOWN WADESTOWN
SURFACE OWNER FREDA L. PHILLIPS ACREAGE 128.75 AC.
OIL & GAS ROYALTY OWNER * See Note LEASE ACREAGE ---
LEASE NO. ---

PROPOSED WORK: DRILL CONVERT DRILL DEEPER REDRILL FRACTURE OR STIMULATE
PLUG OFF OLD FORMATION PERFORATE NEW FORMATION
OTHER PHYSICAL CHANGE IN WELL (SPECIFY) EXISTING VENTILATION BOREHOLE BEING CONVERTED
PLUG AND ABANDON CLEAN OUT AND REPLUG TO GOB WELL.
TARGET FORMATION PITTSBURGH ESTIMATED DEPTH 1190'
WELL OPERATOR CNX GAS COMPANY LLC. (NORTH) DESIGNATED AGENT EDWIN L. MERRIFIELD
ADDRESS 1800 WASHINGTON ROAD ADDRESS 116 1/2 HUNSAKER STREET
PITTSBURGH, PA. 15421-1421 FAIRMONT, WV. 26554

PRECISION SURVEYS FORM IV-6

MONO COUNTY PERMIT NO. 1452 C

(Lowercase Mine CBM 300) 6/2

State of West Virginia
 Department of Environmental Protection
 Office of Oil and Gas

Well Operator's Report of Well Work

Farm Name: Phillips, Freda L. Operator Well No.: L-111

LOCATION: Elevation: 1452 Quadrangle: Wadestown

District: Battelle County: Monongalia
 Latitude: 9724.4 Feet South of 39 Deg. 40 Min. 00 Sec.
 Longitude: 963.5 Feet West of 80 Deg. 20 Min. 00 Sec.

Company: CNX Gas Company LLC (North)


	Casing & Tubing	Used In Drilling	Left In Well	Cement Fill Up Cu. Ft.
Address: 1800 Washington Road Pittsburgh, PA 15241				
Agent: Edwin Merrifield				
Inspector: Steve Mossor				
Date Permit Issued: 9/17/2002				
Date Well Work Commenced: Existing Borehole				
Date Well Work Completed: Converted to well				
Verbal Plugging:				
Date Permission granted on:				
Rotary Cable Rig				
Total Depth (feet): 1190				
Fresh Water Depth (ft.):				
Salt Water Depth (ft.):				
Is coal being mined in area (N/Y)? No				
Coal Depths (ft.): 1180				

OPEN FLOW DATA

Producing formation	<u>Pittsburgh Coal Seam</u>	Pay zone depth (ft)	<u>1180</u>
Gas: Initial open flow	<u>180</u> MCF/d	Oil: Initial open flow	<u>0</u> Bbl/d
Final open flow	<u>180</u> MCF/d	Final open flow	<u>0</u> Bbl/d
Time of open flow between initial and final tests	<u>0</u> Hours		
Static rock pressure	<u>1</u> psig (surface pressure) after	<u>-</u> Hours	
Second producing formation	<u>None</u>	Pay zone depth (ft)	
Gas: Initial open flow		Oil: Initial open flow	
Final open flow		Final open flow	
Time of open flow between initial and final tests			
Static rock pressure			

NOTE: ON BACK OF THIS FORM PUT THE FOLLOWING: 1). DETAILS OF PERFORATION INTERVALS, FRACTURING OR STIMULATING, PHYSICAL CHANGE, ETC. 2). THE LOG WHICH IS A SYSTEMATIC DETAILED GEOLOGICAL RECORD OF ALL FORMATIONS, INCLUDING COAL ENCOUNTERED BY THE WELLBORE.

Signed: Joseph P. Aman
 By: Joseph P. Aman
 Date: September 2, 2004

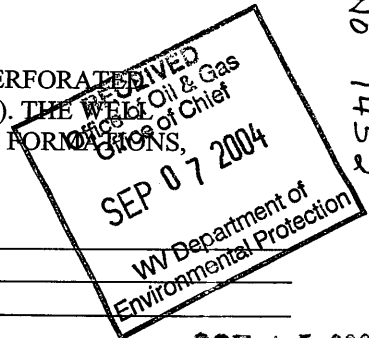

OCT 15 2004

MANO 1452