

(+) DENOTES LOCATION OF WELL ON U.S.G.S. TOPOGRAPHIC MAP

N

CONSOLIDATION COAL CO.

GARY EDDY

(S 46 30 W 727.85')

NE GATEPOST
4" IRON PIPE

4501

L-113

18° 18' 7"
SET STONE (F)

PLUGGED WELL
4247

ROBERT ESTEL

FREDA L. PHILLIPS

88.511 AC.

1126/138

23-1

CHARLES PHILLIPS

WV. CO. RT. 8

LONGITUDE 80 20' 00"

7815.8'

NOTE :

- 1) CONSOLIDATION COAL COMPANY ET.AL. OWNS THE MINERAL ON THIS TRACT.
- 2) THIS WELL IS AN EXISTING VENTILATION BORE-HOLE BEING CONVERTED TO A CBM GOB WELL.

TIE LINES

1 - 80 56 52 251.21'
 2 - 92 02 35 241.03'
 3 - 185 12 50 209.85'


TIE LINES

A - 7 56 35 48.65'
 B - 94 09 44 283.14'
 C - 231 48 05 328.22'

FILE NO. 02-HH-10
 DRAWN BY : R.A. KITZMILLER
 SCALE : 1 : 500'
 MIN. DEGREE OF ACCURACY 1 / 200'
 PROVEN SOURCE OF ELEVATION :
SPOT ELEVATION

I THE UNDERSIGNED, HEREBY CERTIFY THAT THIS PLAT IS CORRECT TO THE BEST OF MY KNOWLEDGE AND BELIEF AND SHOWS ALL THE INFORMATION REQUIRED BY LAW AND THE REGULATIONS ISSUED AND PRESCRIBED BY THE DIVISION OF ENVIRONMENTAL PROTECTION.

(SIGNED) Robert A. Kitzmiller
 Professional Surveyor No. 635

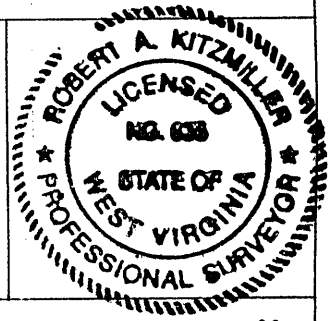

WV. DEPT. OF ENVIRONMENTAL PROTECTION
 OFFICE OF OIL AND GAS DIVISION
 1356 HANSFORD STREET
 CHARLESTON, WV. 25301



DATE JULY 10, 20 02
 OPERATOR'S WELL NO. L-113
 API WELL NO. _____
47 - 061 - 014530C
 STATE COUNTY PERMIT NO.

WELL TYPE: OIL GAS CBM LIQUID INJECTION WASTE DISPOSAL
 IF "GAS", PRODUCTION STORAGE DEEP SHALLOW
 LOCATION: ELEVATION 1181' WATERSHED RANGE RUN OF WEST VIRGINIA FORK OF DUNKARD CREEK
 DISTRICT BATTELLE COUNTY MONONGALIA
 QUADRANGLE WADESTOWN NEAREST TOWN ST. LEO
 SURFACE OWNER FREDA L. PHILLIPS ACREAGE 88.511 AC.
 OIL & GAS ROYALTY OWNER * See Note LEASE ACREAGE _____
 LEASE NO. _____

PROPOSED WORK: DRILL CONVERT DRILL DEEPER REDRILL FRACTURE OR STIMULATE
 PLUG OFF OLD FORMATION PERFORATE NEW FORMATION
 OTHER PHYSICAL CHANGE IN WELL (SPECIFY) EXISTING VENTILATION BOREHOLE BEING CONVERTED
 PLUG AND ABANDON CLEAN OUT AND REPLUG TO GOB WELL.
 TARGET FORMATION PITTSBURGH ESTIMATED DEPTH 913'
 WELL OPERATOR CNX GAS COMPANY LLC. (NORTH) DESIGNATED AGENT EDWIN L. MERRIFIELD
 ADDRESS 1800 WASHINGTON ROAD ADDRESS 116 1/2 HUNSAKER STREET
PITTSBURGH, PA. 15421-1421 FAIRMONT, WV. 26554

PRECISION SURVEYS FORM IV-6

MONO COUNTY PERMIT NO. 1453 C

(Lowercase Mineral 389) 6-6

SEP 29 2002

Latitude

7815.83

4432.1 W

Longitude

Temp Plat

Topo Location

7.5' Loc. _____ 15' Loc. _____
(calc.) _____

Company CNX Gas

Farm Freda Phillips

15' Quad _____
(sec.)

7.5' Quad _____

District _____

WELL LOCATION PLAT

County 61 Permit 1453

State of West Virginia
 Department of Environmental Protection
 Office of Oil and Gas

Well Operator's Report of Well Work

Farm Name: Phillips, Freda L. Operator Well No.: L-113

LOCATION: Elevation: 1181 Quadrangle: Wadestown

District: Battelle County: Monongalia
 Latitude: 7815.8 Feet South of 39 Deg. 40 Min. 00 Sec.
 Longitude: 4432.1 Feet West of 80 Deg. 20 Min. 00 Sec.

Company: CNX Gas Company LLC (North)

	Casing & Tubing	Used In Drilling	Left In Well	Cement Fill Up Cu. Ft.
Address: 1800 Washington Road Pittsburgh, PA 15241				
Agent: Edwin Merrifield				
Inspector: Randal Mick				
Date Permit Issued: 9/17/2002				
Date Well Work Commenced: Existing Borehole				
Date Well Work Completed: Converted to well				
Verbal Plugging:				
Date Permission granted on:				
Rotary Cable Rig				
Total Depth (feet): 1210				
Fresh Water Depth (ft.):				
Salt Water Depth (ft.):				
Is coal being mined in area (N/Y)? No				
Coal Depths (ft.): 913				

OPEN FLOW DATA


Producing formation Pittsburgh Coal Seam Pay zone depth (ft) 913
 Gas: Initial open flow 150 MCF/d Oil: Initial open flow 0 Bbl/d
 Final open flow 150 MCF/d Final open flow 0 Bbl/d
 Time of open flow between initial and final tests 0 Hours
 Static rock pressure 1 psig (surface pressure) after - Hours

SEP 17 2004

Second producing formation None Pay zone depth (ft) _____
 Gas: Initial open flow _____ MCF/d Oil: Initial open flow _____ Bbl/d
 Final open flow _____ MCF/d Final open flow _____ Bbl/d
 Time of open flow between initial and final tests _____ Hours
 Static rock pressure _____ psig (surface pressure) after _____ Hours

NOTE: ON BACK OF THIS FORM PUT THE FOLLOWING: 1). DETAILS OF PERFORATED INTERVALS, FRACTURING OR STIMULATING, PHYSICAL CHANGE, ETC. 2). THE WELL LOG WHICH IS A SYSTEMATIC DETAILED GEOLOGICAL RECORD OF ALL FORMATION INCLUDING COAL ENCOUNTERED BY THE WELLBORE.

Signed: Joseph P. Aman
 By: Joseph P. Aman
 Date: August 4, 2004

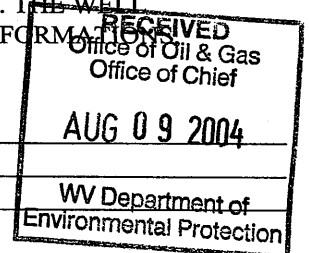

MONO 1453

State of West Virginia
Department of Environmental Protection
Office of Oil and Gas

Well Operator's Report of Well Work

Farm Name: Phillips, Freda L. Operator Well No.: L-113

LOCATION: Elevation: 1181 Quadrangle: Wadestown

District: Battelle County: Monongalia
Latitude: 7815.8 Feet South of 39 Deg. 40 Min. 00 Sec.
Longitude: 4432.1 Feet West of 80 Deg. 20 Min. 00 Sec.

Company: CNX Gas Company LLC (North)


	Casing & Tubing	Used In Drilling	Left In Well	Cement Fill Up Cu. Ft.
Address: 1800 Washington Road Pittsburgh, PA 15241				
Agent: Edwin Merrifield				
Inspector: Randal Mick				
Date Permit Issued: 9/17/2002				
Date Well Work Commenced: Existing Borehole				
Date Well Work Completed: Converted to well				
Verbal Plugging:				
Date Permission granted on:				
Rotary Cable Rig				
Total Depth (feet): 1210				
Fresh Water Depth (ft.):				
Salt Water Depth (ft.):				
Is coal being mined in area (N/Y)? No				
Coal Depths (ft.): 913				

OPEN FLOW DATA

Producing formation	<u>Pittsburgh Coal Seam</u>	Pay zone depth (ft)	<u>913</u>
Gas: Initial open flow	<u>150</u> MCF/d	Oil: Initial open flow	<u>0</u> Bbl/d
Final open flow	<u>150</u> MCF/d	Final open flow	<u>0</u> Bbl/d
Time of open flow between initial and final tests	<u>0</u> Hours		
Static rock pressure	<u>1</u> psig (surface pressure) after	<u>-</u> Hours	
Second producing formation	<u>None</u>	Pay zone depth (ft)	
Gas: Initial open flow	<u></u> MCF/d	Oil: Initial open flow	<u></u> Bbl/d
Final open flow	<u></u> MCF/d	Final open flow	<u></u> Bbl/d
Time of open flow between initial and final tests	<u></u> Hours		
Static rock pressure	<u></u> psig (surface pressure) after	<u></u> Hours	

NOTE: ON BACK OF THIS FORM PUT THE FOLLOWING: 1). DETAILS OF PERFORATED INTERVALS, FRACTURING OR STIMULATING, PHYSICAL CHANGE, ETC. 2). THE WELL LOG WHICH IS A SYSTEMATIC DETAILED GEOLOGICAL RECORD OF ALL FORMATIONS INCLUDING COAL ENCOUNTERED BY THE WELLBORE.

Signed: Joseph P. Aman
By: Joseph P. Aman
Date: September 2, 2004

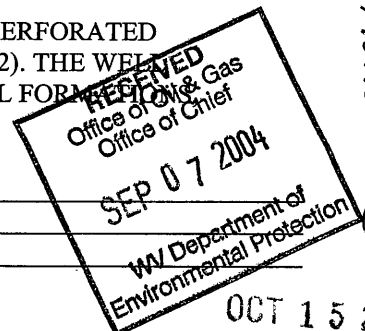

OCT 15 2004