

1616.80'

LATITUDE 39 40' 00"

(+) DENOTES LOCATION OF WELL ON U.S.G.S. TOPOGRAPHIC MAP

TIE LINES

- A - S 19 22 48 E 522.18'
- B - N 34 45 29 W 1045.91'
- C - N 17 06 42 E 1051.62'
- D - N 12 18 29 W 293.95'
- E - N 50 07 50 E 143.34'
- F - N 81 04 50 W 1149.70'
- G - S 62 48 57 W 947.73'
- H - N 25 35 32 W 677.72'
- J - N 82 24 40 W 891.89'
- K - S 49 40 14 W 956.97'

N

LONGITUDE 80 20' 00"

0.0000

WV. CO. RT. 8 (RANGE ROAD)

JOHN JONES 36.65 AC. 23-22

TWIN 20" ELM TREES (F)

FREDA L. PHILLIPS 128.75 AC. 1126/135 23-1.1

JAMES HARTLEY 82.72 AC. 18-31

3/4" IR(S) (CO CALLED)

E. NOLAN 101.6 AC. 23-5

RONNIE PRICE 40 AC. 23-2

TWIN 18" ASH TREES (WO CALLED)


NOTE :

- 1) CONSOLIDATION COAL COMPANY OWNS THE MINERAL ON THIS TRACT.
- 2) THIS WELL IS AN EXISTING VENTILATION BORE-HOLE BEING CONVERTED TO A CBM GOB WELL.

FILE NO. 02-HH-06
 DRAWN BY : R.A. KITZMILLER
 SCALE : 1 : 500'
 MIN. DEGREE OF ACCURACY 1 / 200'
 PROVEN SOURCE OF ELEVATION : _____
SPOT ELEVATION

I THE UNDERSIGNED, HEREBY CERTIFY THAT THIS PLAT IS CORRECT TO THE BEST OF MY KNOWLEDGE AND BELIEF AND SHOWS ALL THE INFORMATION REQUIRED BY LAW AND THE REGULATIONS ISSUED AND PRESCRIBED BY THE DIVISION OF ENVIRONMENTAL PROTECTION.

(SIGNED) Robert A. Kitzmiller
 Professional Surveyor No. 635

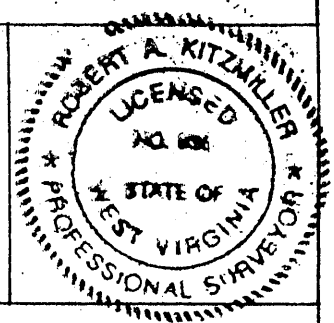

WV. DEPT. OF ENVIRONMENTAL PROTECTION
 OFFICE OF OIL AND GAS DIVISION
 1356 HANSFORD STREET
 CHARLESTON, WV. 25301



DATE FEBRUARY 11, 20 02
 OPERATOR'S WELL NO. 4180
 API WELL NO. _____
47-061-01457C
 STATE COUNTY PERMIT NO.

WELL TYPE: OIL GAS CBM LIQUID INJECTION WASTE DISPOSAL
 IF "GAS", PRODUCTION STORAGE DEEP SHALLOW
 LOCATION: ELEVATION 1225' WATERSHED RANGE RUN OF WEST VIRGINIA FORK OF DUNKARD CREEK
 DISTRICT BATTELLE COUNTY MONONGALIA
 QUADRANGLE WADESTOWN NEAREST TOWN WADESTOWN
 SURFACE OWNER FREDA L. PHILLIPS ACREAGE 128.75 AC.
 OIL & GAS ROYALTY OWNER * See Note LEASE ACREAGE _____
 LEASE NO. _____

PROPOSED WORK: DRILL CONVERT DRILL DEEPER REDRILL FRACTURE OR STIMULATE
 PLUG OFF OLD FORMATION PERFORATE NEW FORMATION
 OTHER PHYSICAL CHANGE IN WELL (SPECIFY) EXISTING VENTILATION BOREHOLE BEING CONVERTED
 PLUG AND ABANDON CLEAN OUT AND REPLUG TO GOB WELL.
 TARGET FORMATION PITTSBURGH ESTIMATED DEPTH 963'
 WELL OPERATOR CNX GAS COMPANY LLC. (NORTH) DESIGNATED AGENT EDWIN L. MERRIFIELD
 ADDRESS 1800 WASHINGTON ROAD ADDRESS 116 1/2 HUNSAKER STREET
PITTSBURGH, PA. 15421-1421 FAIRMONT, WV. 26554

PRECISION SURVEYS FORM IV-6

MONO COUNTY PERMIT NO. 1457C

(LOVERIDGE MINE CSM 389) 6-6

State of West Virginia
 Department of Environmental Protection
 Office of Oil and Gas

Well Operator's Report of Well Work

Farm Name: Phillips, Freda L. Operator Well No.: 4180

LOCATION: Elevation: 1225 Quadrangle: Wadestown

District: Battelle County: Monongalia
 Latitude: 9060.0 Feet South of 39 Deg. 40 Min. 00 Sec.
 Longitude: 1616.8 Feet West of 80 Deg. 20 Min. 00 Sec.

Company: CNX Gas Company LLC (North)

	Casing & Tubing	Used In Drilling	Left In Well	Cement Fill Up Cu. Ft.
Address: 1800 Washington Road Pittsburgh, PA 15241				
Agent: Edwin Merrifield				
Inspector: Steve Mossor				
Date Permit Issued: 9/17/2002				
Date Well Work Commenced: Existing Borehole				
Date Well Work Completed: Converted to well				
Verbal Plugging:				
Date Permission granted on:				
Rotary Cable Rig				
Total Depth (feet): 963				
Fresh Water Depth (ft.):				
Salt Water Depth (ft.):				
Is coal being mined in area (N/Y)? No				
Coal Depths (ft.): 963				

OPEN FLOW DATA

Producing formation Pittsburgh Coal Seam Pay zone depth (ft) 963
 Gas: Initial open flow 19 MCF/d Oil: Initial open flow 0 Bbl/d
 Final open flow 19 MCF/d Final open flow 0 Bbl/d
 Time of open flow between initial and final tests 0 Hours
 Static rock pressure 1 psig (surface pressure) after - Hours

Second producing formation None Pay zone depth (ft) _____
 Gas: Initial open flow _____ MCF/d Oil: Initial open flow _____ Bbl/d
 Final open flow _____ MCF/d Final open flow _____ Bbl/d
 Time of open flow between initial and final tests _____ Hours
 Static rock pressure _____ psig (surface pressure) after _____ Hours

NOTE: ON BACK OF THIS FORM PUT THE FOLLOWING: 1). DETAILS OF PERFORATED INTERVALS, FRACTURING OR STIMULATING, PHYSICAL CHANGE, ETC. 2). THE WELL LOG WHICH IS A SYSTEMATIC DETAILED GEOLOGICAL RECORD OF ALL FORMATION INCLUDING COAL ENCOUNTERED BY THE WELLBORE.

Signed: Joseph P. Aman
 By: Joseph P. Aman
 Date: September 3, 2004

RECEIVED
 Office of Oil & Gas
 Office of Chief
 SEP 07 2004
 WV Department of
 Environmental Protection
 OCT 15 2004

MOND 1457