


FILE NUMBER: M 13 P 36
 DRAWING NUMBER: depi6359
 SCALE: 1" = 660'
 MINIMUM DEGREE OF ACCURACY: 1 in 2500
 PROVEN SOURCE OF ELEVATION: GPS Survey (sub-meter)

I THE UNDERSIGNED, HEREBY CERTIFY THAT THIS PLAT IS CORRECT TO THE BEST OF MY KNOWLEDGE AND BELIEF AND SHOWS ALL THE INFORMATION REQUIRED BY LAW AND THE REGULATIONS ISSUED AND PRESCRIBED BY THE DEPARTMENT OF ENERGY.

(SIGNED) *J. Michael Evans*
 J. Michael Evans, PS 900

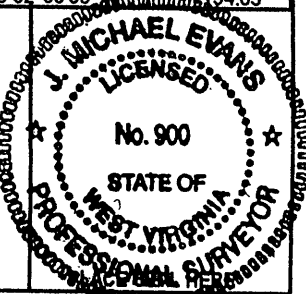

STATE OF WEST VIRGINIA
 DIVISION OF ENVIRONMENTAL PROTECTION
 OFFICE OF OIL AND GAS
 #10 McJUNKIN ROAD
 NITRO, WV 25143-2506
 FORM WW-6

LAND SURVEYING SERVICES
 21 CEDAR LANE, BRIDGEPORT, WV 26330
 PHONE: 304-842-2018 OR 842-6762

DATE: August 2, 2003
 OPERATORS WELL NO.: 6359
 API WELL NO. 47-061-01485

WELL TYPE: OIL GAS LIQUID INJECTION WASTE DISPOSAL
 (IF "GAS") PRODUCTION STORAGE DEEP SHALLOW

LOCATION: ELEVATION 1,322' WATERSHED Honey Run
 DISTRICT Battelle COUNTY Monongalia
 QUADRANGLE Wadestown 7.5' LEASE NUMBER _____

SURFACE OWNER Brent W. Leegan ACREAGE 179.54
 OIL & GAS ROYALTY OWNER Brent W. Leegan LEASE ACREAGE 179.54

PROPOSED WORK: DRILL CONVERT DRILL DEEPER REDRILL FRACTURE OR STIMULATE PLUG OFF OLD FORMATION
 PERFORATE NEW FORMATION OTHER PHYSICAL CHANGE (SPECIFY) _____

TARGET FORMATION Bayard PLUG & ABANDON CLEAN OUT & REPLUG
 ESTIMATED DEPTH 3600'

WELL OPERATOR Dominion Exploration & Production, Inc. DESIGNATED AGENT Rodney J. Biggs
 ADDRESS P. o. Box 1248, Jane Lew, WV 26378 ADDRESS P. o. Box 1248, Jane Lew, WV 26378

COUNTY NAME PERMIT

66 (SD)

OCT 10 2003

State of West Virginia
Department of Environmental Protection
Office of Oil and Gas

13

Well Operator's Report of Well Work

Farm name: Legan, Brent W. Operator Well No.: 6359

LOCATION: Elevation: 1,322' Quadrangle: Wadestown 7.5'

District: Battelle County: Monongalia
Latitude: 9,450 Feet South of 39 Deg. 42 Min. 30 Sec.
Longitude 4,425 Feet West of 80 Deg. 17 Min. 30 Sec.

Company: Dominion Exploration & Production, Inc

	Casing & Tubing	Used in drilling	Left in well	Cement fill up Cu. Ft.
Address: P O Box 1248 Jane Lew, WV 26378				
Agent: Rodney J. Biggs				
Inspector: Terry Urban				
Date Permit Issued: 10/08/2003				
Date Well Work Commenced: 12/30/2004	13 3/8"	80'	80'	14 sks
Date Well Work Completed: 01/19/2005				
Verbal Plugging N/A	9 5/8"	1126'	1126'	510 sks
Date Permission granted on: N/A				
Rotary X Cable Rig	7"	2168'	2168'	300 sks
Total Depth (feet): 3613'				
Fresh Water Depth (ft.): 50',125',645'	4 1/2"	3515'	3515'	210 sks
Salt Water Depth (ft.): N/A				
Is coal being mined in area (N/Y)? Y				
Coal Depths (ft.): 43.46',1072-1080'				

OPEN FLOW DATA


Producing formation Bayard Pay zone depth (ft) 3406-3411'
5th Sand 3343-3353'
Gas: Initial open flow 238 MCF/d Oil: Initial open flow 0 Bbl/d
Final open flow 158 MCF/d Final open flow 0 Bbl/d
Time of open flow between initial and final tests 12 Hours
Static rock Pressure 550 psig (surface pressure) after 12 Hours

Second producing formation 30 Foot Pay zone depth (ft) 2980-3008'
Gas: Initial open flow * MCF/d Oil: Initial open flow * Bbl/d
Final open flow * MCF/d Final open flow * Bbl/d
Time of open flow between initial and final tests * Hours
Static rock Pressure * psig (surface pressure) after * Hours

*Commingled with previous formations

NOTE: ON BACK OF THIS FORM PUT THE FOLLOWING: 1). DETAILS OF PERFORATED INTERVALS, FRACTURING OR STIMULATING, PHYSICAL CHANGE, ETC. 2). THE LOG WHICH IS A SYSTEMATIC DETAILED GEOLOGICAL RECORD OF ALL FORMATIONS INCLUDING COAL ENCOUNTERED BY THE WELLBORE.

Signed: RJ Biggs
By: Rodney J. Biggs
Date: 2/9/05

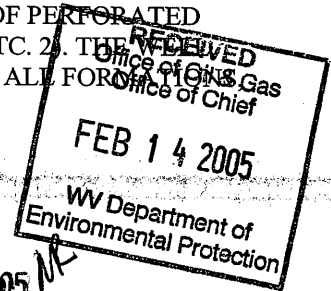

MOND 1485

PERFED AND FRACED AS FOLLOWS:

BAYARD, 3406 - 3411', 15 HOLES, BD 3300#, AVG RATE 13 BPM,
AVG PRESS 2985#, 269 BBLs,

TOT SAND 15,000#, 28 MSCFN2, ISIP 2520#

5TH SAND, 3343 - 3353', 20 HOLES, BD 3500#, AVG RATE 13 BPM, AVG PRESS 3190#, 257 BBLs,

TOT SAND 4000#, ISIP 2450#

30 FT., 2980 - 3008', 18 HOLES, BD 3800#, AVG RATE 13 BPM, AVG PRESS 3165#, 307 BBLs,

TOT SAND 12,000#, ISIP 2330#

Fill	0	5
Sand & Shale	5	20
Sand	20	30
RR	30	40
Sand & Shale	40	43
Coal	43	46
Sand & Shale	46	75
Sand	75	115
Sand & Shale	115	250
Sand	250	285
Sand & Shale	285	335
Sand	335	430
Sand & Shale	430	605
Sand	605	630
Sand & Shale	630	910
Sand	910	946
Sand & Shale	946	1071
Coal	1072	1080
Sand & shale	1080	1960
Salt Sand	1960	2060
Sand & shale	2060	2115
RR & Shale	2115	2150
Sand & shale	2150	2247

GAMMA RAY / FORMATION TOPS					
DEPI #6359		047-061-01485			
			TOP	BASE	
LITTLE LIME			2247	2284	
BIG LIME			2284	2362	
KEENER SAND			2362	2390	
BIG INJUN SAND			2390	2561	
50 FOOT			2980	3033	
30 FOOT			3093	3131	
GORDON SAND			3225 3237 ←	3225 3237	
5TH SAND			3341	3364	
BAYARD SAND			3405	3474	
LTD			3620		