

4706101577A

WW-7
8-30-06



West Virginia Department of Environmental Protection
Office of Oil and Gas

WELL LOCATION FORM: GPS

API: 47-061-01577 WELL NO.: SC-3A

FARM NAME: CNX GAS CO.

RESPONSIBLE PARTY NAME: WEST VIRGINIA LAND RESOURCES INC.

COUNTY: MONONGALIA DISTRICT: BATTELLE

QUADRANGLE: HUNDRED W.VA, PA

SURFACE OWNER: CNX GAS COMPANY LLC.

ROYALTY OWNER: _____

UTM GPS NORTHING: 4,389,876 m

UTM GPS EASTING: 552,095 m GPS ELEVATION: 425 m (1394')

RECEIVED
Office of Oil and Gas
JUN 09 2022
WV Department of
Environmental Protection

The Responsible Party named above has chosen to submit GPS coordinates in lieu of preparing a new well location plat for a plugging permit or assigned API number on the above well. The Office of Oil and Gas will not accept GPS coordinates that do not meet the following requirements:


1. Datum: NAD 1983, Zone: 17 North, Coordinate Units: meters, Altitude: height above mean sea level (MSL) – meters.
2. Accuracy to Datum – 3.05 meters
3. Data Collection Method:

Survey grade GPS : Post Processed Differential _____
Real-Time Differential

Mapping Grade GPS _____ : Post Processed Differential _____
Real-Time Differential _____


4. Letter size copy of the topography map showing the well location.

I the undersigned, hereby certify this data is correct to the best of my knowledge and belief and shows all the information required by law and the regulations issued and prescribed by the Office of Oil and Gas.

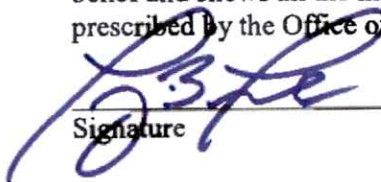
Signature

Professional Surveyor
Title

DECEMBER 18, 2021
Date

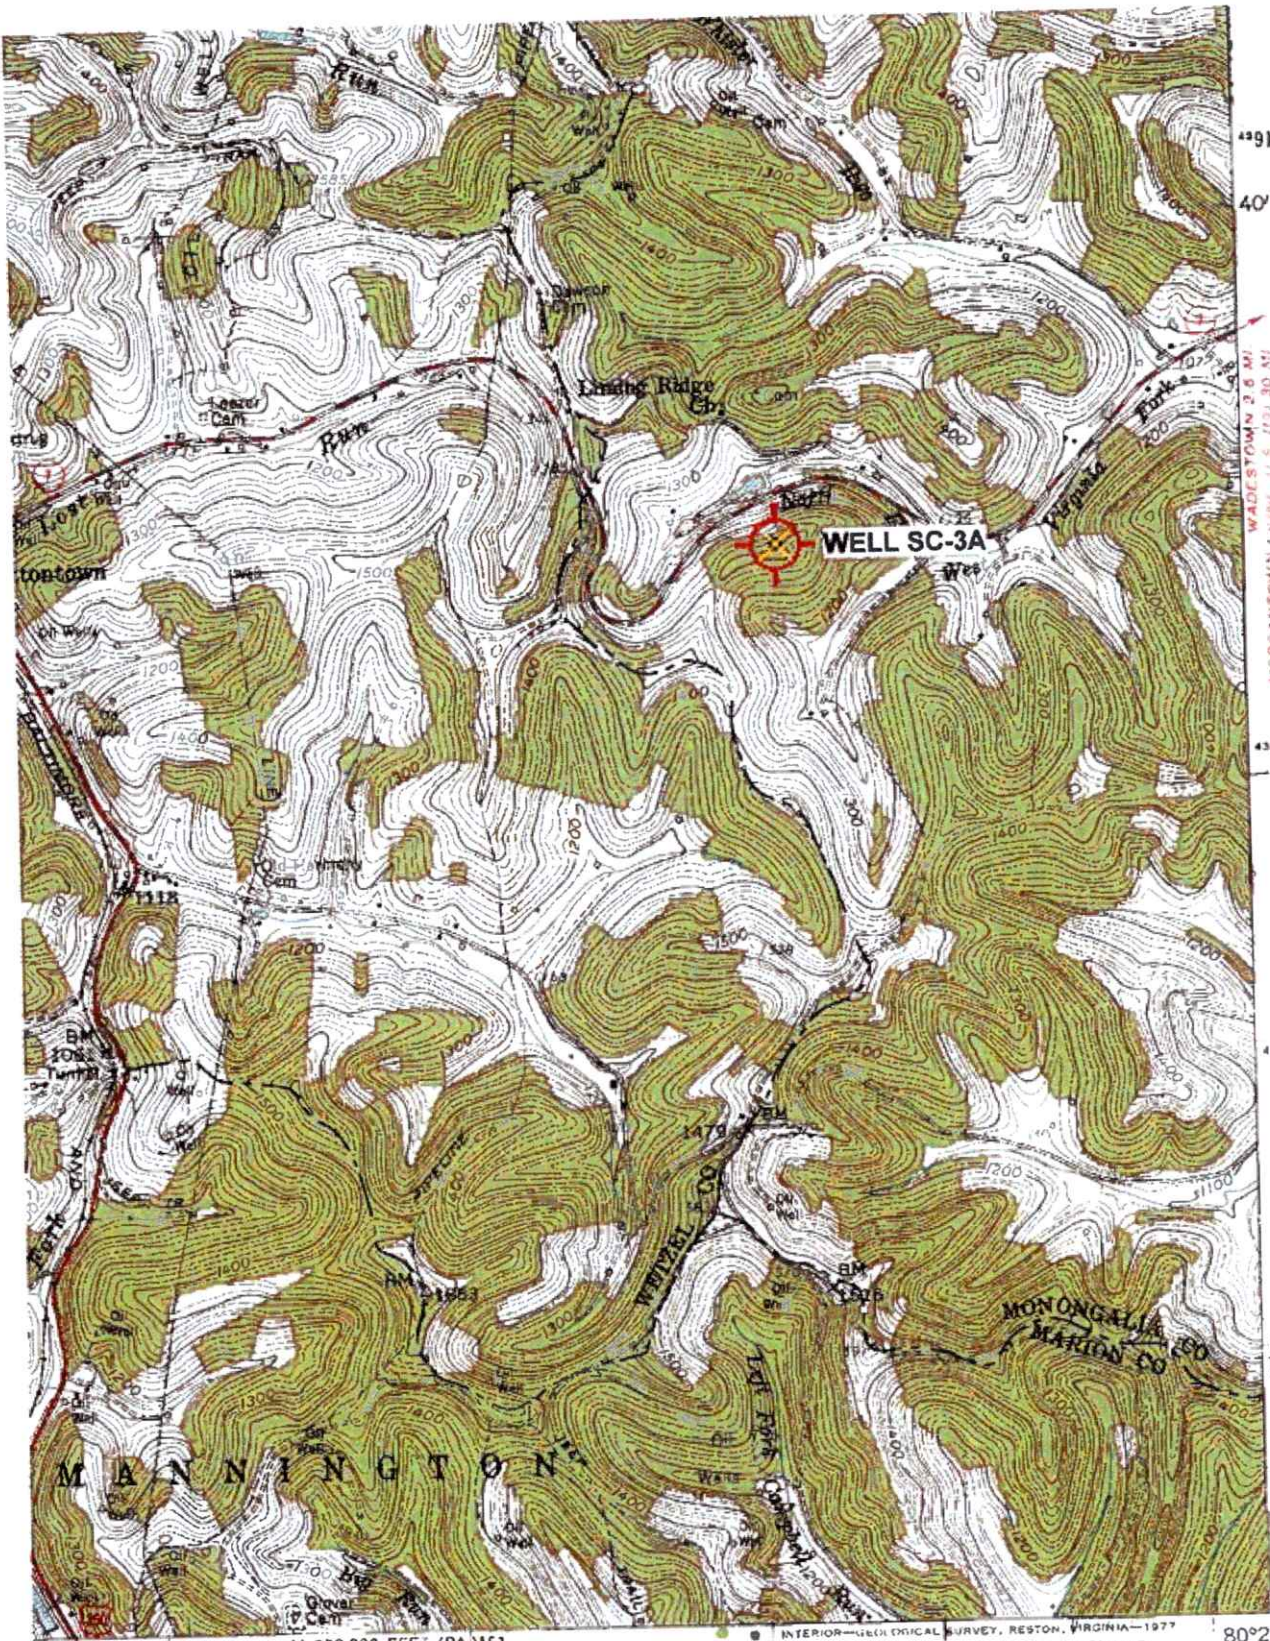

4391
40'
4389
4388000N
120 000 FEET (PA.)

RECEIVED
Office of Oil and Gas
JUN 09 2022
WV Department of
Environmental Protection
120 000 FEET (PA.)



ROAD CLASSIFICATION

Heavy duty		Light-duty	
Medium duty		Unimproved dirt	
		U. S. Route	
		State Route	

HUNDRED, W. VA.—PA.
NW/4 MANNINGTON 15' QUADRANGLE
N3937.5—W8022.5/7.5

(MANNINGTON)
4383 III SE