

4706101578P

WW-7
8-30-06



West Virginia Department of Environmental Protection
Office of Oil and Gas

WELL LOCATION FORM: GPS

API: 47-061-01578 WELL NO.: SC-3P

FARM NAME: CNX GAS CO.

RESPONSIBLE PARTY NAME: WEST VIRGINIA LAND RESOURCES INC.

COUNTY: MONONGALIA DISTRICT: BATTELLE

QUADRANGLE: HUNDRED W.VA, PA

SURFACE OWNER: CNX GAS COMPANY LLC.

ROYALTY OWNER: _____

UTM GPS NORTHING: 4,389,974 m (1276')

UTM GPS EASTING: 552,057 m GPS ELEVATION: 389 m

The Responsible Party named above has chosen to submit GPS coordinates in lieu of preparing a new well location plat for a plugging permit or assigned API number on the above well. The Office of Oil and Gas will not accept GPS coordinates that do not meet the following requirements:

1. Datum: NAD 1983, Zone: 17 North, Coordinate Units: meters, Altitude: height above mean sea level (MSL) – meters.
2. Accuracy to Datum – 3.05 meters
3. Data Collection Method:

Survey grade GPS : Post Processed Differential _____
Real-Time Differential

Mapping Grade GPS _____ : Post Processed Differential _____
Real-Time Differential _____

4. Letter size copy of the topography map showing the well location.

I the undersigned, hereby certify this data is correct to the best of my knowledge and belief and shows all the information required by law and the regulations issued and prescribed by the Office of Oil and Gas.

Signature


Professional Surveyor

Title

DECEMBER 18, 2021

Date

4706101578P

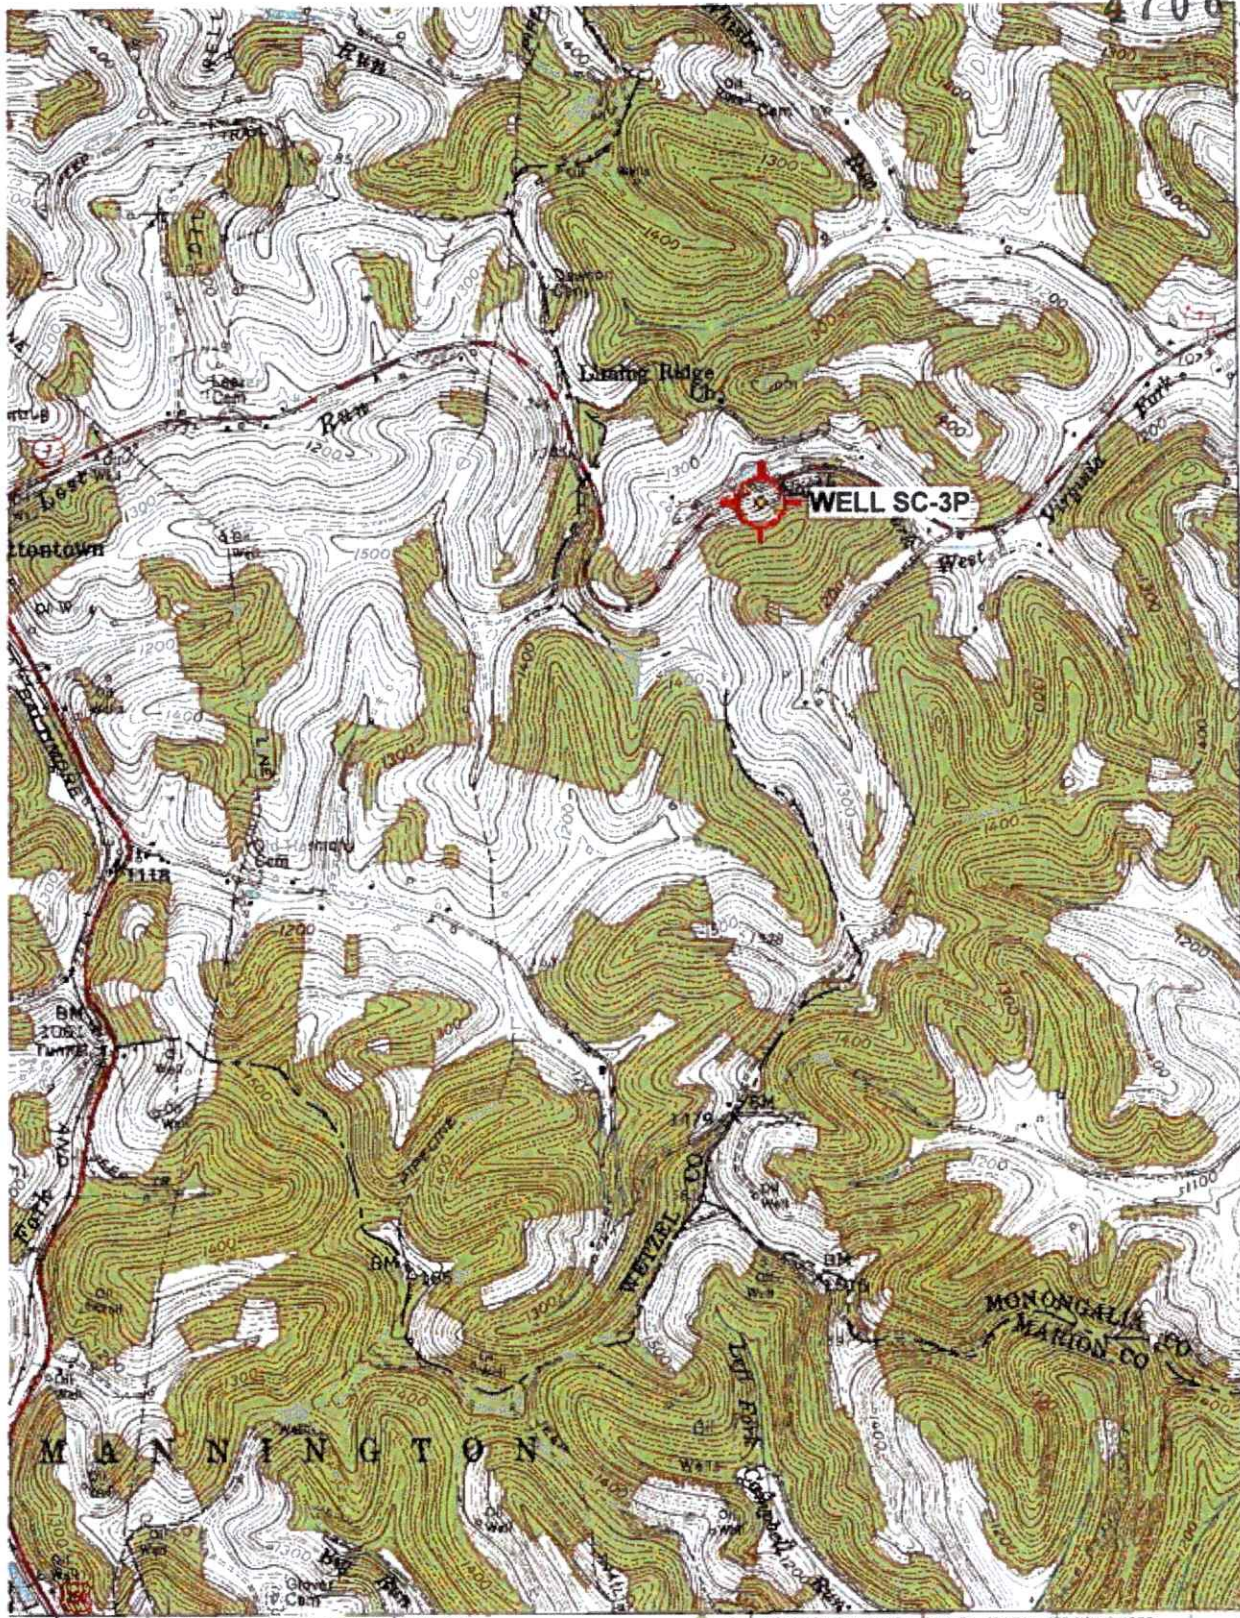

4391
40'
4389
120 000 FEET (PA.)

5 MI. 3 MI. 25' 1:250 000 FEET (PA.) 51

39°37'30" 80°22'30"



ROAD CLASSIFICATION

- Heavy duty ————
- Medium-duty ————
- Light-duty ————
- Unimproved dirt ————
- U. S. Route
- State Route



HUNDRED, W. VA.—PA.
NW/4 MANNINGTON 15' QUADRANGLE
N3937.5—W8022.5/7.5

(MANNINGTON)
483 III SE