

4706101616P

WW-7
8-30-06



West Virginia Department of Environmental Protection
Office of Oil and Gas

WELL LOCATION FORM: GPS

API: 47-061-01616 WELL NO.: ESTHER CLARK 1H

FARM NAME: ESTHER CLARK

RESPONSIBLE PARTY NAME: WEST VIRGINIA LAND RESOURCES INC.

COUNTY: MONONGALIA DISTRICT: BATTELLE

QUADRANGLE: HUNDRED W.VA, PA

SURFACE OWNER: ENVIRO CON LTD. (LIFE ESTHER H. CLARK)

ROYALTY OWNER: _____

UTM GPS NORTHING: 4,389,129 m

UTM GPS EASTING: 551,966 m GPS ELEVATION: 434 m (1424')

The Responsible Party named above has chosen to submit GPS coordinates in lieu of preparing a new well location plat for a plugging permit or assigned API number on the above well. The Office of Oil and Gas will not accept GPS coordinates that do not meet the following requirements:

- Datum: NAD 1983, Zone: 17 North, Coordinate Units: meters, Altitude: height above mean sea level (MSL) – meters.
- Accuracy to Datum – 3.05 meters
- Data Collection Method:

Survey grade GPS _____: Post Processed Differential _____

Real-Time Differential _____

Mapping Grade GPS : Post Processed Differential

Real-Time Differential _____

- Letter size copy of the topography map showing the well location.

I the undersigned, hereby certify this data is correct to the best of my knowledge and belief and shows all the information required by law and the regulations issued and prescribed by the Office of Oil and Gas.

Signature

[Signature]
Professional Surveyor

Title

JUNE 10, 2022

Date

RECEIVED
Office of Oil and Gas

JUN 21 2022


WV Department of
Environmental Protection

07/08/2022

Well# 1H

HUNDRED WV-PA 7.5' Quad

Scale: 1" = 2000'

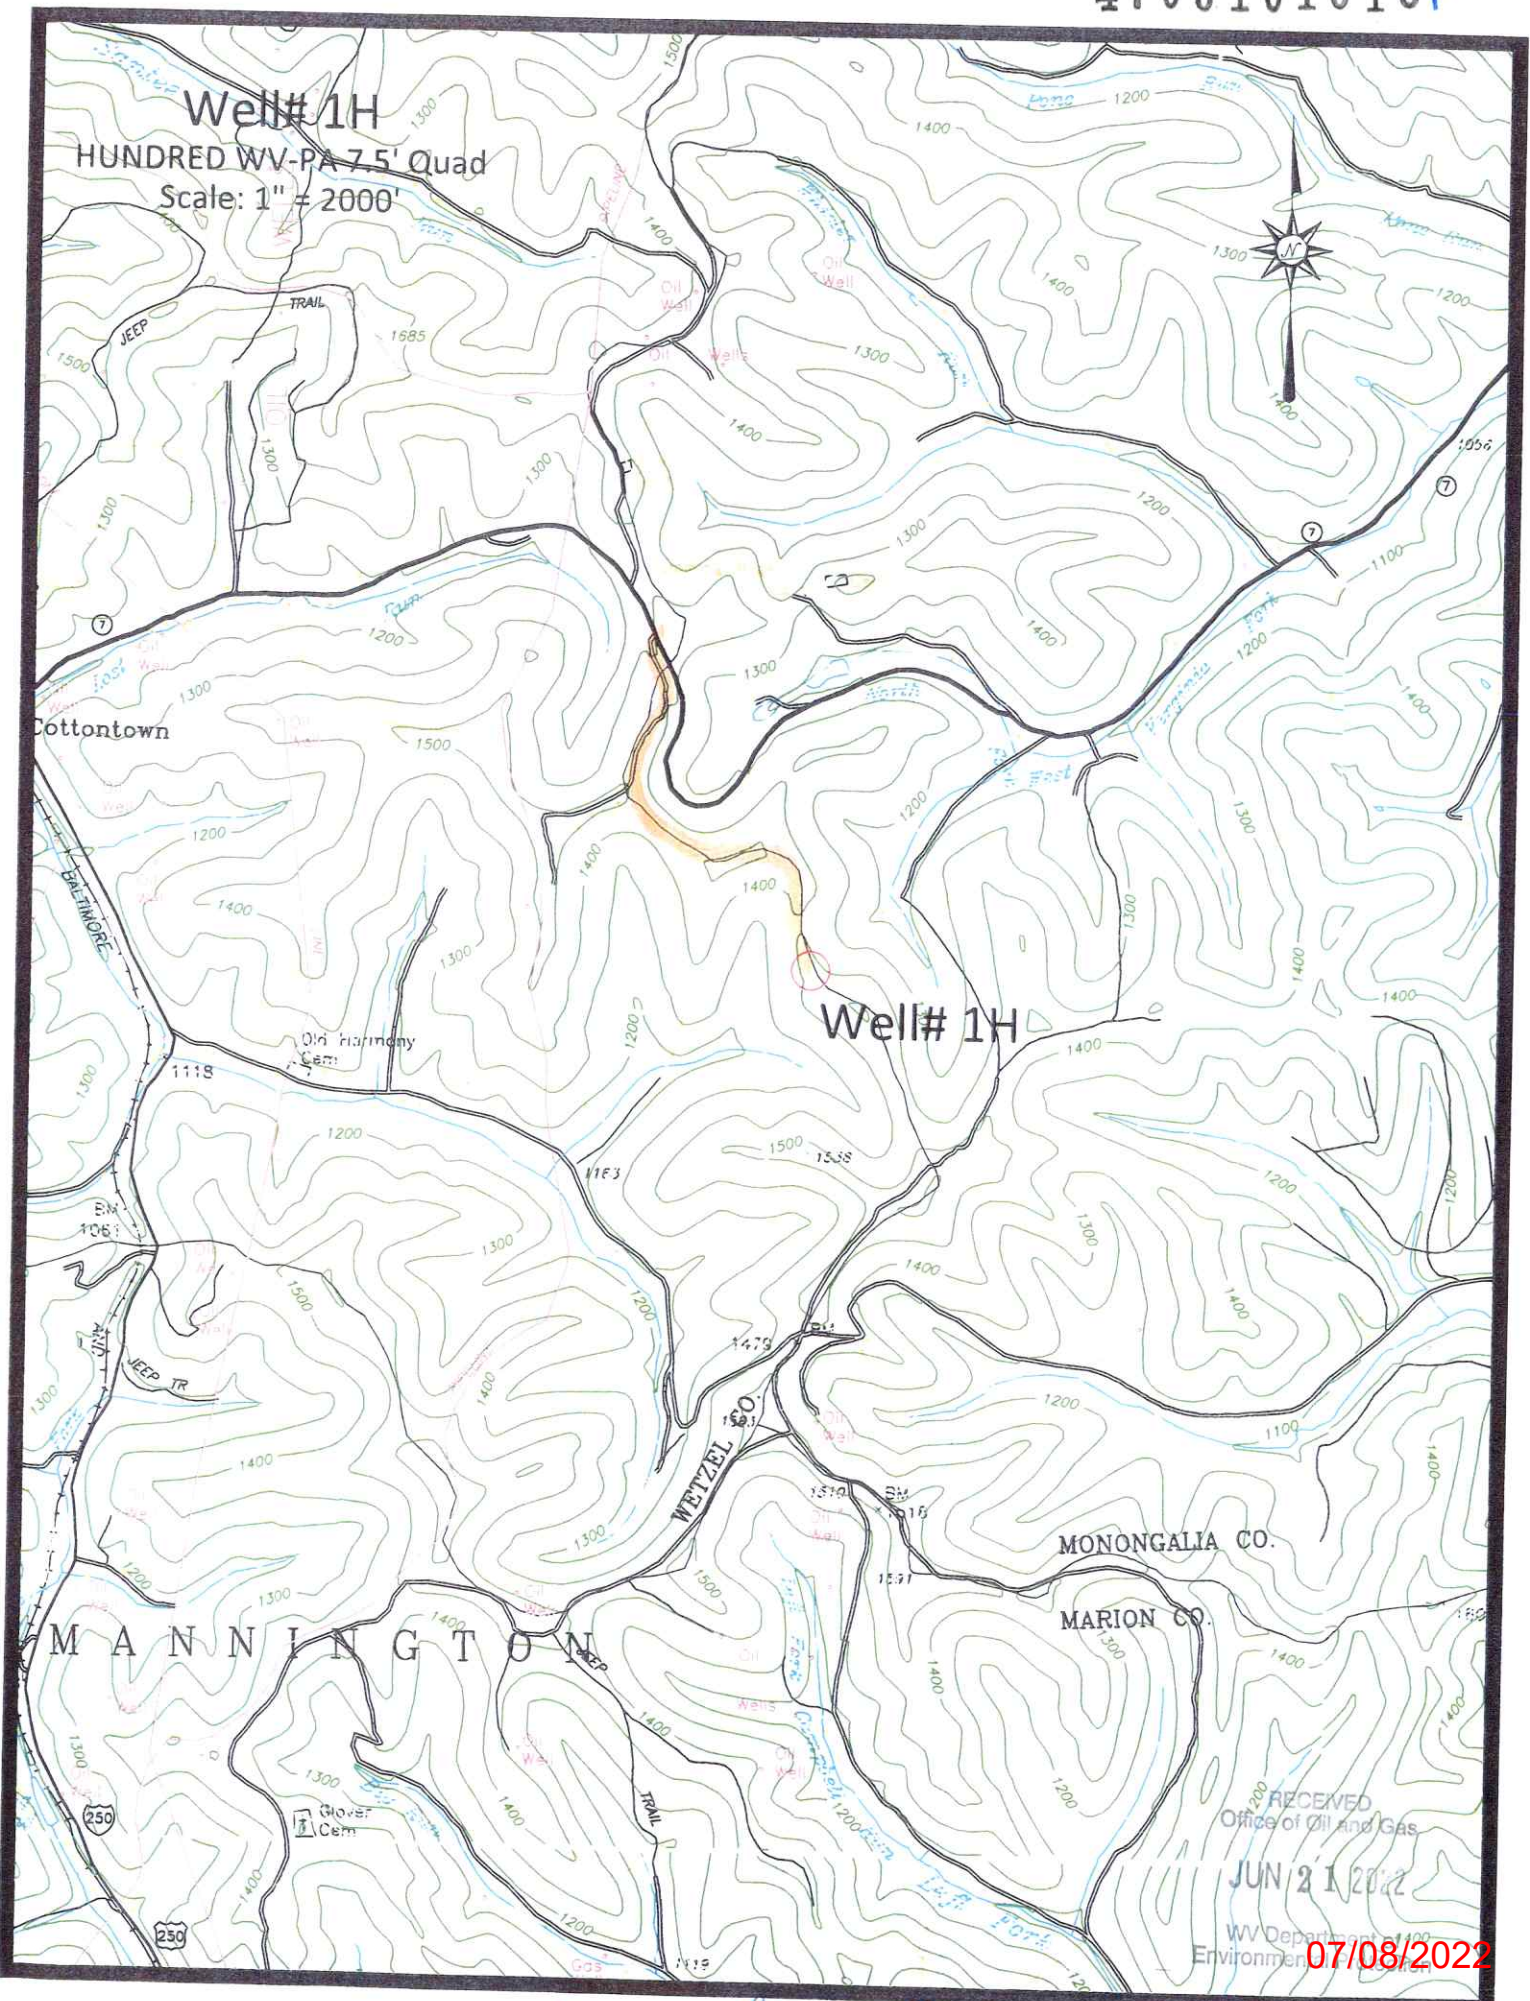

Well# 1H

MANNINGTON

MONONGALIA CO.

MARION CO.

RECEIVED
Office of Oil and Gas

JUN 21 2022

WV Department of
Environment & Natural Resources
07/08/2022

H. 101616P